
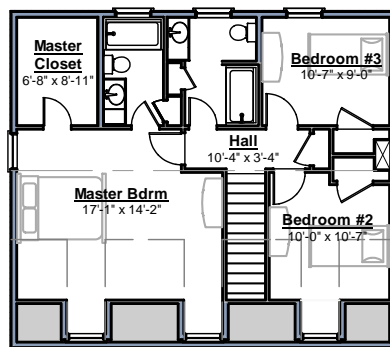


# Teddy Cape

208.001 © 2010 Wendy Welton

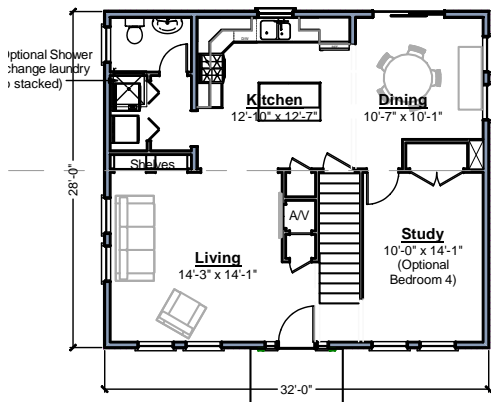


	As Shown	Optional	Total
First Floor	896		896
Second Floor	816		816
Third Floor/Attic			
Total Above Grade	1712		1712
Bedrooms	3	1	4
Bathroom	2 1/2	1	3 1/2

Artform Home Plans assumes no responsibility for information in this box, which is provided by Builder and/or RE Agent.

(printed 4/12/2010)


# Teddy Cape

208.001 © 2010 Wendy Welton

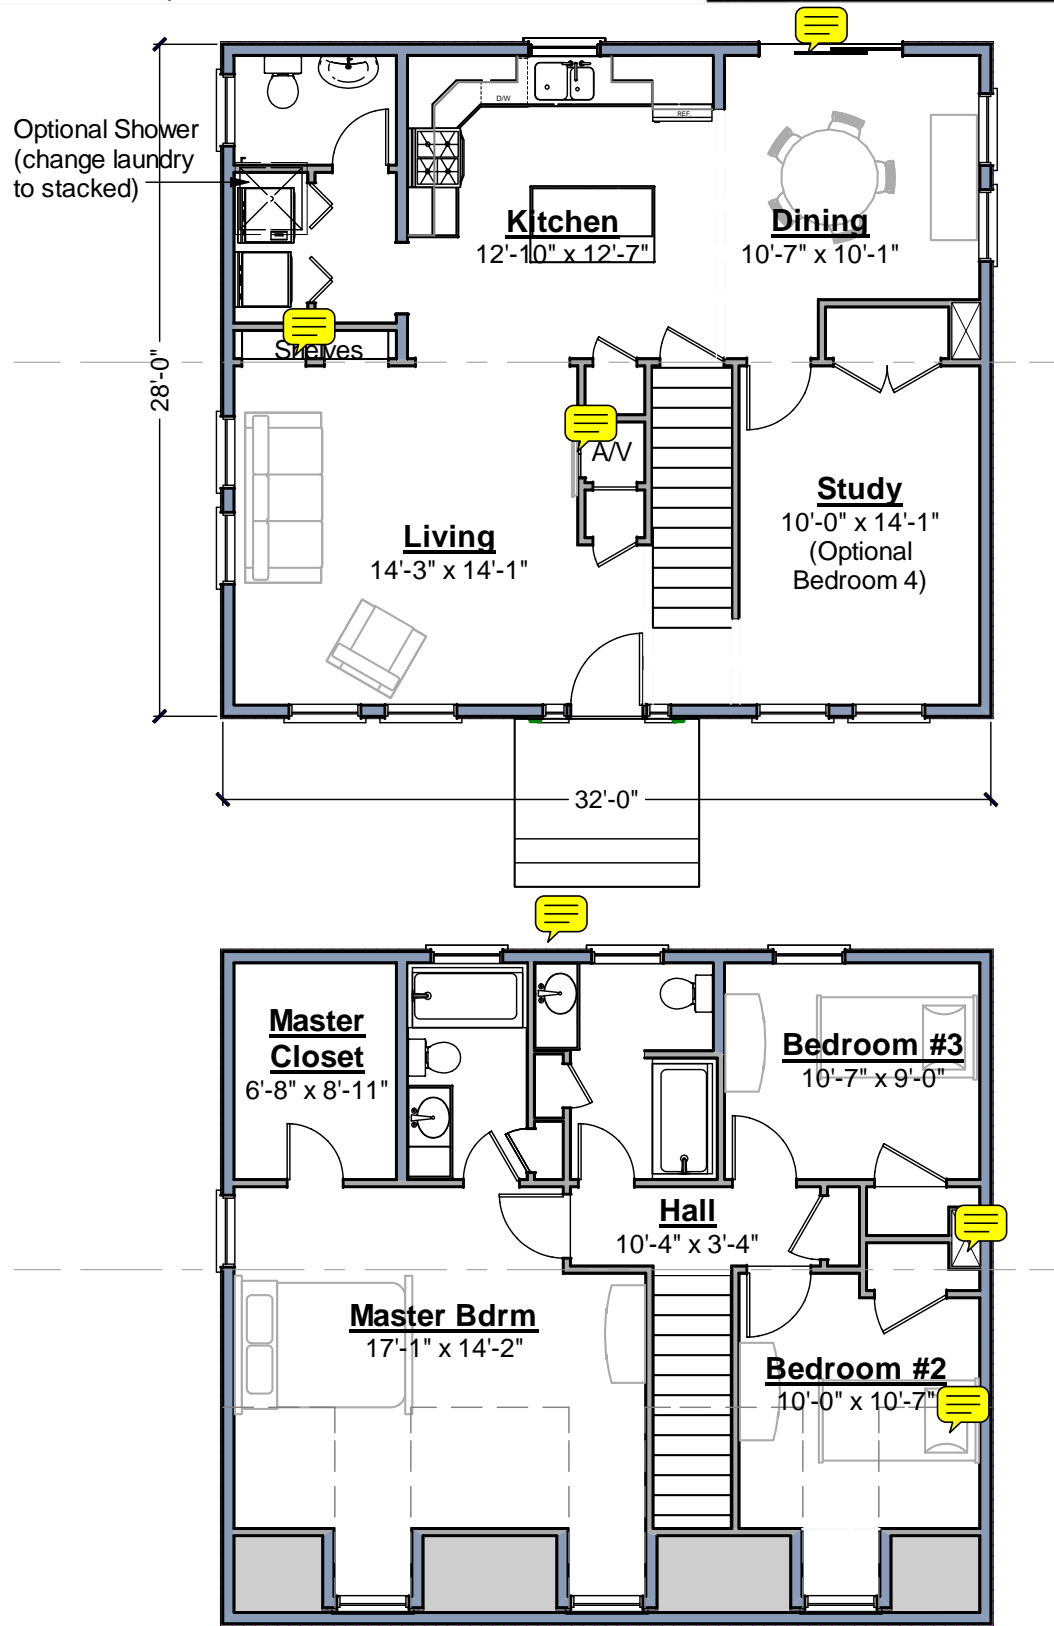

# Teddy Cape

208.001 © 2010 Wendy Welton

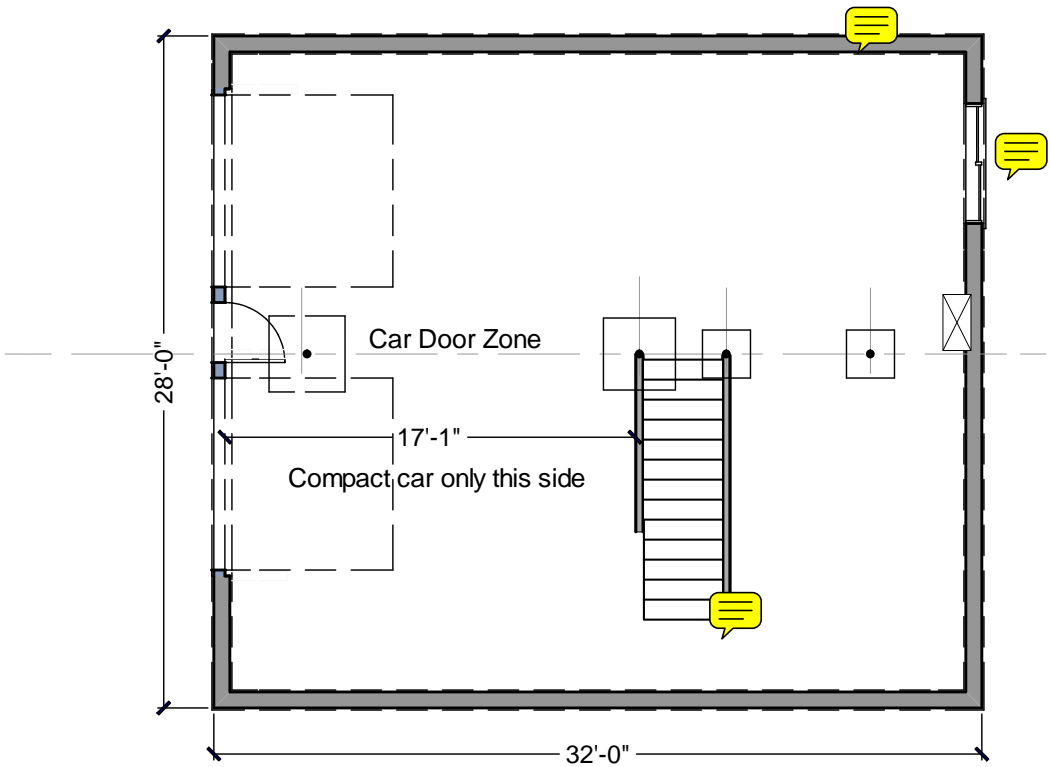

# Teddy Cape

208.001 © 2010 Wendy Welton



# Teddy Cape

208.001 © 2010 Wendy Welton

