

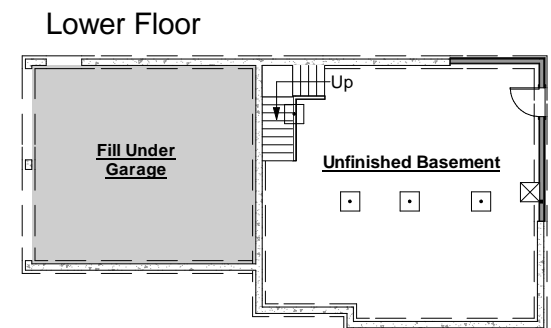


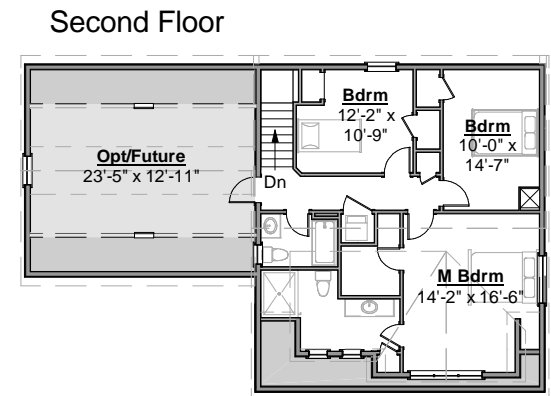

© 2010-2013 Wendy Welton
Brandywine Silver

Artform Home Plans

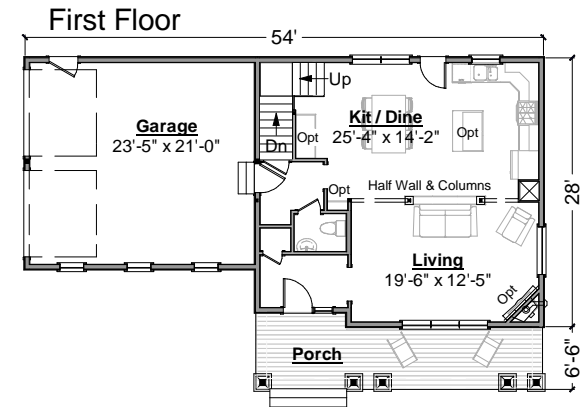

Brandywine Silver

534.001 © 2008-2013 Wendy Welton, all rights reserved. You may not build this design without purchasing a license, even if you make changes. This design may have geographic restrictions. Contact the Builder or RE Agent at left or call Artform Home Plans at 603-431-9559

	Base Above Grade	Opt/ Future	Total
Living Area	1753	334	2087
Bedroom	3	1	4
Baths	2.5		2.5

Some items optional or designer's vision. Builder's written specifications always govern. Dimensions supercede Square Foot data.

Brandywine Silver

534.001


© 2008-2013 Wendy Welton, all rights reserved. You may not build this design without purchasing a license, even with changes. Some Artform designs have geographic restrictions. Contact the Builder or RE Agent or call Artform at 603-431-9559



Some items shown are optional and/or may vary. Builder's written specifications always govern.

1. Gas fireplace and it's surround or mantel
2. Kitchen - island, cabinet style & trim, countertop material, etc.
3. Door styles and trim
4. Window grilles and trim, window treatments
5. Stair balusters or low walls at stairs
6. Lighting
7. Material selections (flooring, siding, roofing, paint colors, etc.)
8. Other furnishings
9. Landscaping, paving and walkways
10. Gutters, shutters and other exterior trim components
11. Deck – size, railing style, stair location, etc.
12. Amount of exposed basement and/or wood framed walls at basement.

These images are not of any specific building site. Sun and view through windows will vary, as will the site around the house on the exterior and the slope of the land.

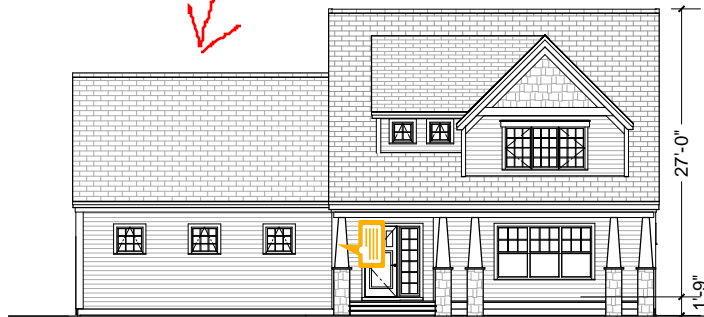


Brandywine Silver

534.001

© 2008-2013 Wendy Welton, all rights reserved. You may not build this design without purchasing a license, even with changes. Some Artform designs have geographic restrictions. Contact the Builder or RE Agent or call Artform at 603-431-9559



First Floor

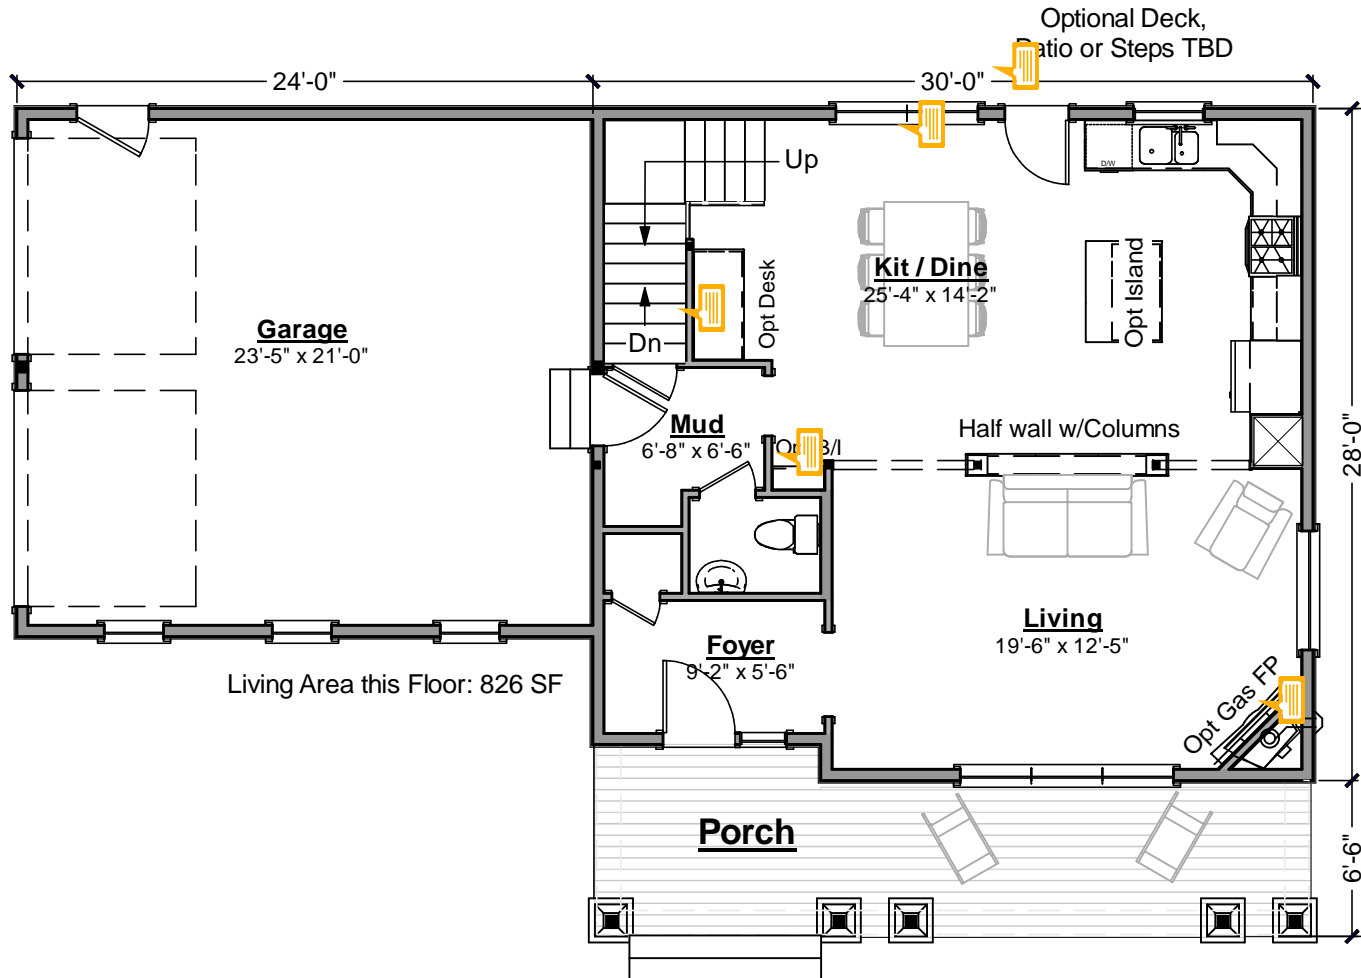


Brandywine Silver

534.001

© 2008-2013 Wendy Welton, all rights reserved. You may not build this design without purchasing a license, even with changes. Some Artform designs have geographic restrictions. Contact the Builder or RE Agent or call Artform at 603-431-9559



Second Floor

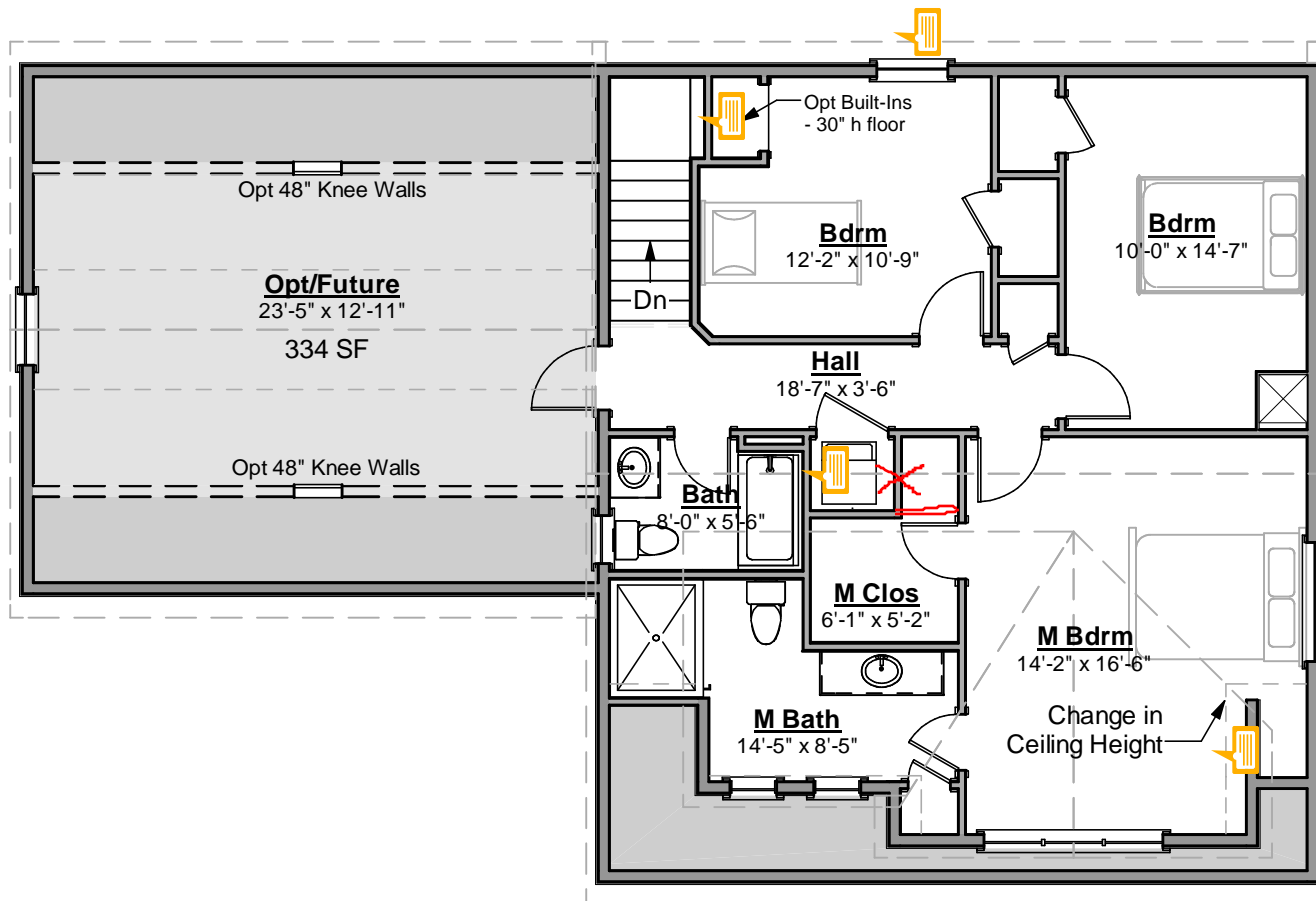

Living Area this Floor: 927 SF

Brandywine Silver

534.001

© 2008-2013 Wendy Welton, all rights reserved. You may not build this design without purchasing a license, even with changes. Some Artform designs have geographic restrictions. Contact the Builder or RE Agent or call Artform at 603-431-9559



Lower Level

