

114.000 Merry Lee

Some features shown are optional. Your contract with your builder governs.

First Floor

Living Area: 758 SF

Beds: 1


Baths: 1.0

Ceiling Height Shown: 8'-0"

Ceiling Height Possible*: 8'-0"

* -- See Major Changes on pricing tab of plan page for cost.

- ADD 3' in Length
- ADD 2' IN width
- the 2' doesn't need to only be on garage side. (2' overall)
- move bedroom to back of garage Area
- Turn bedroom into dining Room
- Add Gas Fireplace
- Add MAN DOOR TO SIDE OF GARAGE

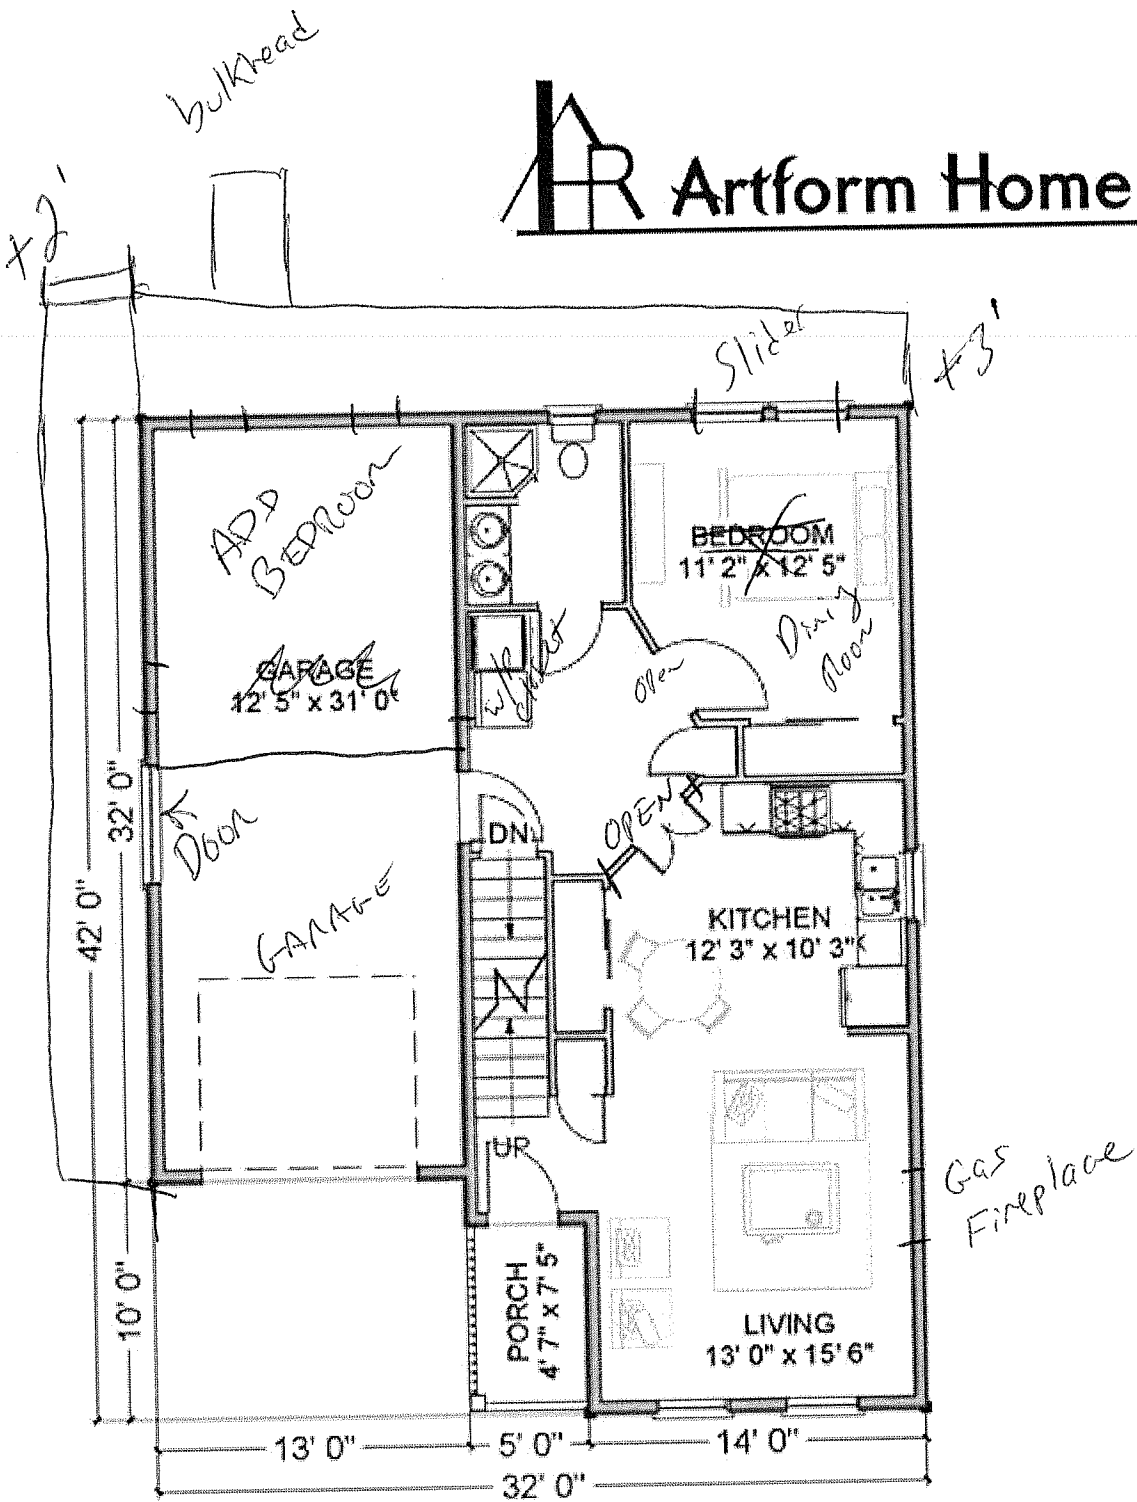

Merry Lee - First Floor
© 2008 Wendy Lee Welton

Artform Home Plans

114.000 Merry Lee

Some features shown are optional. Your contract with your builder governs.

Second Floor

Living Area: 680 SF

Beds: 2


Baths: 1.0

Ceiling Height Shown: 8'-0"

Ceiling Height Possible*: 8'-0"

* -- See Major Changes on pricing tab of plan page for cost.

• ADD BEDROOM to
study / BATH location
• move bath to Future
location

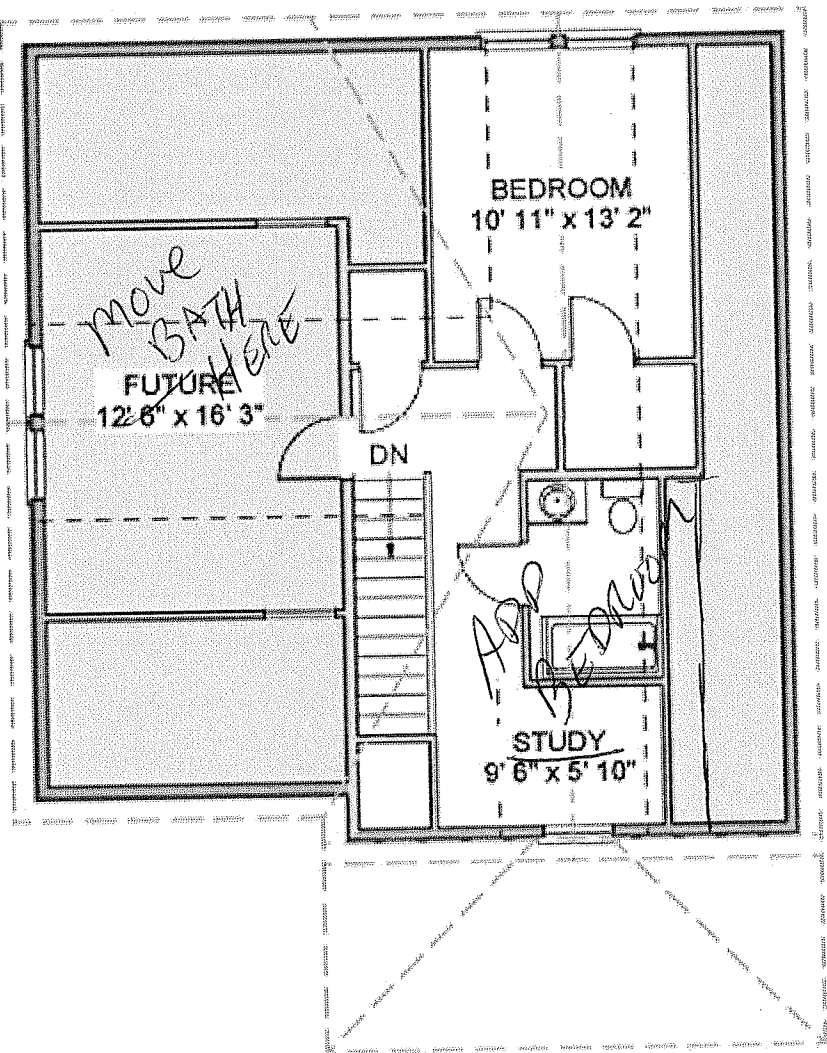

Merry Lee - Second Floor
© 2008 Wendy Lee Welton

Artform Home Plans