


11/13/2014

MARK'S
HOUSE

~~NOT~~ BUILD THIS WHOLE

KEEPING ROOM
FP & 2 CH

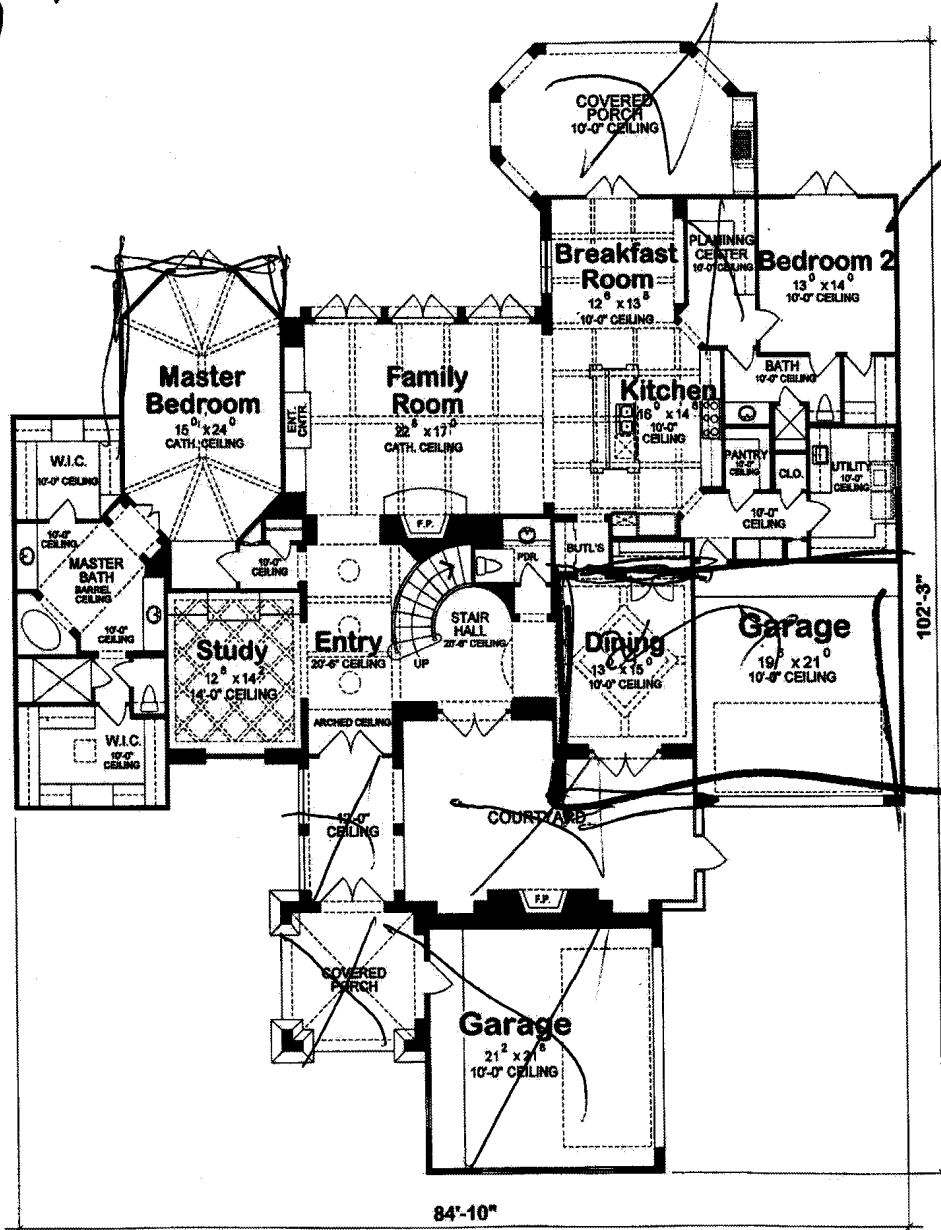

2 POC

3 UP
5 TOTAL
FLAT 107

3 CAR
B

AND
GAMBREL

