


603.444.4959


866-

WINDOWS FOR 1/2 BATH WITH PEDSTOOL SINK
AND LAUNDRY

First Floor Plan

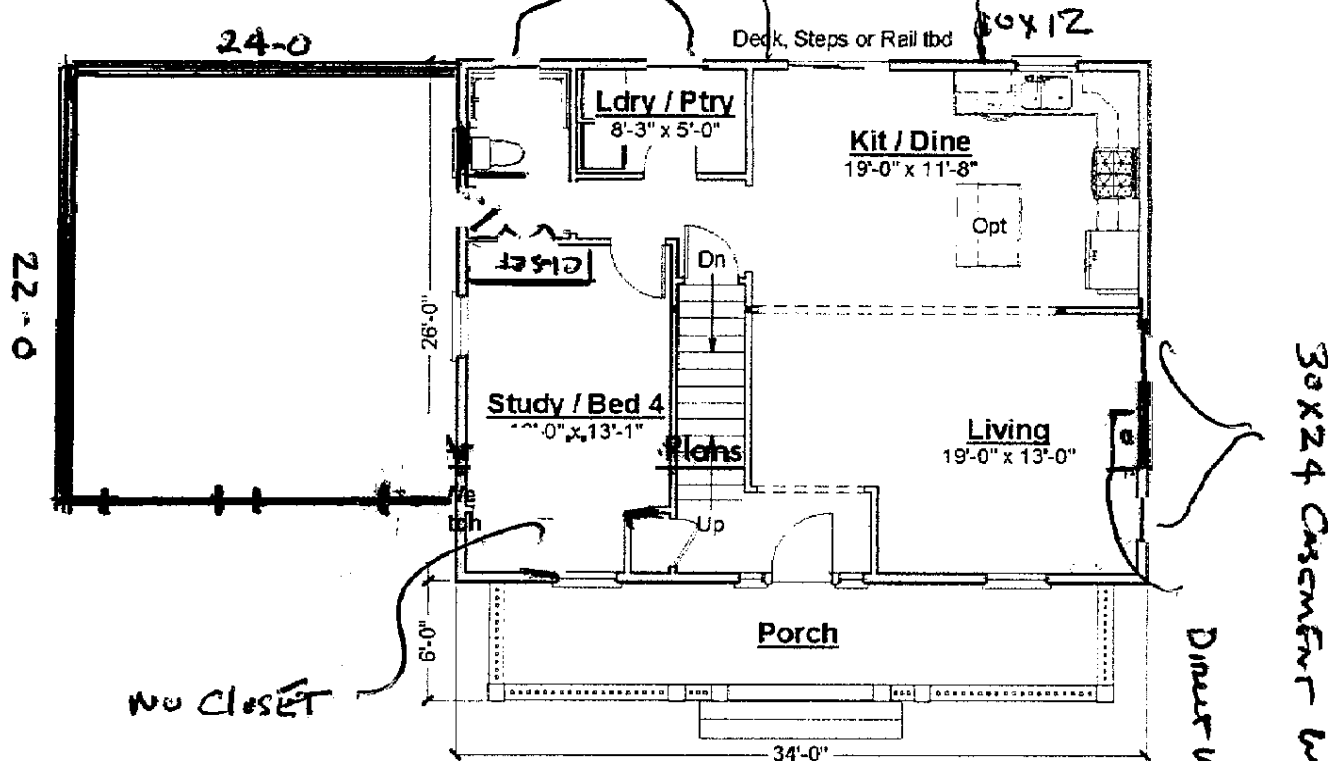

Second Floor Plan

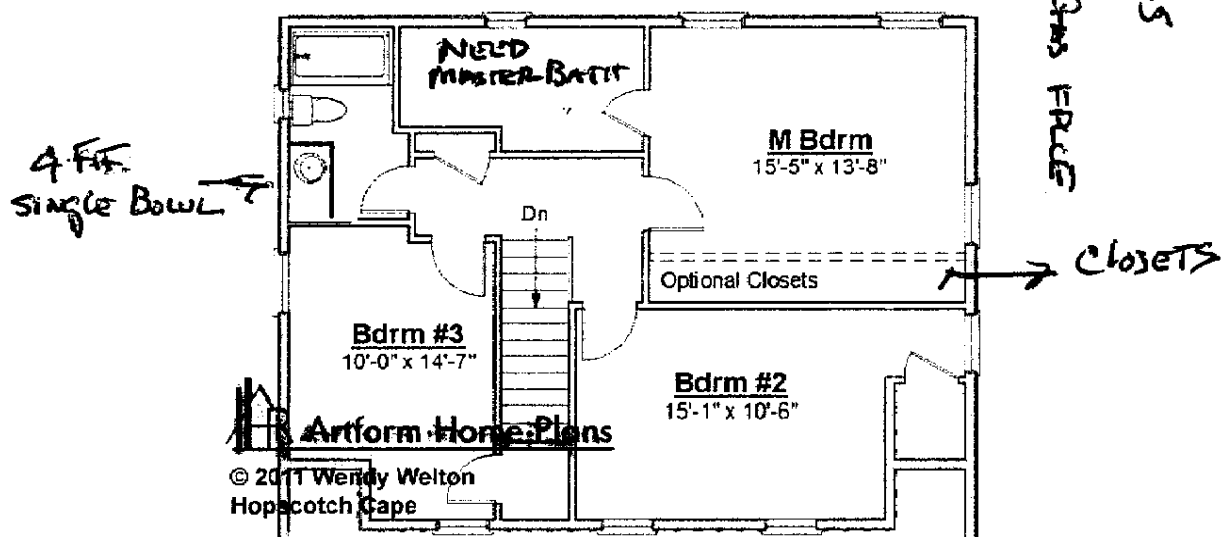

6614 -

I DO NEED TO MINIMUM INCREASE THIS PLAN
SO GARAGE ON RT. SIDE.

PLEASE CALL OUT JELD-WEN $\frac{6}{1}$ WITH 3 1/2" FLAT
CASINGS.

THANKS, Bill

207.650.0766

WCLARK@LEMANUE.RE.COM