

Artform Home Plans

	Area	Beds	Baths
Main	1008 SF	0	0.5
Future	0 SF	1	0
Apt	0 SF	0	0
Total	1008 SF	1	0.5


Shown 9'-0"

Possible* 8'-0"



Hand-drawn Floor Plan Details:

- Garage:** Nominal 26' x 24'. Includes note: "Boxed Beam Above".
- Living Area:** 21'-0" x 15'-2". Includes note: "Boxed Beam Above".
- Kitchen / Dine:** 23'-4" x 11'-10". Includes note: "Opt Island".
- Study / Bdrm:** 10'-4" x 12'-8".
- Mudroom:** Labeled "Mud".
- Powdr:** Powder room.
- Ptry:** Entry.
- Porch:** 8' Porch. Includes note: "36' x 8' Front Porch 6'-8'".
- Deck:** 12'-0" x 12'-0". Includes note: "NO Deck".
- Drop Foundation:** 40" and 6'.
- Full Chase w/ Foundation:** Indicated on the right side.
- Handwritten Notes:**
 - "NO Pocket Doors" (top left)
 - "New Mudroom 1/2 Bath Pantry" (top center)
 - "V19 Kitchen" (circled, right side)
 - "25" (large red 'X' mark, right side)
 - "one Door" (bottom left)
 - "2-steps off porch" (bottom left)
 - "open Both sides" (bottom center)
- Dimensions:**
 - Overall width: 62'-0"
 - Overall depth: 34'-3"
 - Garage width: 26'-0"
 - Living area width: 24'
 - Deck width: 12'-0"
 - Porch width: 36'-0"
- Other Labels:** "Butterscotch", "Artform Home Plans", "©2011-2018 Art Form Architecture", "Living Area this Floor: 1008 sq ft", "9 ft Ceilings", "Up", "Down", "CHIPP".

You may not build this Design without purchasing a License to Build (as defined in our Terms). Unauthorized changes are not permitted and violate copyright laws, which provide substantial penalties for infringement.

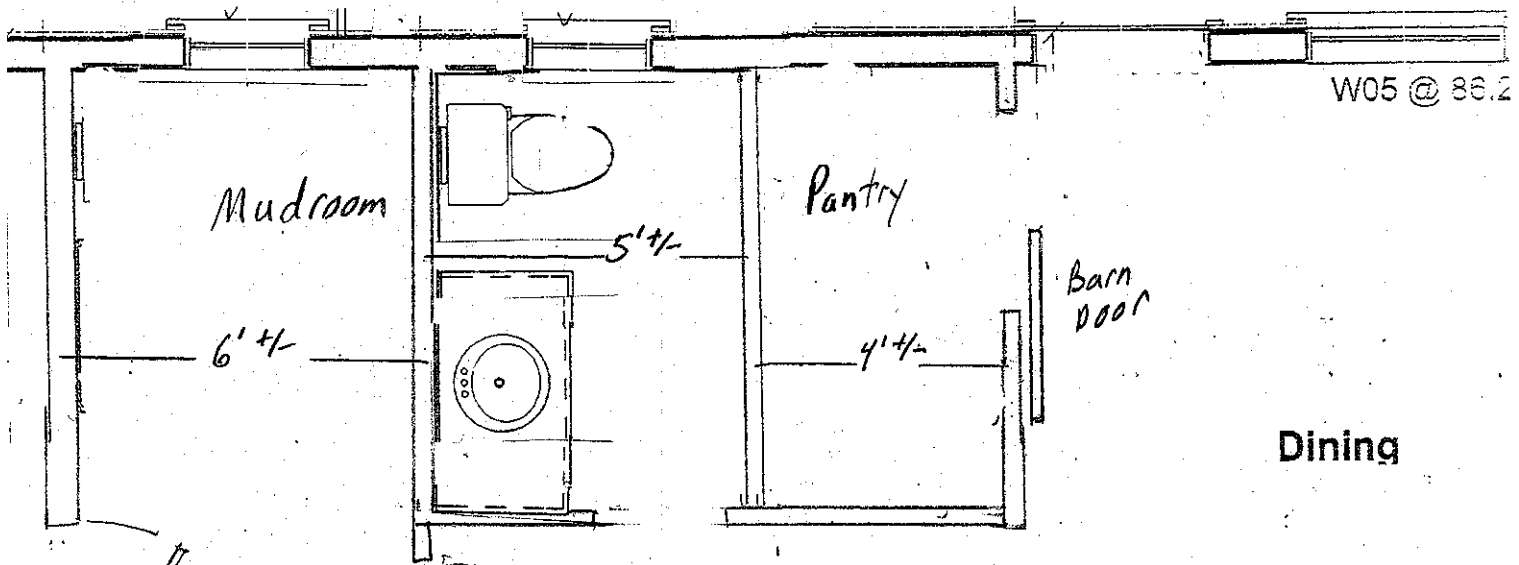

Dining

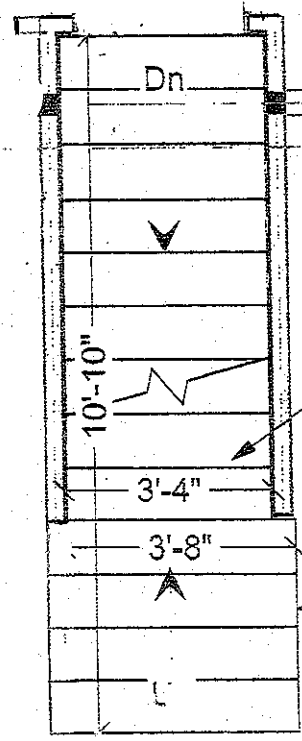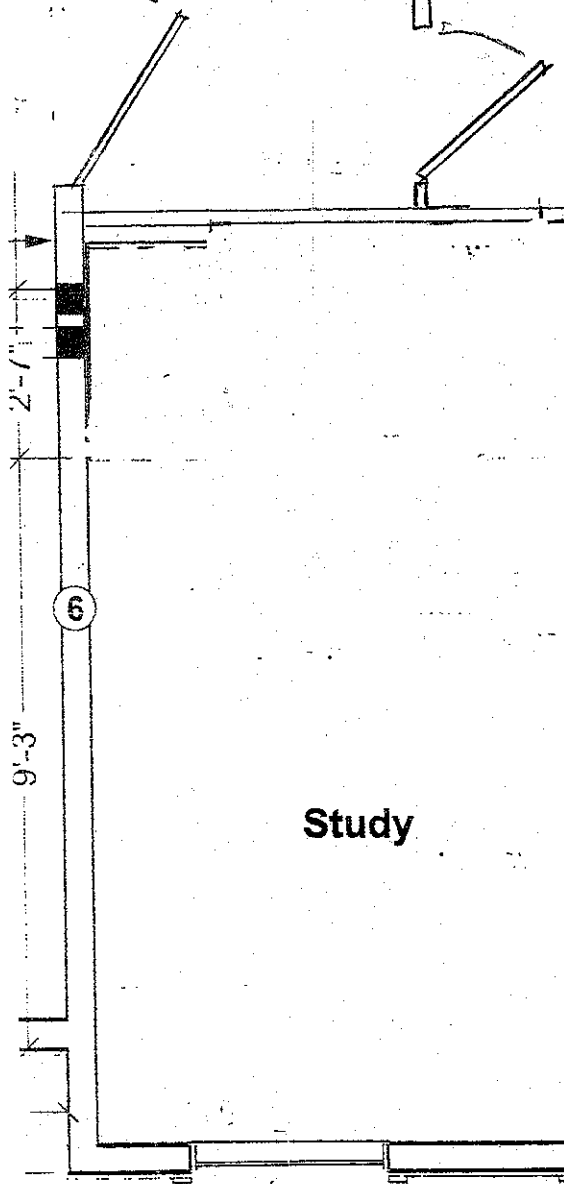

Line of Boxed Beam

Dark square Indicates

Trimmed openings are not and sizes are approximate and/or balance trim with e:

STAIRS UP TO 2ND FLOOR
14 Equal Risers @ 7 3/8" +/-
13 Treads @ 10" each, as measured nose to nose

Sloped low wall this section (approx 4 treads) follow angle of stairs.

430.124.v15 KR Butterscotch Classic, 36x28




Second Floor

	Area	Beds	Baths
Main	1528 SF	4	2
Future	0 SF	0	0
Apt	0 SF	0	0
Total	1528 SF	4	2

Ceiling Height
Shown 8'-0"
Possible* 8'-0"

* See Major Change information on plan page for cost

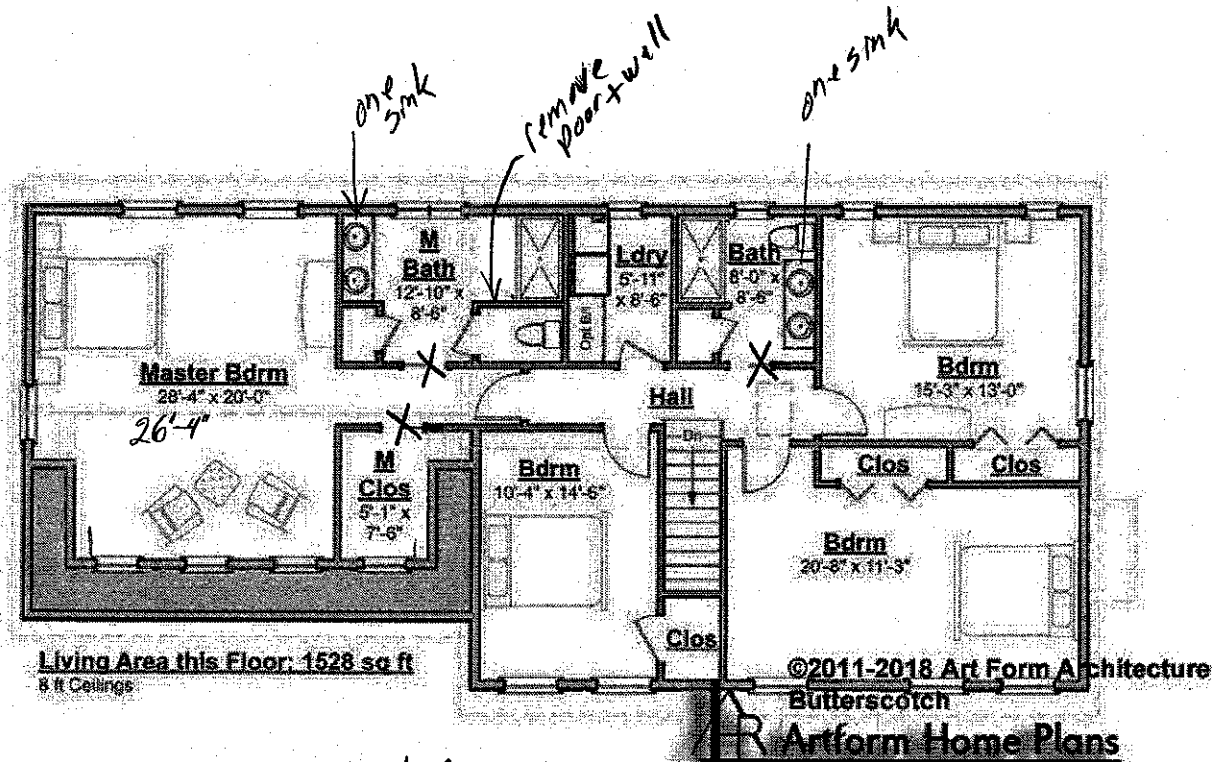

NO pocket Doors
NO Bifold Doors

Use of this document is governed by our **Terms and Conditions**, found on our website:
<http://www.artformhomeplans.com/TermsConditions.a5w>

© 2011 Art Form Architecture, Inc. ALL RIGHTS RESERVED.
You may not build this Design without purchasing a License to Build (as defined in our Terms). Unauthorized changes are not permitted and violate copyright laws, which provide substantial penalties for infringement.

Some features show are optional. Your Purchase & Sale Agreement governs, whether items are labeled "optional" in this document or not.

We are not responsible for typographical errors.

430.124.v15 KR Butterscotch Classic, 36x28



Basement Floor


	Area	Beds	Baths
Main	0 SF	0	0
Future	0 SF	0	0
Apt	0 SF	0	0
Total	0 SF	0	0

Ceiling Height

Shown 7'-8"

Possible* 9'-0"

* See Major Change information on plan page for cost

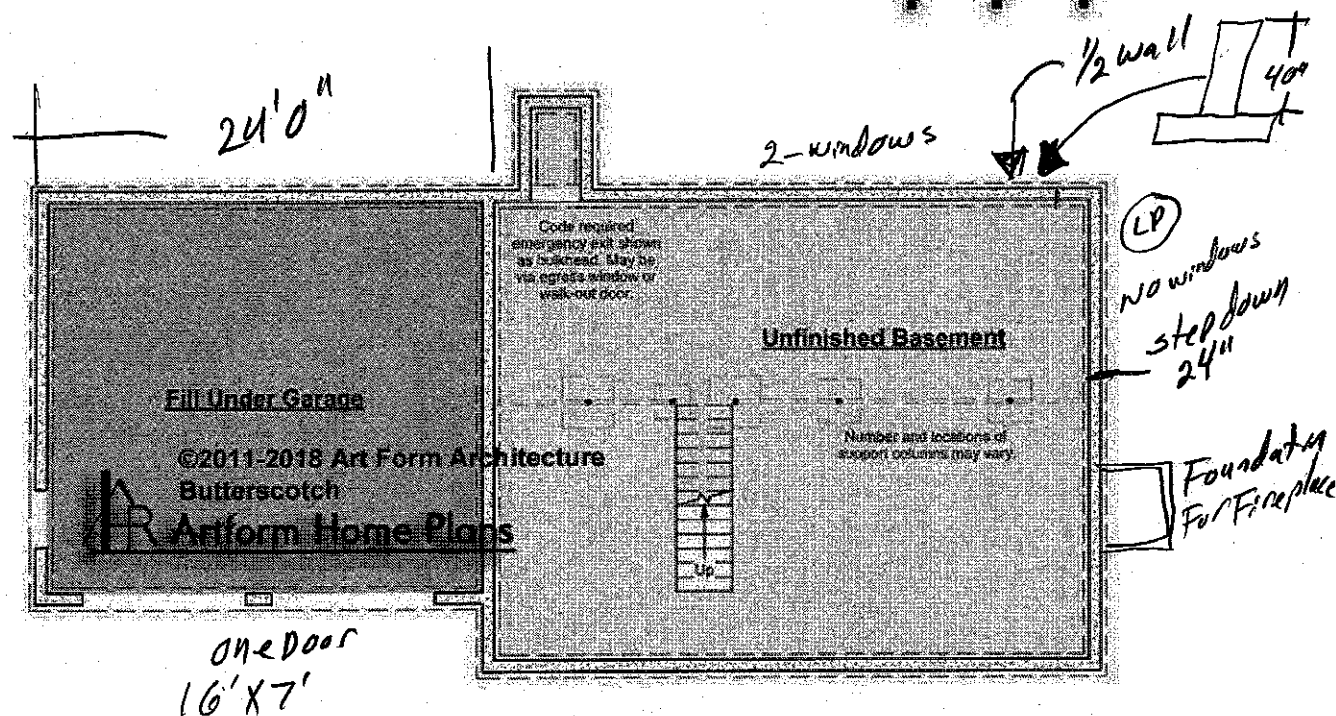

Use of this document is governed by our **Terms and Conditions**, found on our website:
<http://www.artformhomeplans.com/TermsConditions.a5w>

© 2011 Art Form Architecture, Inc. ALL RIGHTS RESERVED.
You may not build this Design without purchasing a License to Build (as defined in our Terms). Unauthorized changes are not permitted and violate copyright laws, which provide substantial penalties for infringement.

Some features shown are optional. Your Purchase & Sale Agreement governs, whether items are labeled "optional" in this document or not.

We are not responsible for typographical errors.

430.124.v15 KR Butterscotch Classic, 36x28



Front Elevation



Use of this document is governed by our **Terms and Conditions**, found on our website:
<http://www.artformhomeplans.com/TermsConditions.a5w>

© 2011 Art Form Architecture, Inc. ALL RIGHTS RESERVED.
You may not build this Design without purchasing a License to Build (as defined in our Terms). Unauthorized changes are not permitted and violate copyright laws, which provide substantial penalties for infringement.


Some features show are optional. Your Purchase & Sale Agreement governs, whether items are labeled "optional" in this document or not.

We are not responsible for typographical errors.

430.124.v15 KR Butterscotch Classic, 36x28



Right Elevation

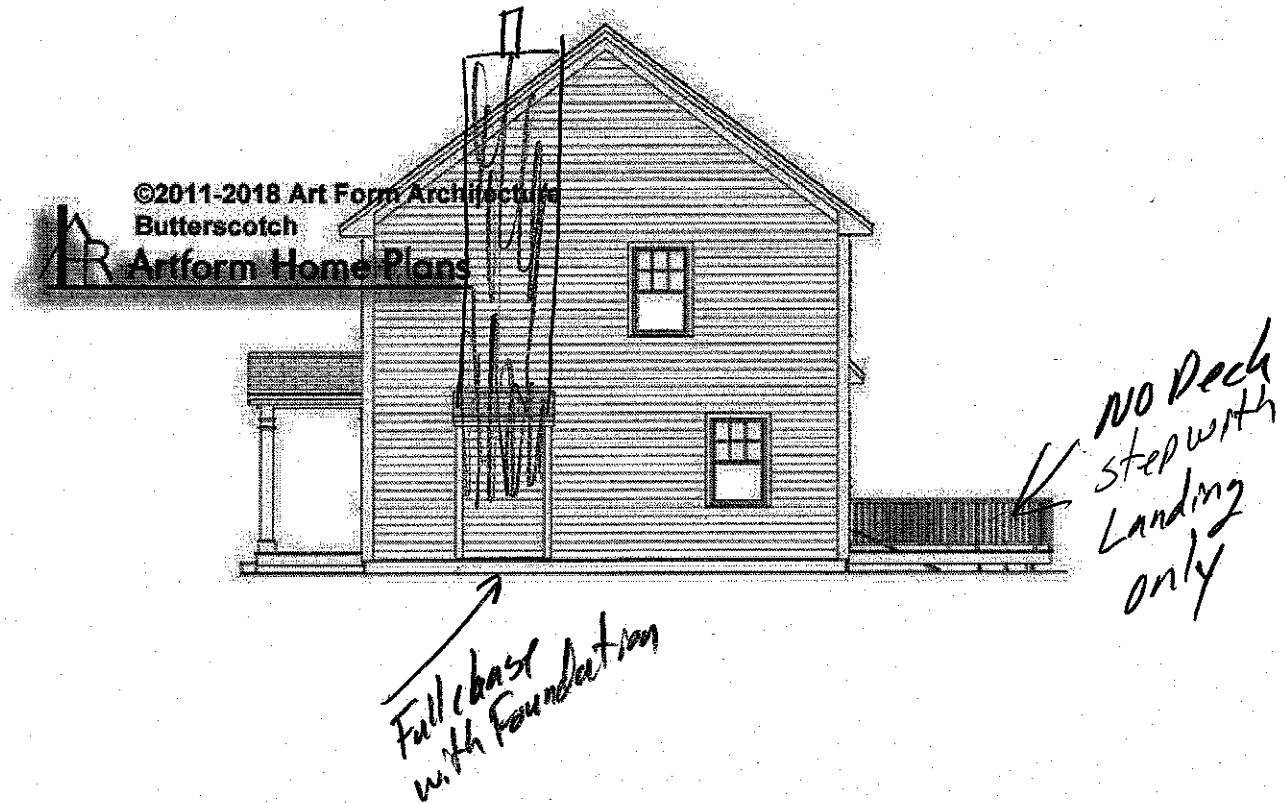

Use of this document is governed by our **Terms and Conditions**, found on our website:
<http://www.artformhomeplans.com/TermsConditions.a5w>

© 2011 Art Form Architecture, Inc. ALL RIGHTS RESERVED.
You may not build this Design without purchasing a License to Build (as defined in our Terms). Unauthorized changes are not permitted and violate copyright laws, which provide substantial penalties for infringement.


Some features show are optional. Your Purchase & Sale Agreement governs, whether items are labeled "optional" in this document or not.

We are not responsible for typographical errors.

430.124.v15 KR Butterscotch Classic, 36x28



Rear Elevation

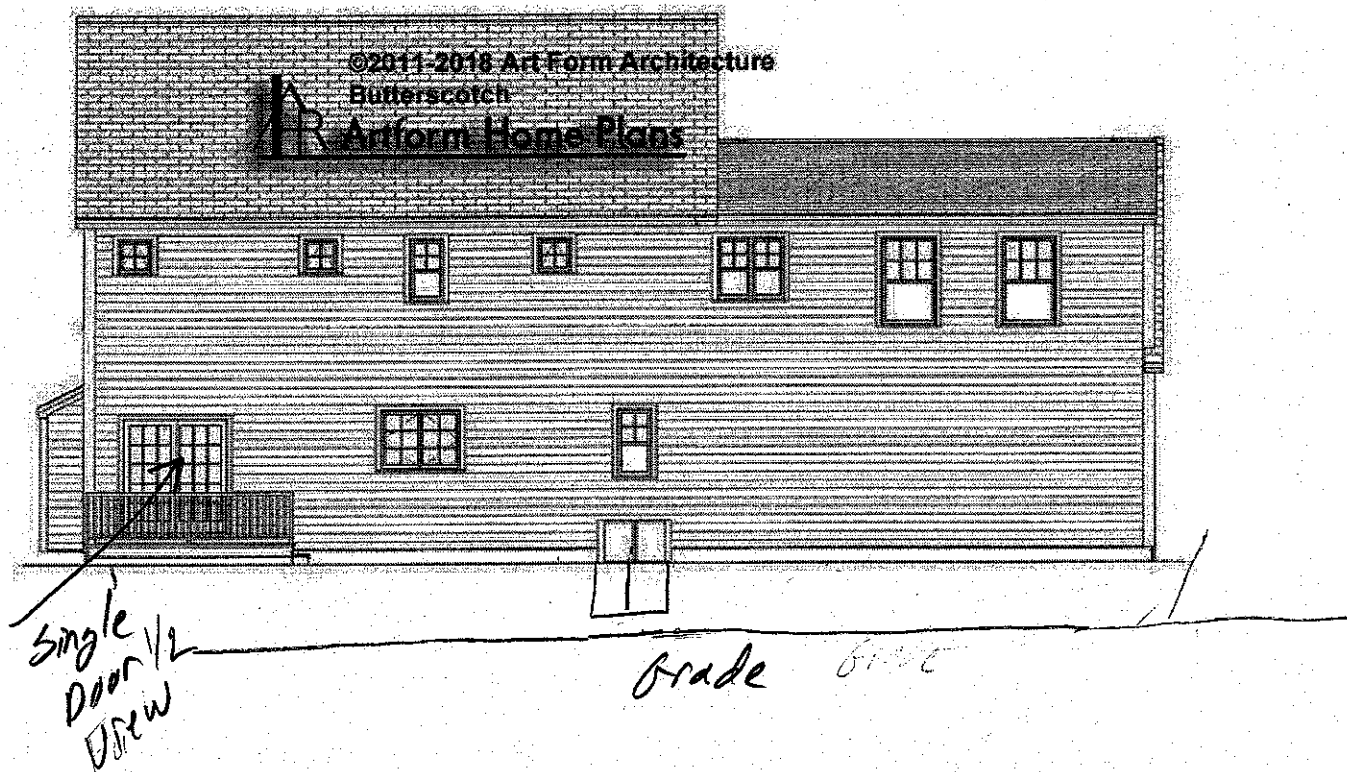

Use of this document is governed by our **Terms and Conditions**, found on our website:
<http://www.artformhomeplans.com/TermsConditions.a5w>

© 2011 Art Form Architecture, Inc. ALL RIGHTS RESERVED.
You may not build this Design without purchasing a License to Build (as defined in our Terms). Unauthorized changes are not permitted and violate copyright laws, which provide substantial penalties for infringement.


Some features shown are optional. Your Purchase & Sale Agreement governs, whether items are labeled "optional" in this document or not.

We are not responsible for typographical errors.

430.124.v15 KR Butterscotch Classic, 36x28



Left Elevation

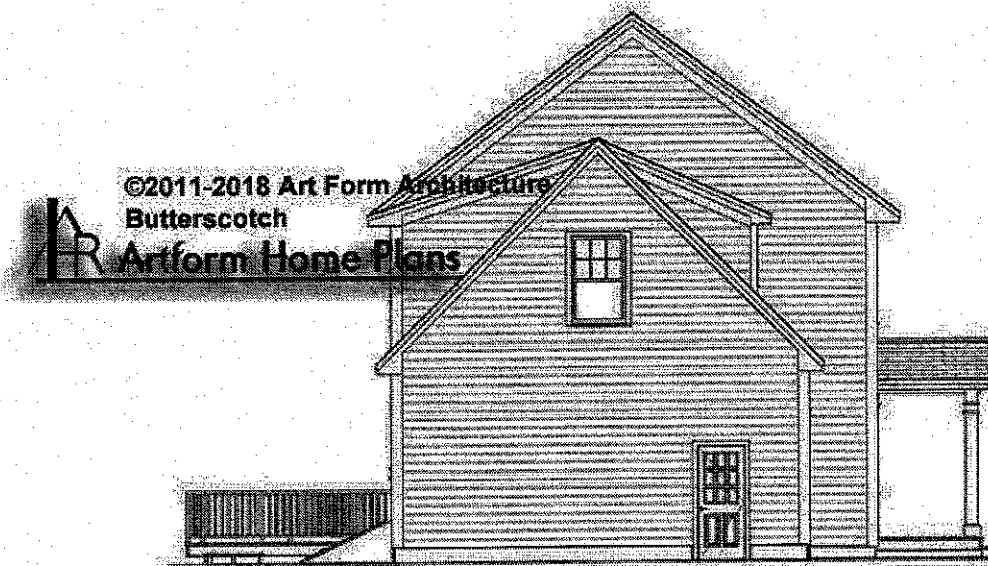

Use of this document is governed by our **Terms and Conditions**, found on our website:
<http://www.artformhomeplans.com/TermsConditions.a5w>

© 2011 Art Form Architecture, Inc. ALL RIGHTS RESERVED.
You may not build this Design without purchasing a License to Build (as defined in our Terms). Unauthorized changes are not permitted and violate copyright laws, which provide substantial penalties for infringement.

Some features show are optional. Your Purchase & Sale Agreement governs, whether items are labeled "optional" in this document or not.

We are not responsible for typographical errors.