


© 2013 Wendy Welton, all rights reserved . You may not build this design without purchasing a license, even if you make changes. This design may have geographic restrictions.

Artform Home Plans

603-431-9559



Deck
~~Handrails~~
Stone
20' x 10' x 10'

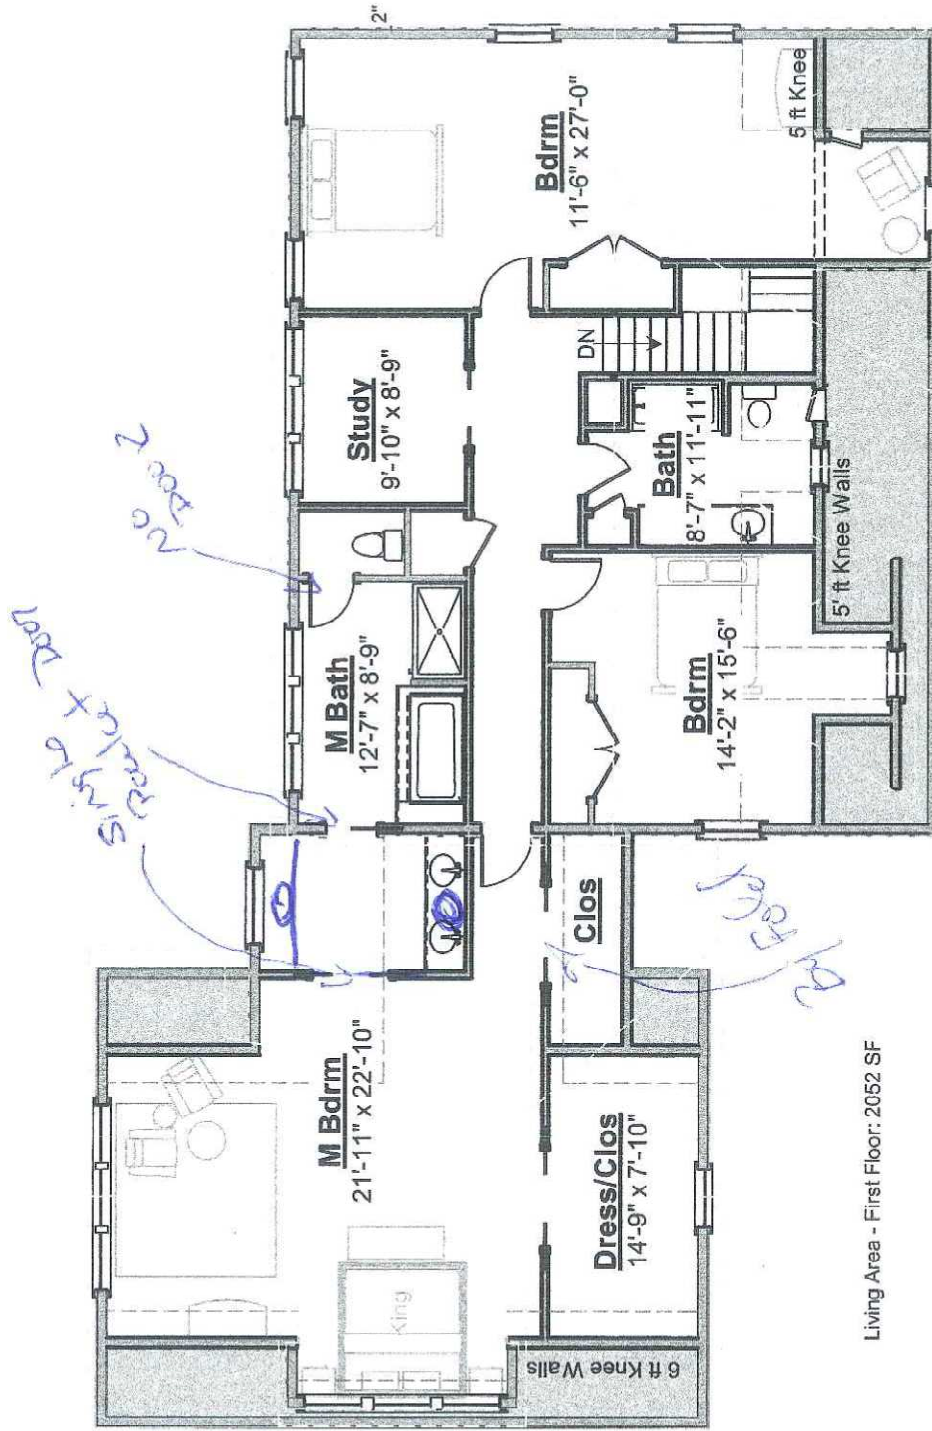

Living Area - First Floor: 2052 SF

Second Floor