


Raspberry Biscotti

564.144.v25 KL (3/25/2019)

© 2013-2019 Art Form Architecture, Inc., all rights reserved .
You may not build this design without purchasing a license,
even if you make changes. This design may have geographic
restrictions.

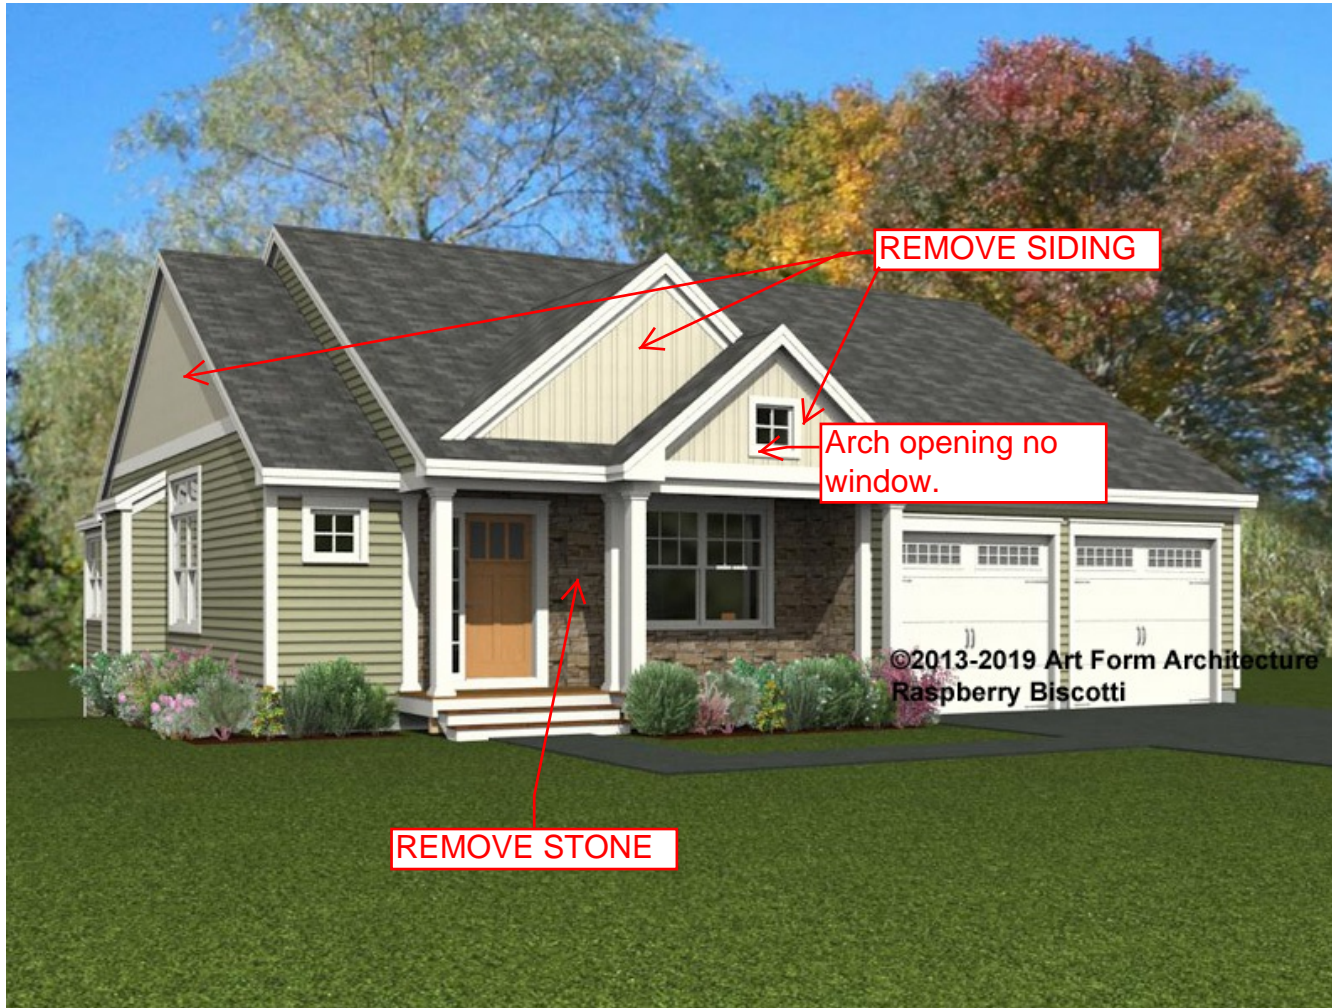

Some items shown are optional and/or may vary. Builder's written specifications always govern.

1. Gas fireplace and it's surround or mantel
2. Kitchen - island, cabinet style & trim, countertop material, etc.
3. Door styles and trim
4. Window grilles and trim, window treatments
5. Stair balusters or low walls at stairs
6. Lighting
7. Material selections (flooring, siding, roofing, paint colors, etc.)
8. Other furnishings
9. Landscaping, paving and walkways
10. Gutters, shutters and other exterior trim components
11. Deck size, railing style, stair location, etc.
12. Amount of exposed basement and/or wood framed walls at basement.

These images are not of any specific building site. Sun and view through windows will vary, as will the site around the house on the exterior and the slope of the land.


3/25/2019

Raspberry Biscotti

564.144.v25 KL (3/25/2019)

© 2013-2019 Art Form Architecture, Inc., all rights reserved .
You may not build this design without purchasing a license,
even if you make changes. This design may have geographic
restrictions.

Artform Home Plans
603-431-9559

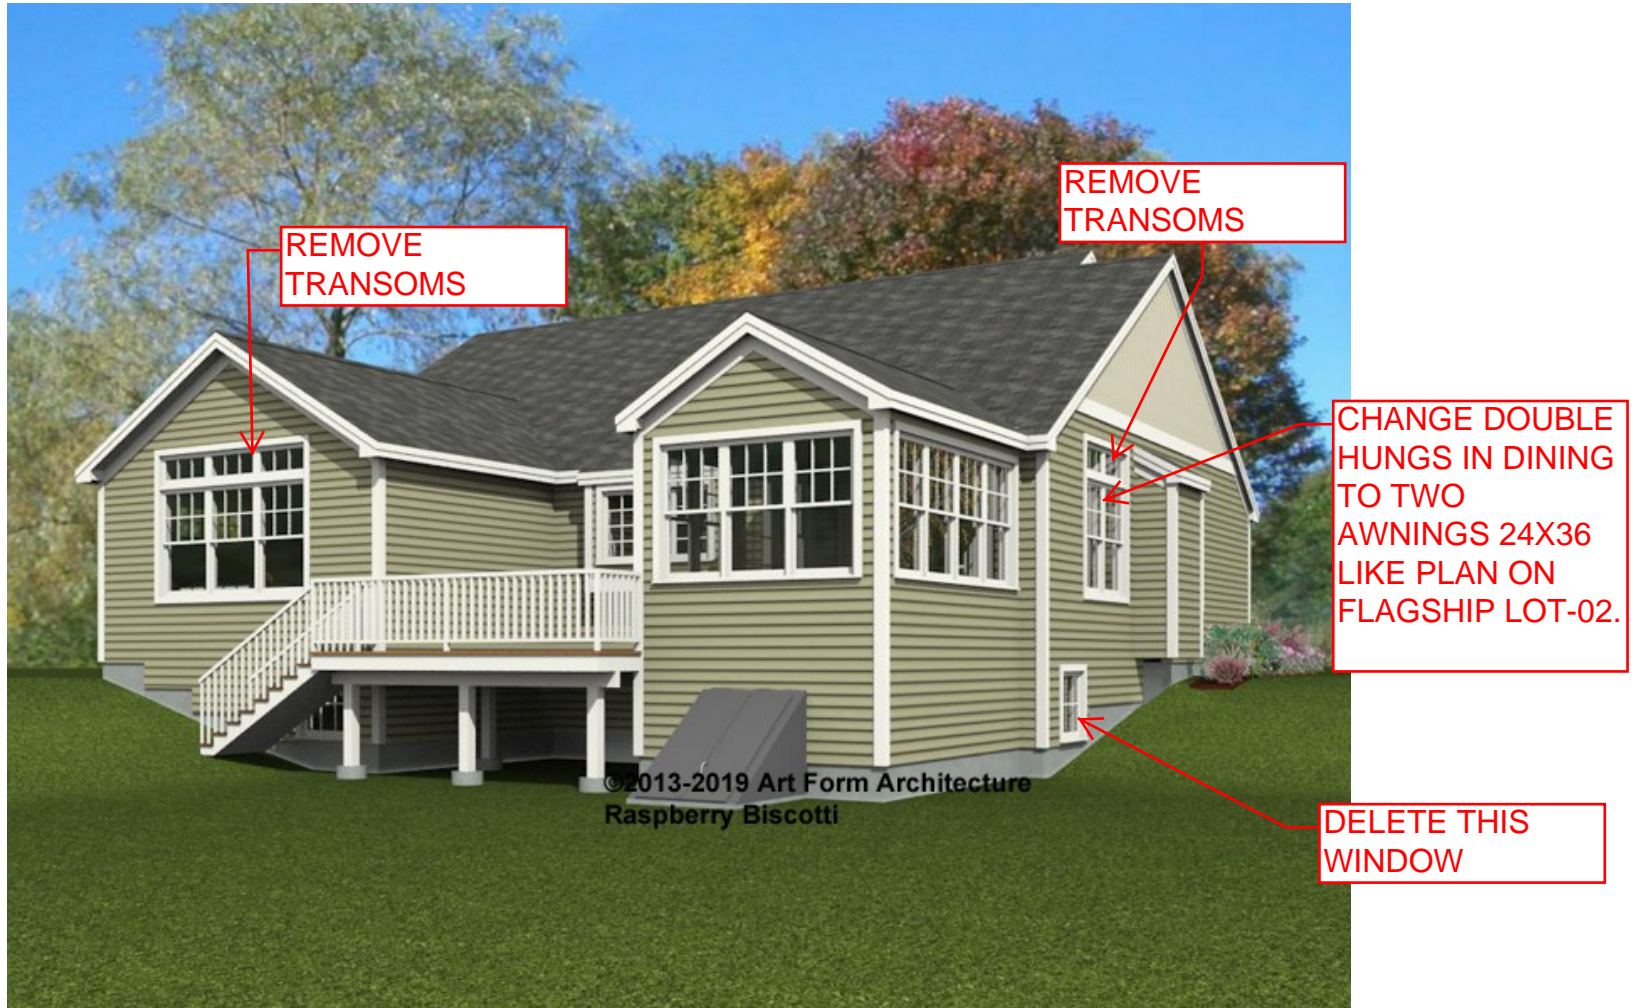

3/25/2019


Raspberry Biscotti

564.144.v25 KL (3/25/2019)

© 2013-2019 Art Form Architecture, Inc., all rights reserved .
You may not build this design without purchasing a license,
even if you make changes. This design may have geographic
restrictions.



603-431-9559

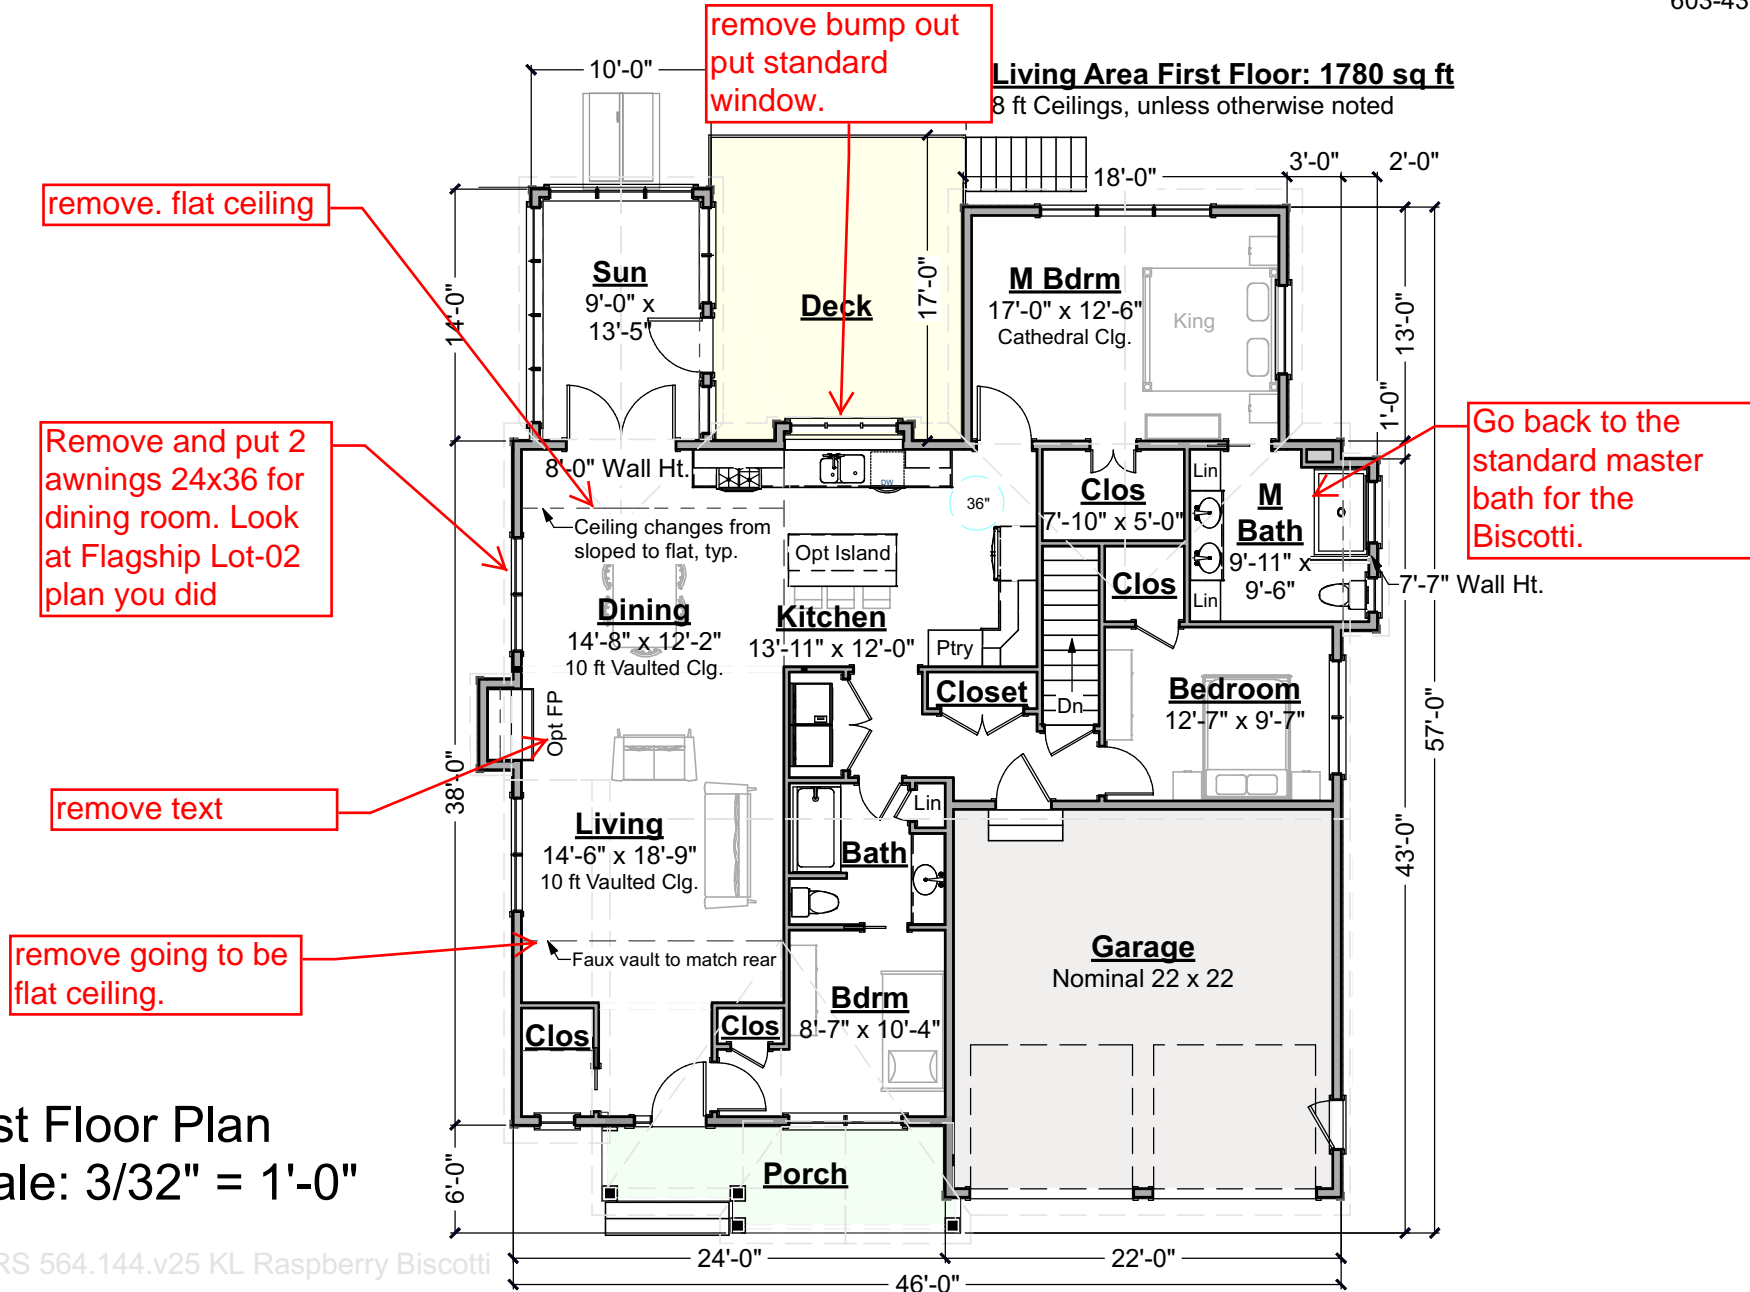

First Floor Plan
Scale: 3/32" = 1'-0"

CRS 564.144.v25 KL Raspberry Biscotti

3/25/2019


Raspberry Biscotti

564.144.v25 KL (3/25/2019)

© 2013-2019 Art Form Architecture, Inc., all rights reserved .
You may not build this design without purchasing a license,
even if you make changes. This design may have geographic
restrictions.



603-431-9559

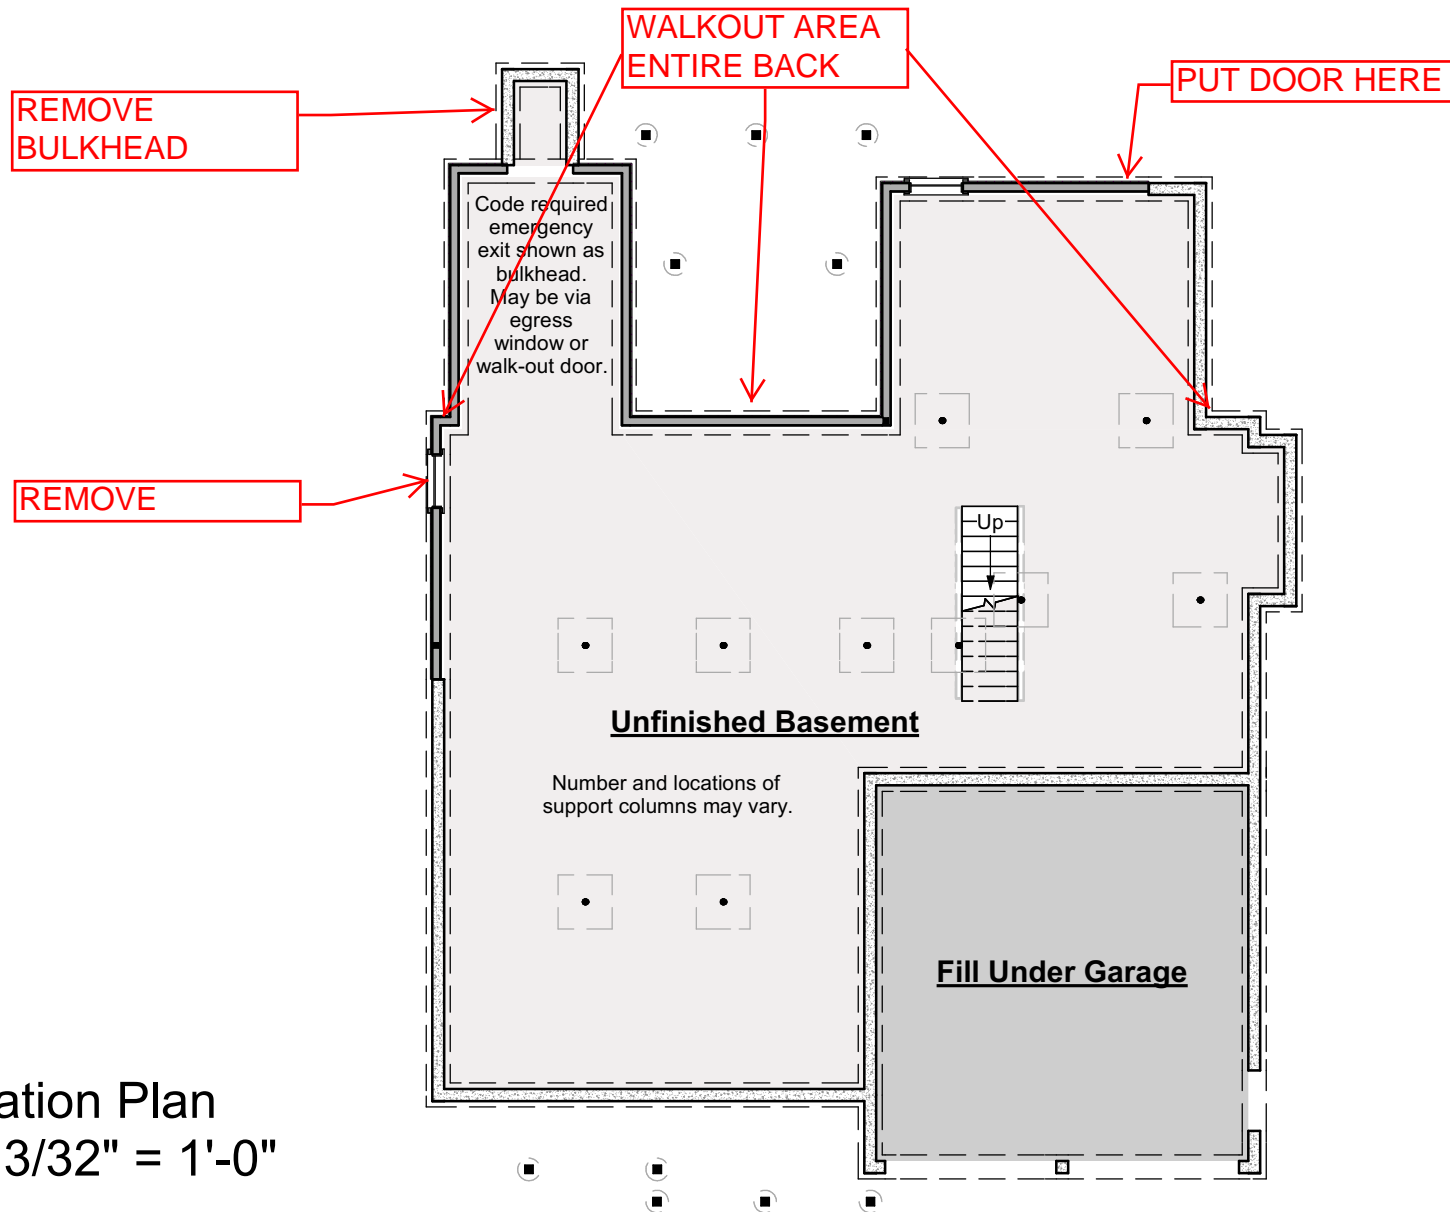

Foundation Plan
Scale: 3/32" = 1'-0"

3/25/2019

Raspberry Biscotti

564.144.v25 KL (3/25/2019)

© 2013-2019 Art Form Architecture, Inc., all rights reserved .
You may not build this design without purchasing a license,
even if you make changes. This design may have geographic
restrictions.

Artform Home Plans
603-431-9559



Front Elevation
Scale: 1/8" = 1'-0"

CRS 564.144.v25 KL Raspberry Biscotti

3/25/2019

Raspberry Biscotti

564.144.v25 KL (3/25/2019)

© 2013-2019 Art Form Architecture, Inc., all rights reserved .
You may not build this design without purchasing a license,
even if you make changes. This design may have geographic
restrictions.

 **Artform Home Plans**
603-431-9559



Right Elevation
Scale: 1/8" = 1'-0"

CRS 564.144.v25 KL Raspberry Biscotti


3/25/2019

Raspberry Biscotti

564.144.v25 KL (3/25/2019)

© 2013-2019 Art Form Architecture, Inc., all rights reserved .
You may not build this design without purchasing a license,
even if you make changes. This design may have geographic
restrictions.

Artform Home Plans
603-431-9559

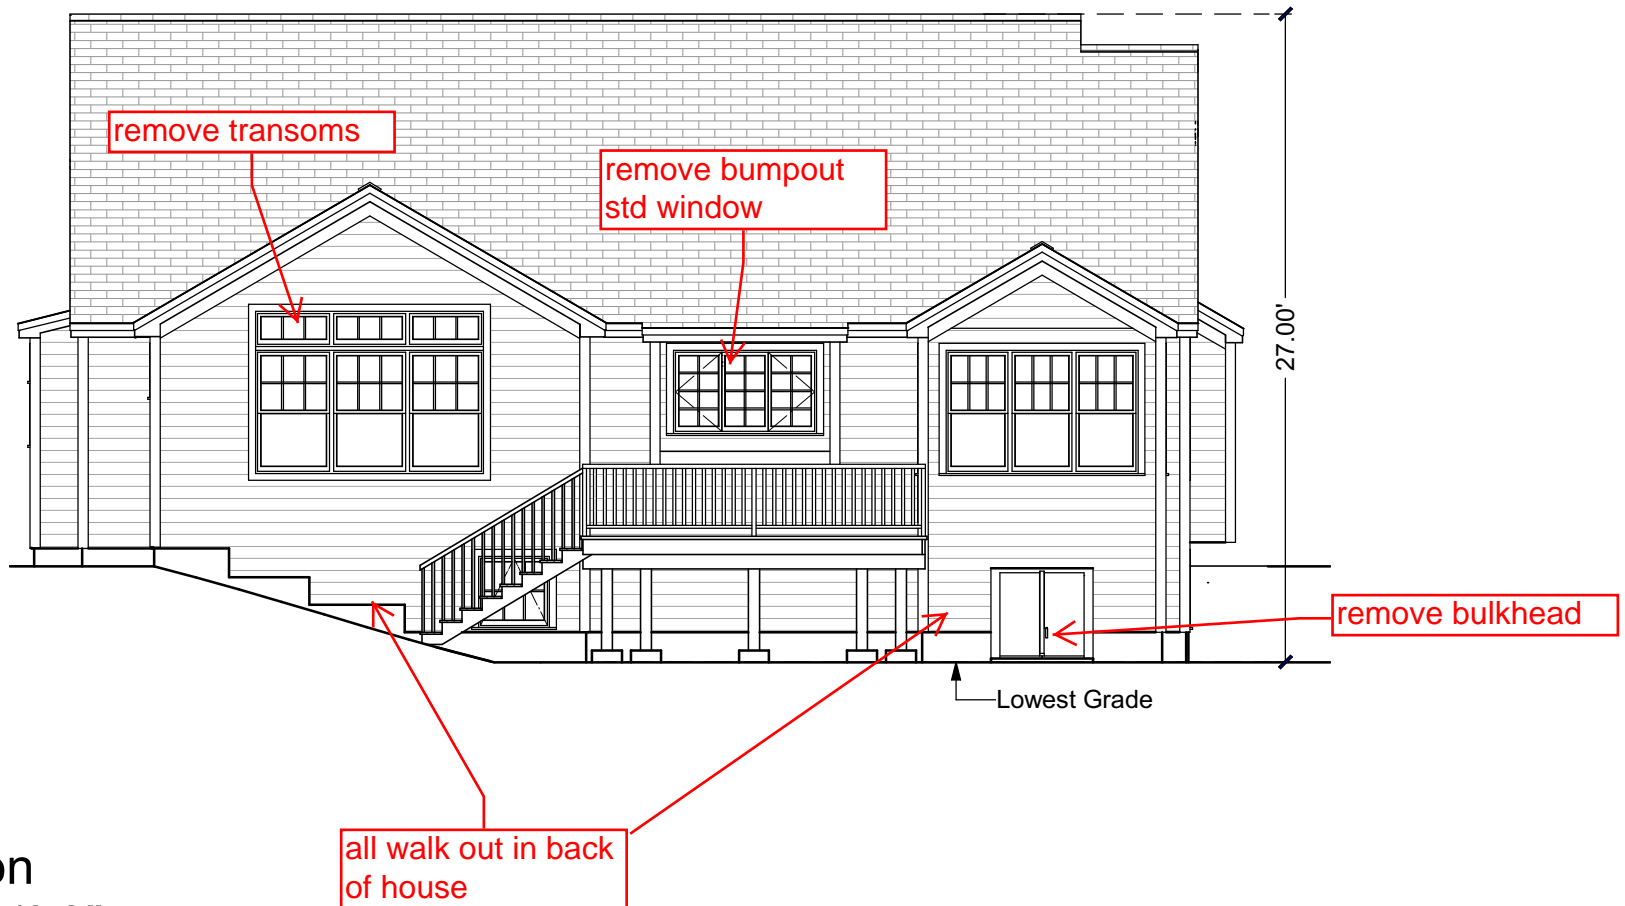

Rear Elevation
Scale: 1/8" = 1'-0"


3/25/2019

Raspberry Biscotti

564.144.v25 KL (3/25/2019)

© 2013-2019 Art Form Architecture, Inc., all rights reserved .
You may not build this design without purchasing a license,
even if you make changes. This design may have geographic
restrictions.

 **Artform Home Plans**
603-431-9559

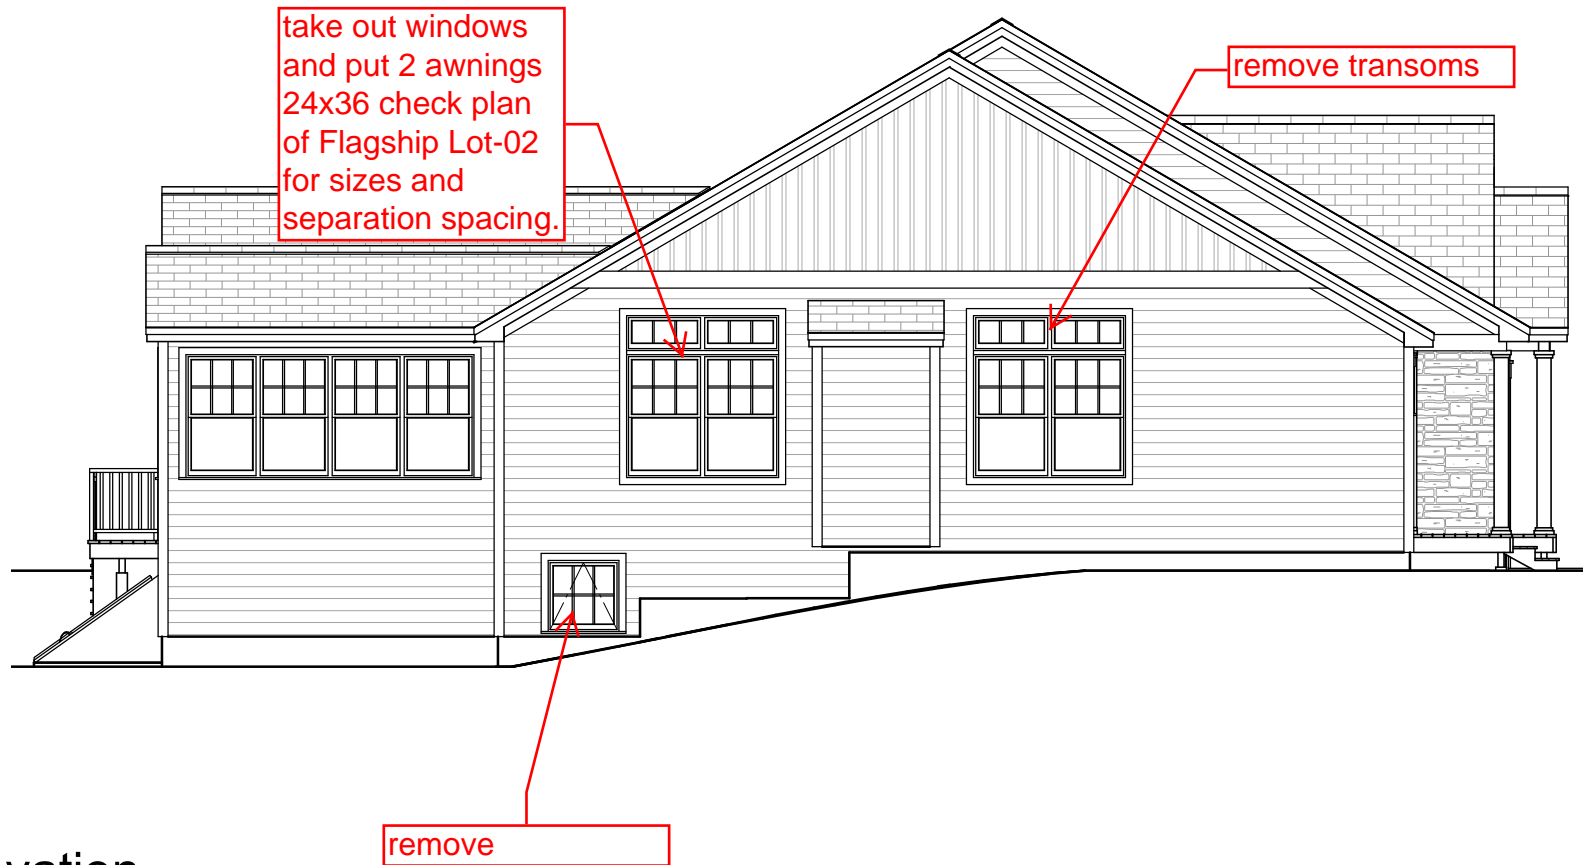

Left Elevation
Scale: 1/8" = 1'-0"