




©2014 Wendy Watton
Norine
Artform Home Plans

Living Area Second Floor: 930 SF

40'

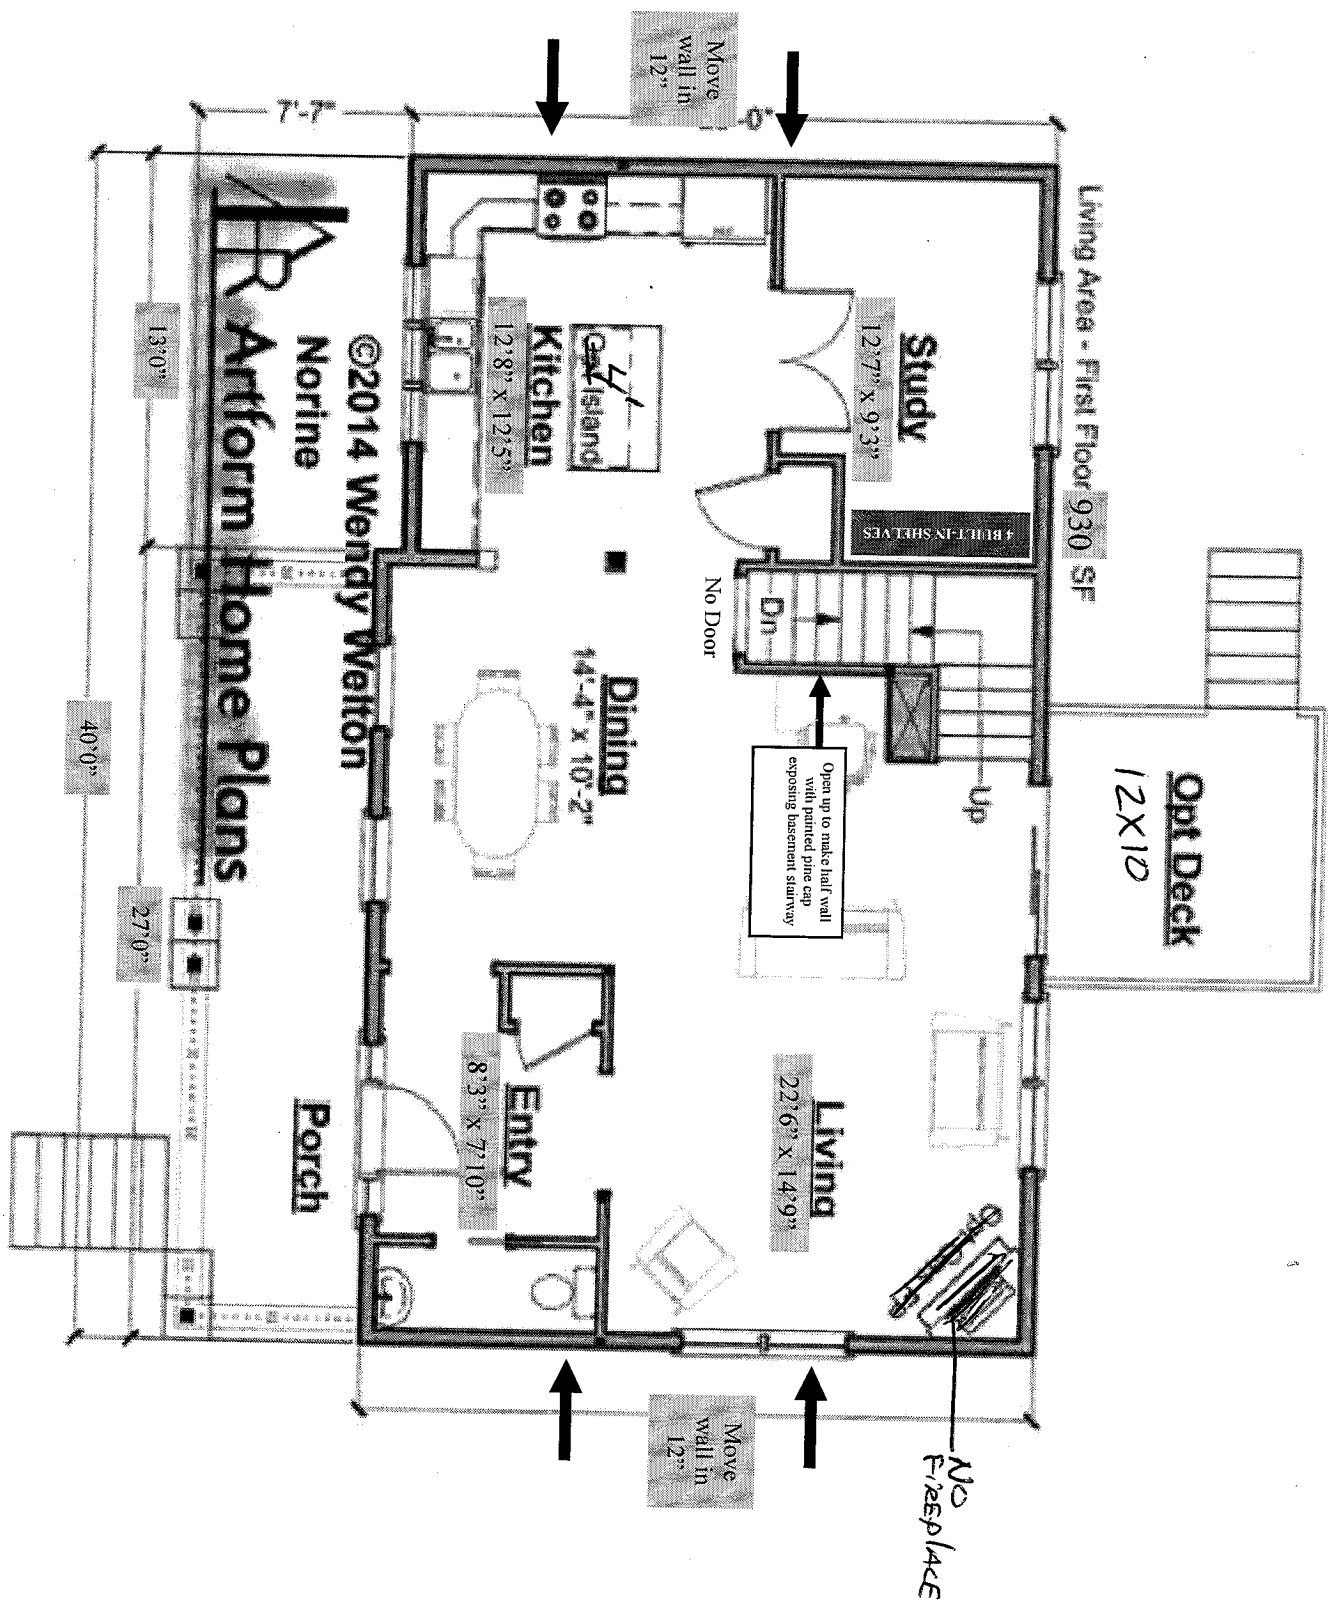