
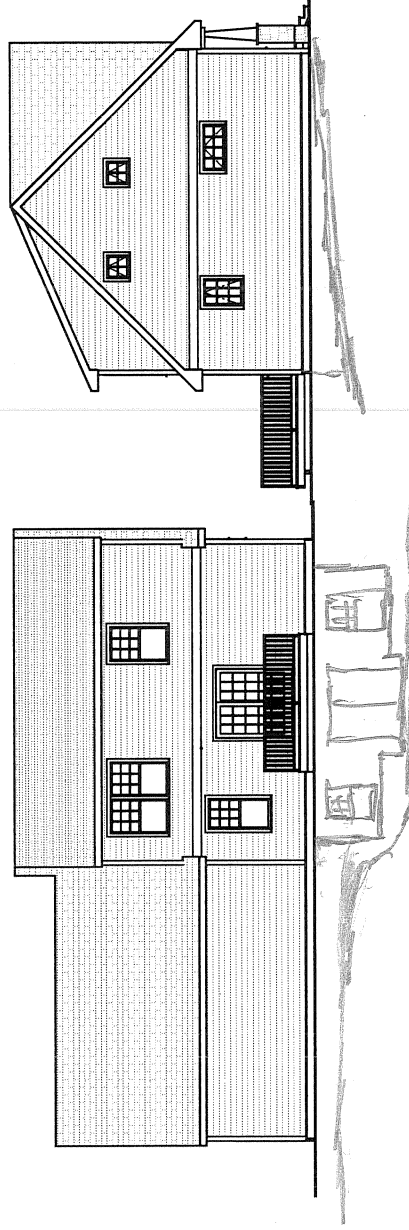
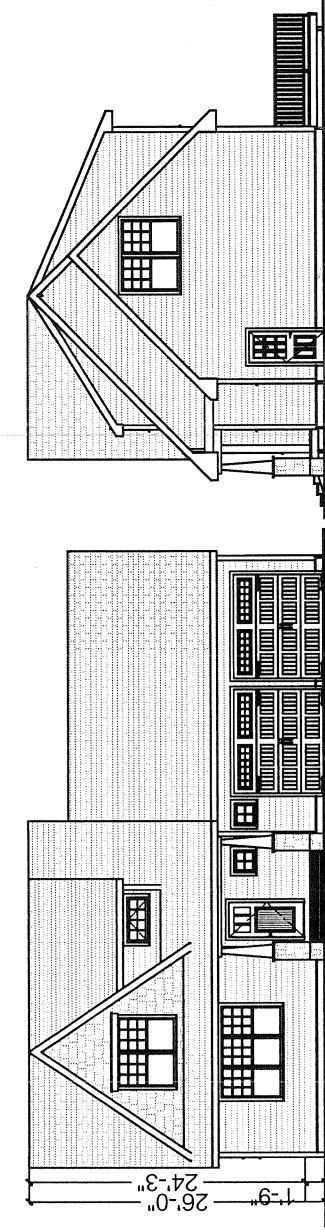


Opal Marquise, 2 Car Attached

370.003

© 2010-2012 Wendy Welton, all rights reserved

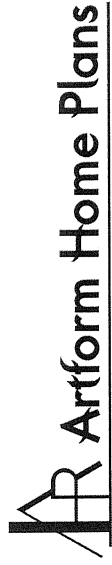

Mirror image plans
garage to be on left.

X-C

Some items shown are optional and/or may vary. Builder's written specifications always govern.

1. Gas fireplace and it's surround or mantel
2. Kitchen - island, cabinet style & trim, countertop material, etc.
3. Door styles and trim
4. Window grilles and trim, window treatments
5. Stair balusters or low walls at stairs
6. Lighting
7. Material selections (flooring, siding, roofing, paint colors, etc.)
8. Other furnishings
9. Landscaping, paving and walkways
10. Gutters, shutters and other exterior trim components
11. Deck - size, railing style, stair location, etc.
12. Amount of exposed basement and/or wood framed walls at basement.


These images are not of any specific building site. Sun and view through windows will vary, as will the site around the house on the exterior and the slope of the land.

Opal Marquise, 2 Car Attached

370.003

© 2010-2012 Wendy Welton, all rights reserved

First Floor

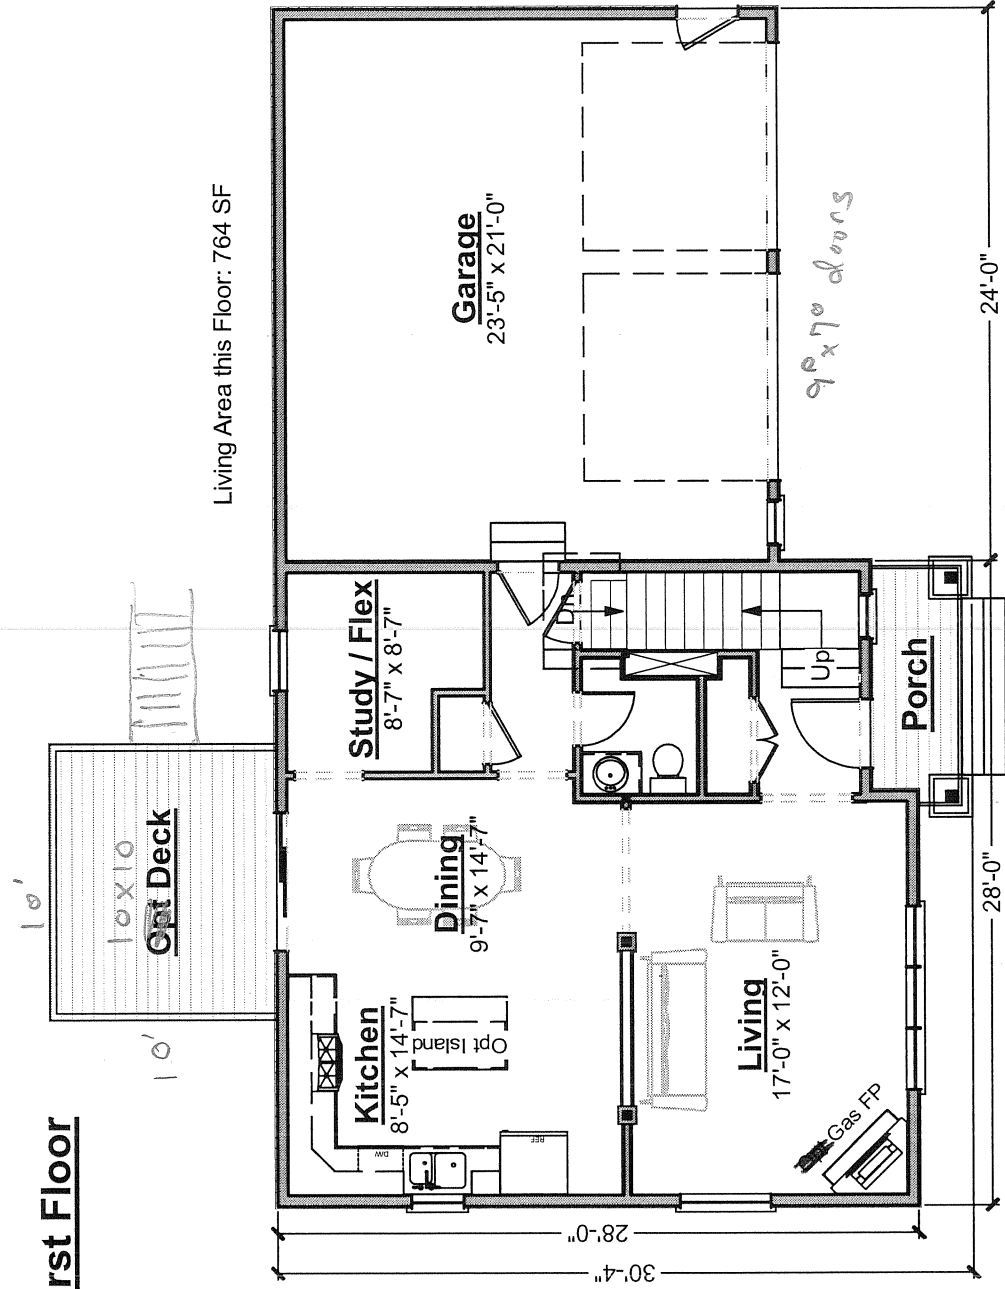

KC


Opal Marquise, 2 Car Attached

370.003

© 2010-2012 Wendy Welton, all rights reserved



Second Floor

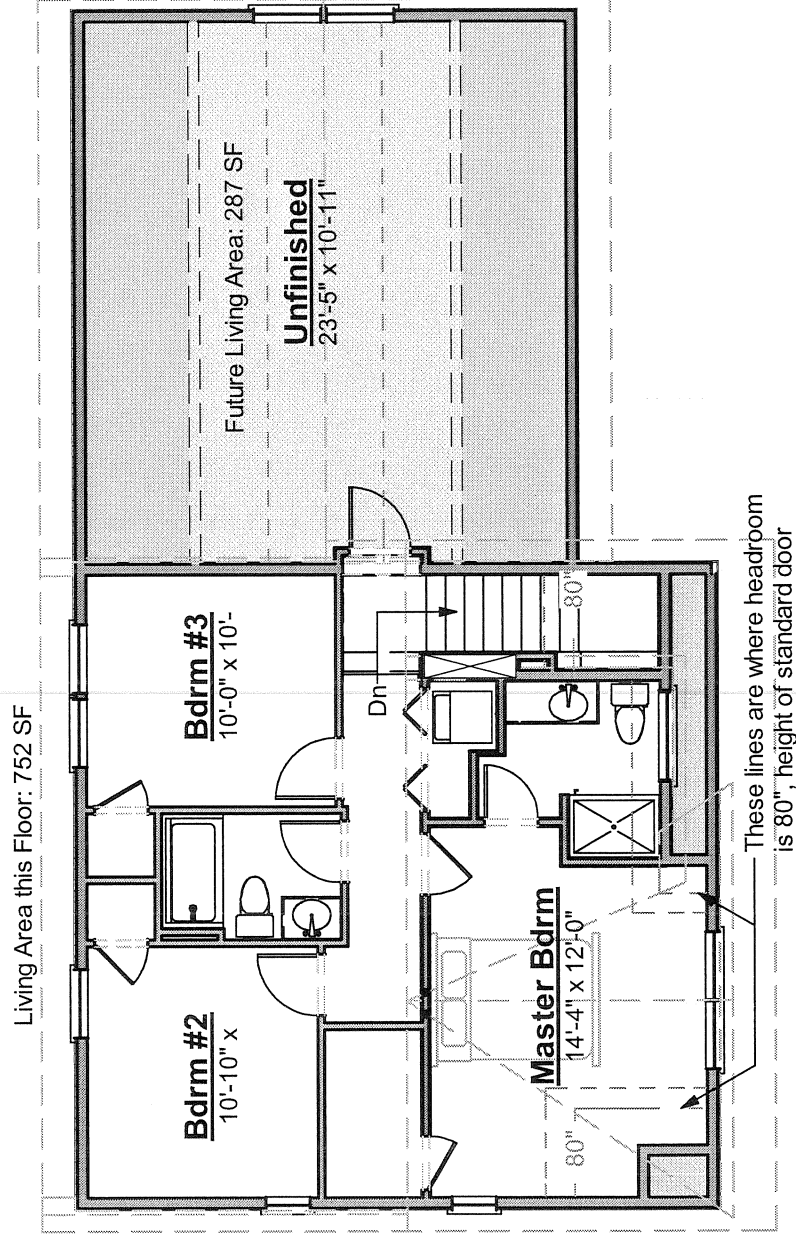

80"

mirror

Opal Marquise, 2 Car Attached

370.003

© 2010-2012 Wendy Welton, all rights reserved



Basement

