

01/2020

Alexander Classic

449.124.v20 GR (3/17/2020)

© 2011-2020 Art Form Architecture, Inc., all rights reserved . You may not build this design without purchasing a license, even if you make changes. This design may have geographic restrictions.

Artform Home Plans

603-431-9559

Option 1: As sketched
Option 2: Front facing garage

larger window like "Great Alexander"

Gable end



remove porch

Front door w/
side lights
Front porch like
"Great Alexander"

no bump
out
separate windows

Front Elevation

Scale: 3/32" = 1'-0"


Alexander Classic

449.124.v20 GR (3/17/2020)

© 2011-2020 Art Form Architecture, Inc., all rights reserved. You may not build this design without purchasing a license, even if you make changes. This design may have geographic restrictions.

Artform Home Plans

603-431-9559

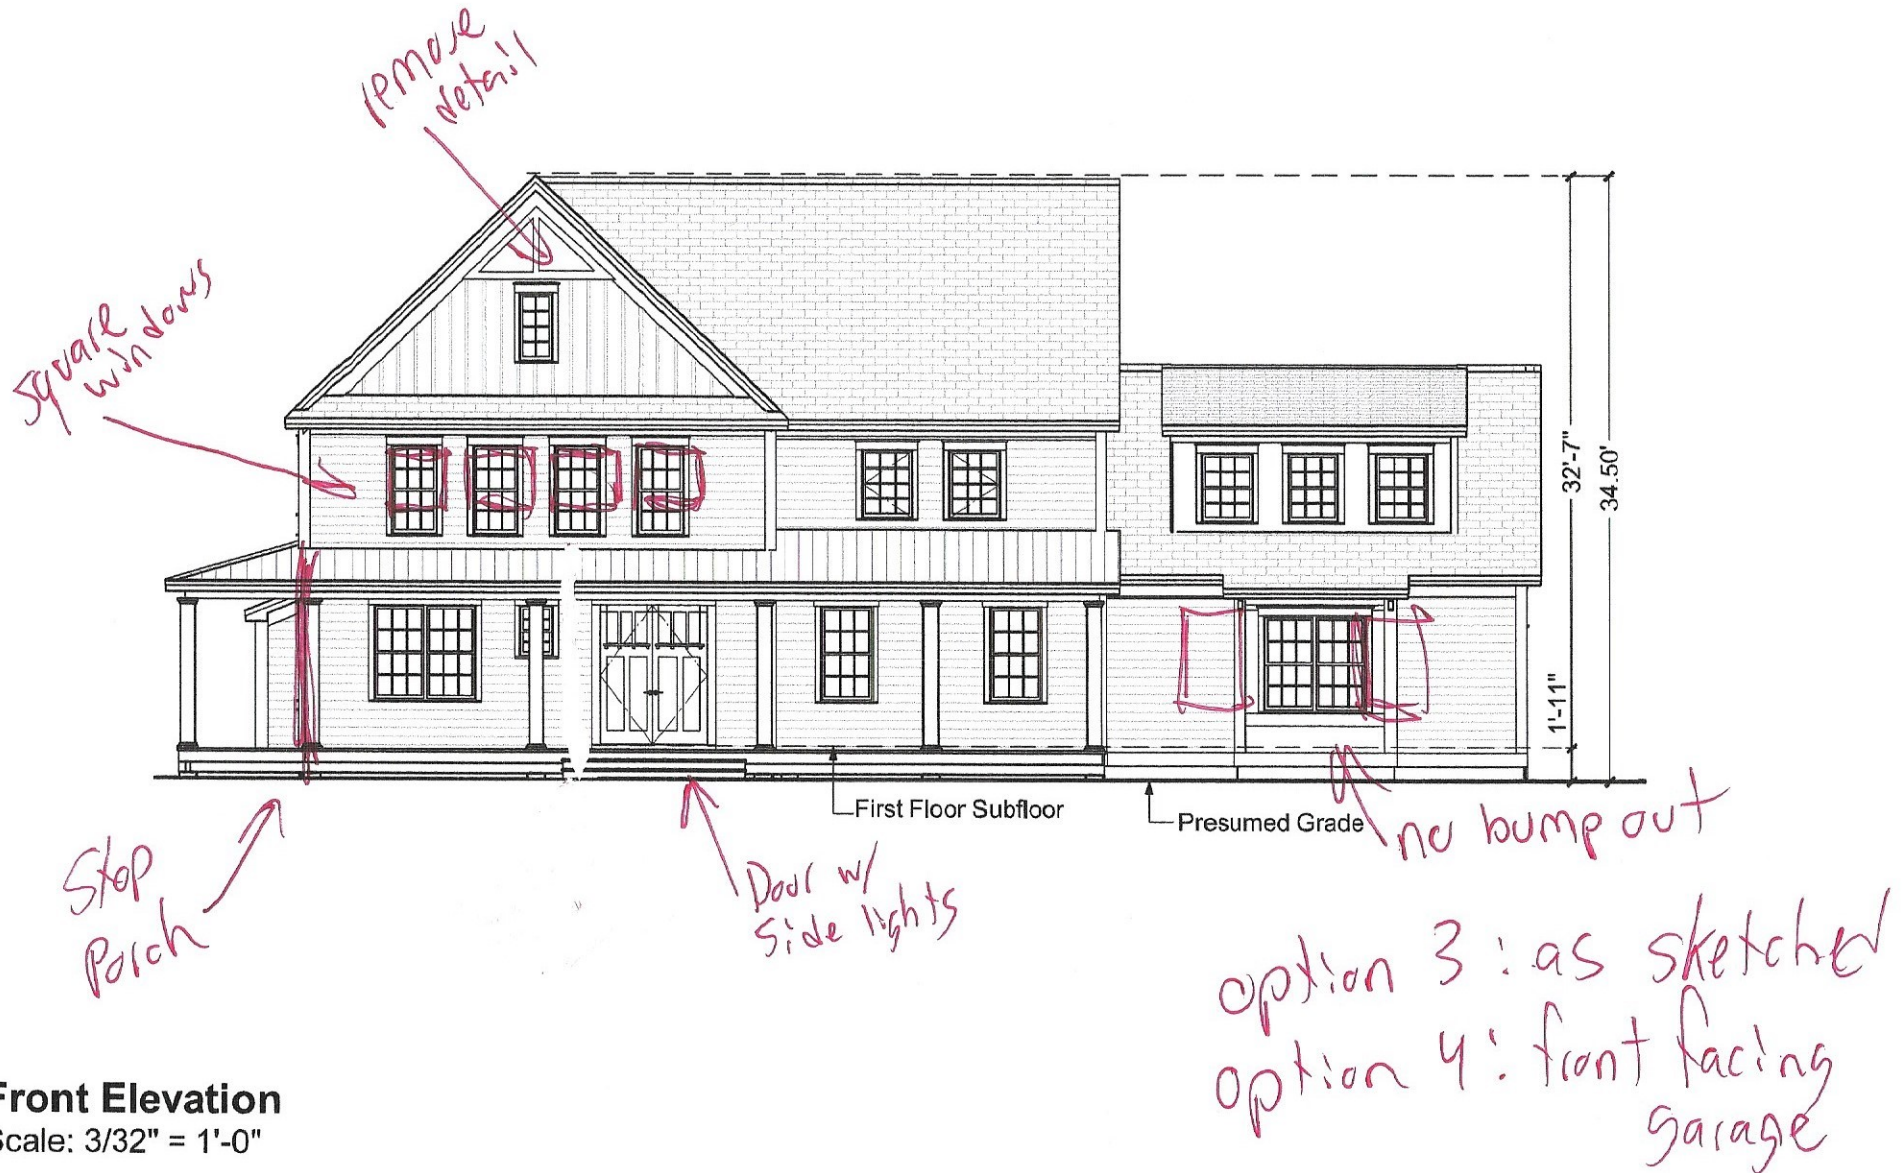

Front Elevation

Scale: 3/32" = 1'-0"

3/17/2020

Alexander Classic

449.124.v20 GR (3/17/2020)

© 2011-2020 Art Form Architecture, Inc., all rights reserved. You may not build this design without purchasing a license, even if you make changes. This design may have geographic restrictions.

Artform Home Plans

603-431-9559

Option 5: as sketched



end porch

gable dormer over front door

no porch

stone below windows

3 square windows

Front Elevation

Scale: 3/32" = 1'-0"