


748.144 KR Pharell

First Floor

	Area	Beds	Baths
Main	1724 SF	2	2
Future	0 SF	1	0
Apt	0 SF	0	0
Total	1724 SF	3	2
Ceiling Height			
	Shown	9'-0"	
	Possible*	8'-0"	

* See Major Change Information on plan page for cost

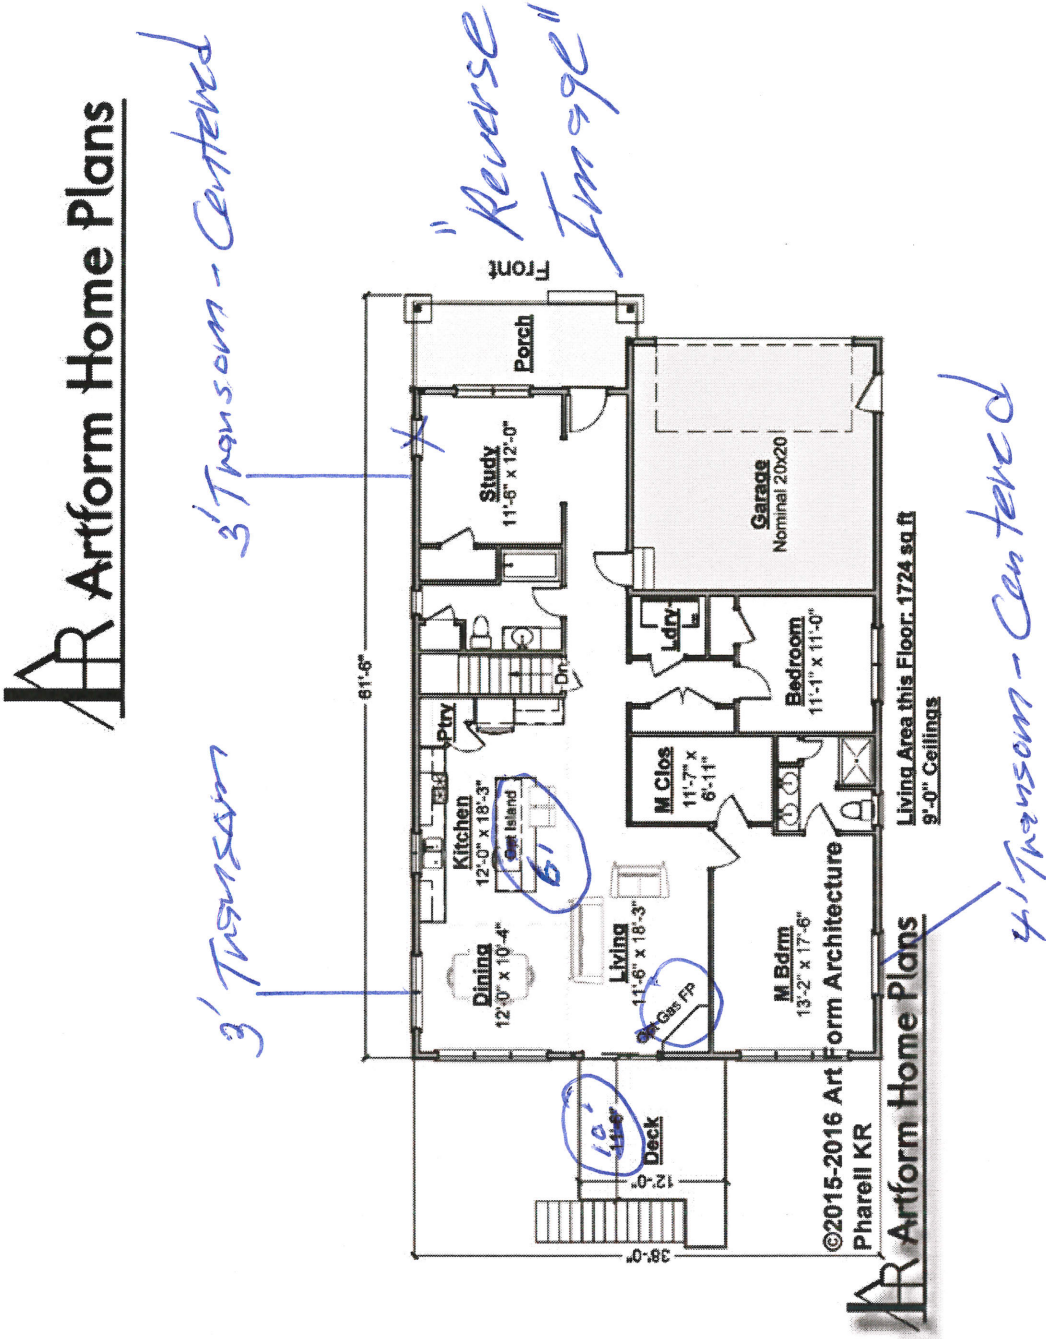

Use of this document is governed by our Terms and Conditions, found on our website: <http://www.artformhomeplans.com/TermsConditions.a5w>

Some features show are optional. Your Purchase & Sale Agreement governs, whether items are labeled "optional" in this document or not.

© 2015 Art Form Architecture, Inc. ALL RIGHTS RESERVED.

You may not build this Design without purchasing a License to Build (as defined in our Terms). Unauthorized changes are not permitted and violate copyright laws, which provide substantial penalties for infringement.

We are not responsible for typographical errors.