



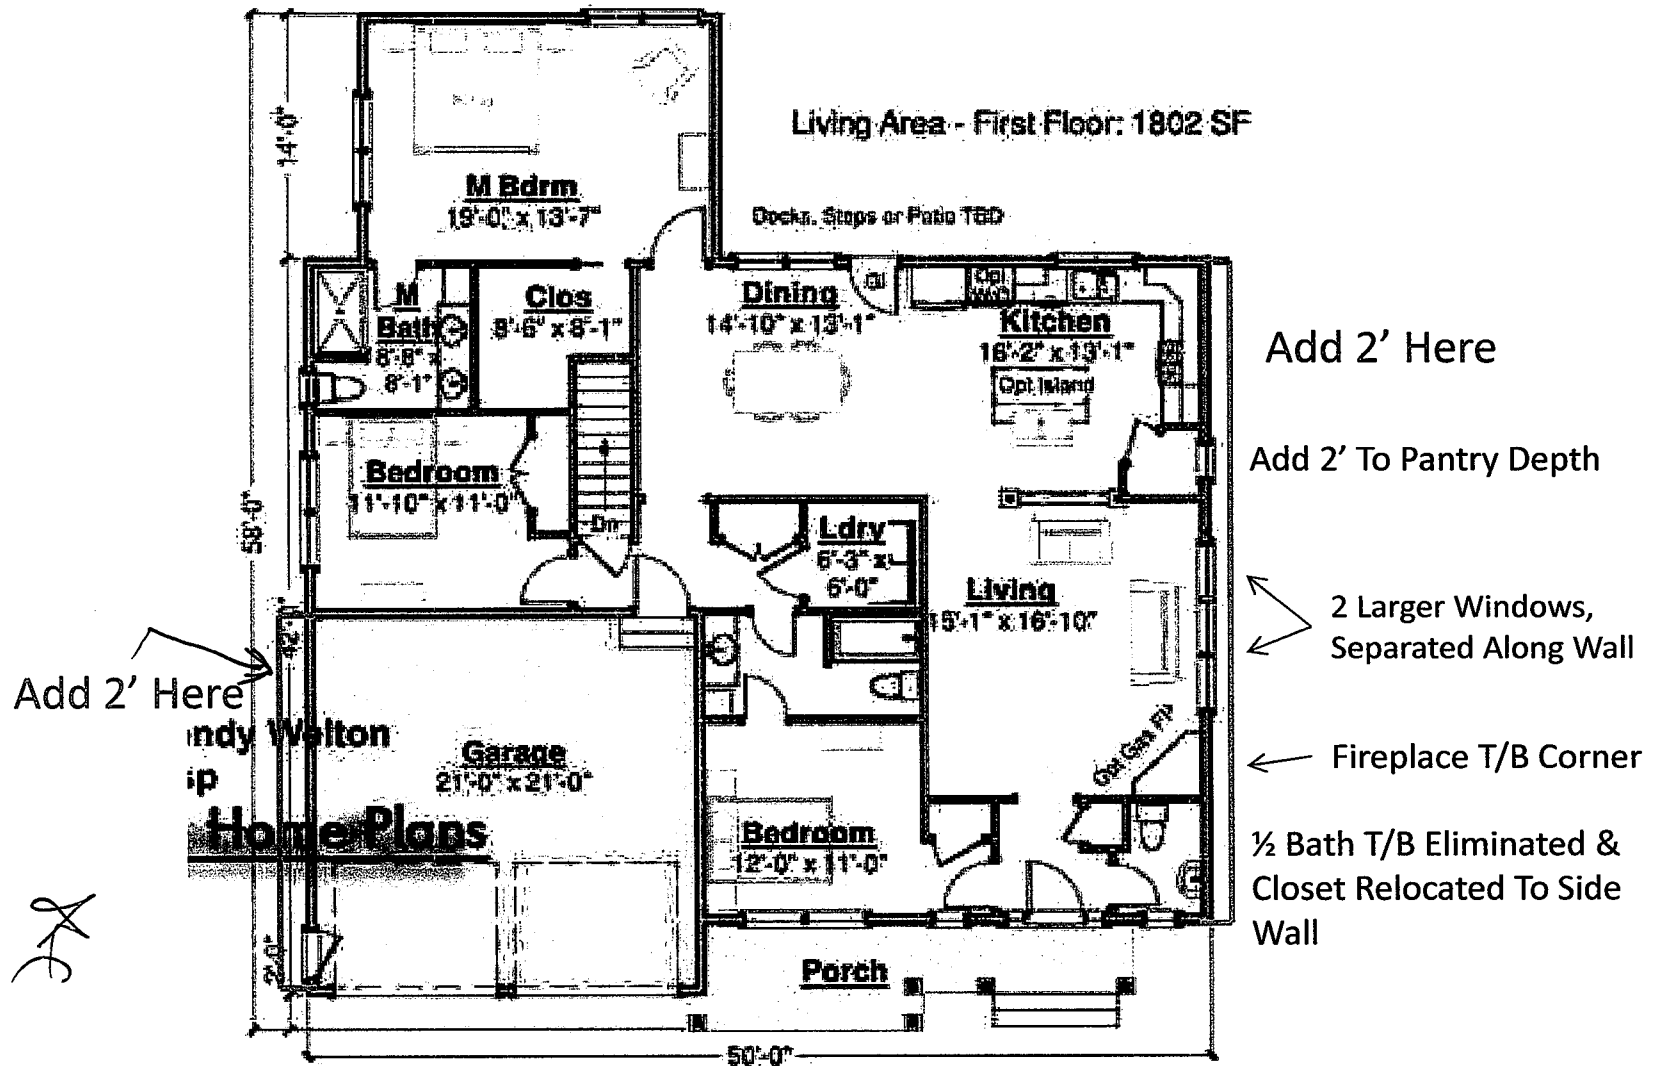

FINAL "LITCHFIELD" MAIN FLOOR PLAN, OR SIMILAR...

DA 5/8/14
 Q2 5/8/14

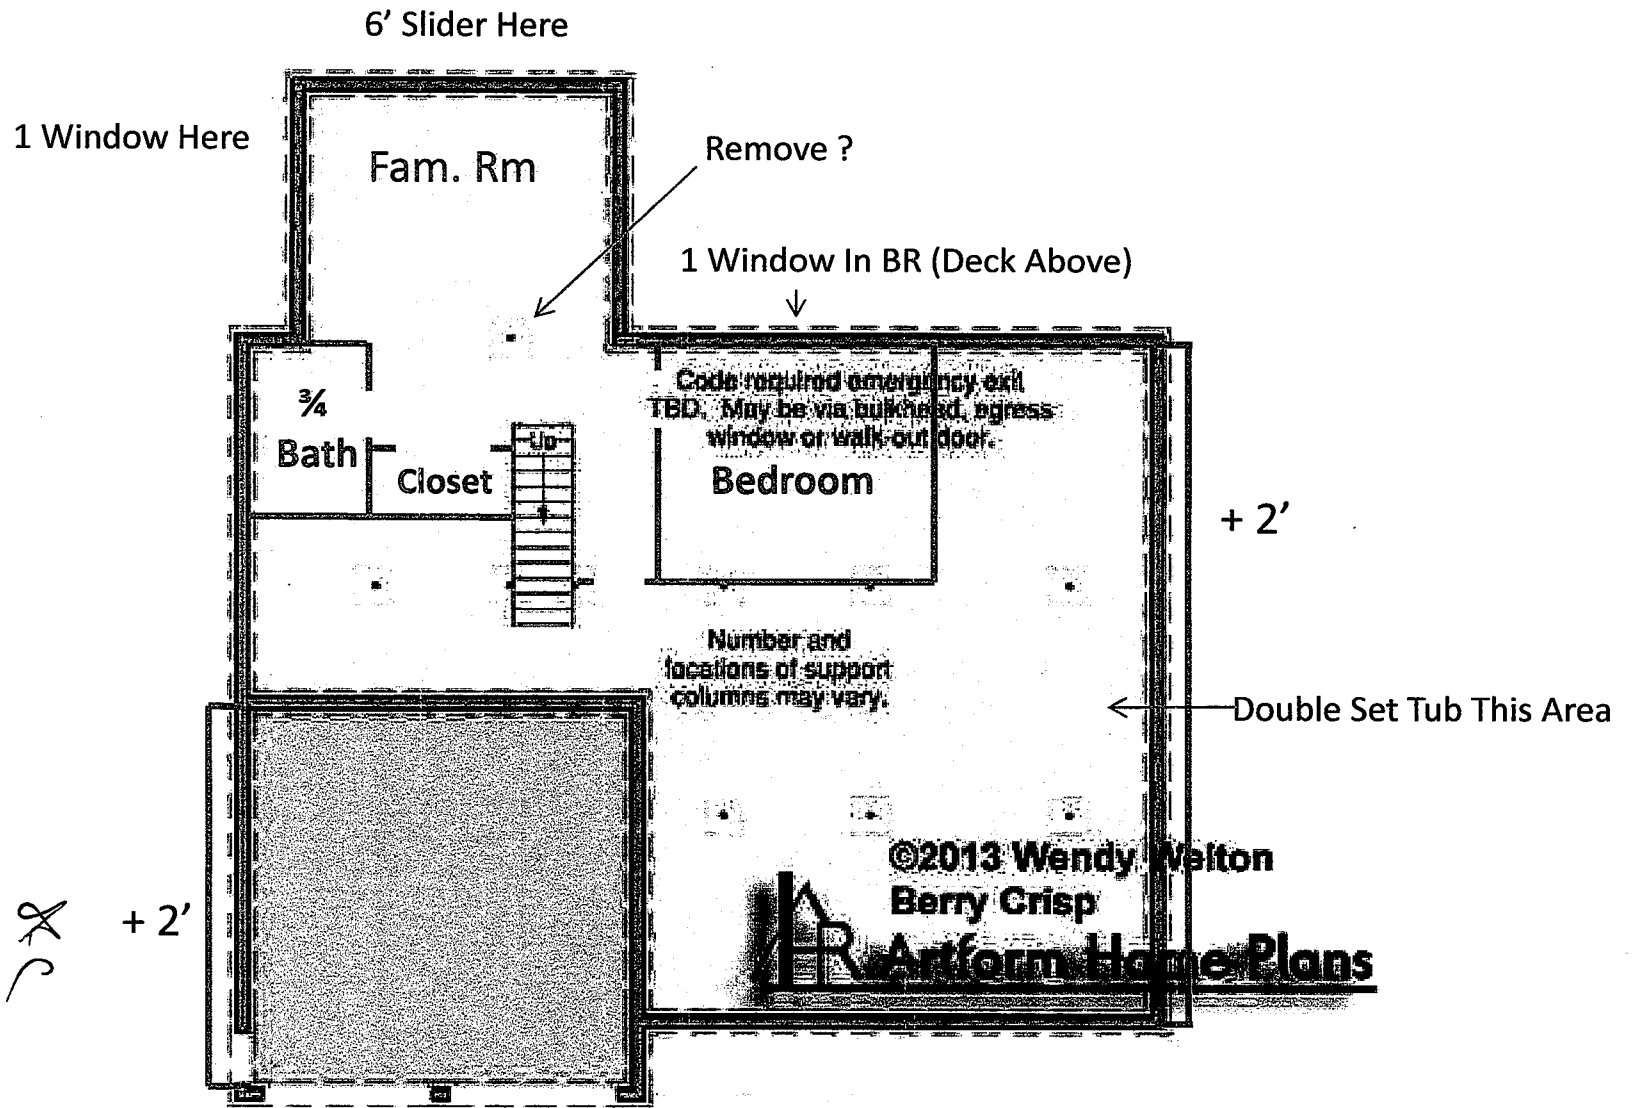

FINAL "LITCHFIELD" BASEMENT PLAN, OR SIMILAR...

Doc 6/8/14
22 5/8/14