


- ① move FP TO EXT wall
- ② ADD windows - 2 FULL size
- ③ move Bulhead to cable wall
- ④ Deck enlarge TO 14x14
- ⑤ move garage door to back of garage
- ⑥ move STAIRS TO RIGHT side

- ⑦ new pantry Layout
- ⑧ NEW BATH Layout
- ⑨ ADD 3 Daylight windows TO Back foundation wall

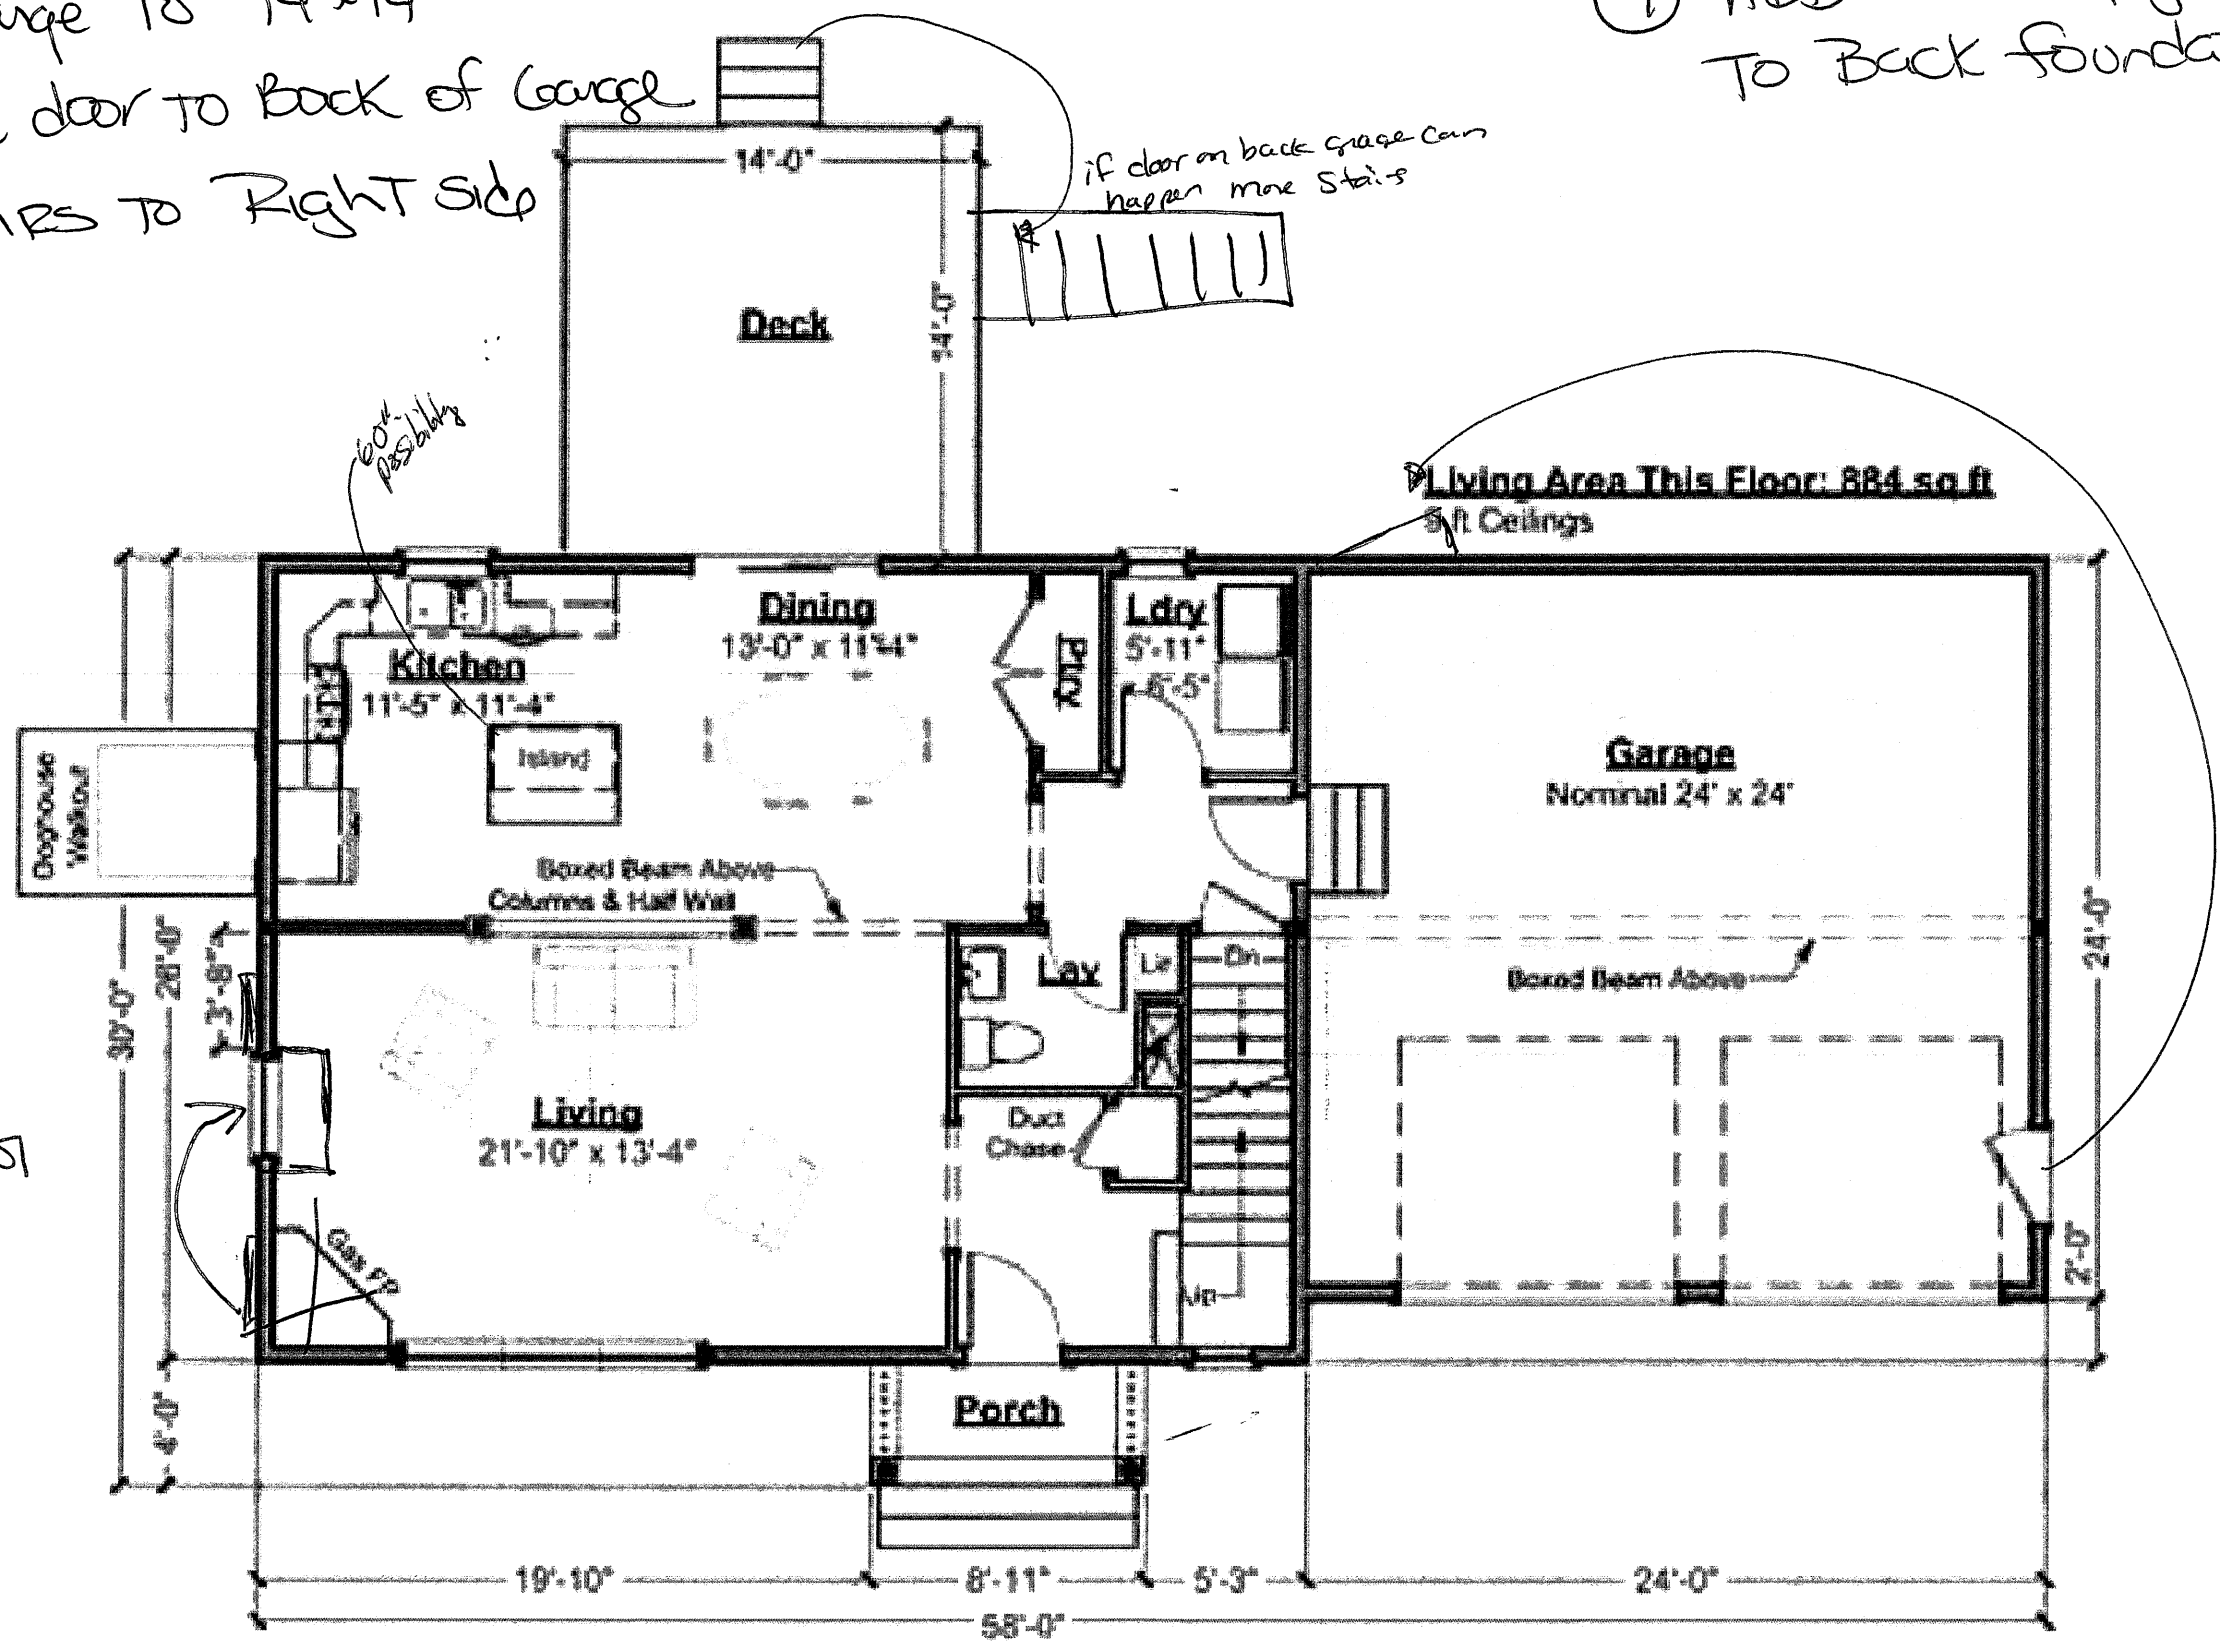

9' ceilings  
first floor

- ⑨ mull windows Back Bedroom
- ⑩ change Bath config
- ⑪ change closet config

