


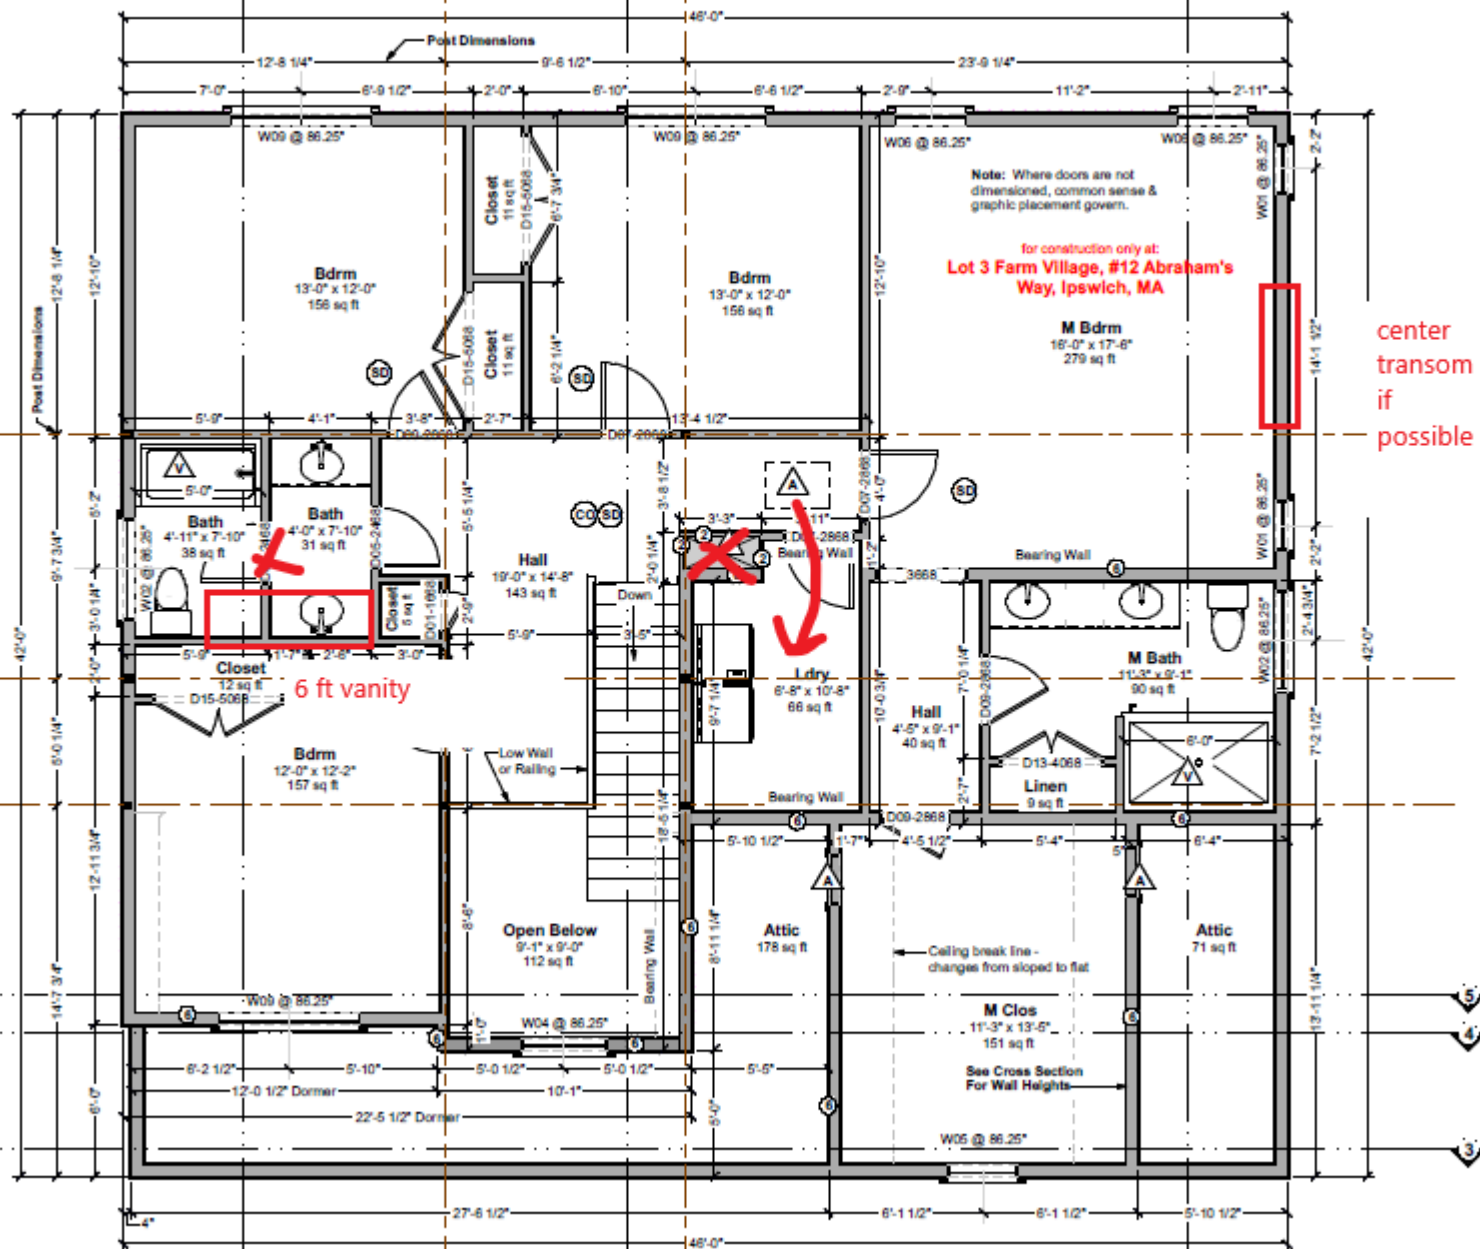

Second Floor Plan