


HOMEOWNER: Instruction plans ARE NOT a part of your construction with your builder, unless your P&S agreement specifies so. Your P&S and it's attachments (like the builder's plan or a review set of this design) describes what you and builder agreed the builder would build for you. We here Home Plans do not have the authority to obligate your builder to provide you with amenities like fireplaces and spa tubs. It's between you and your builder governs.

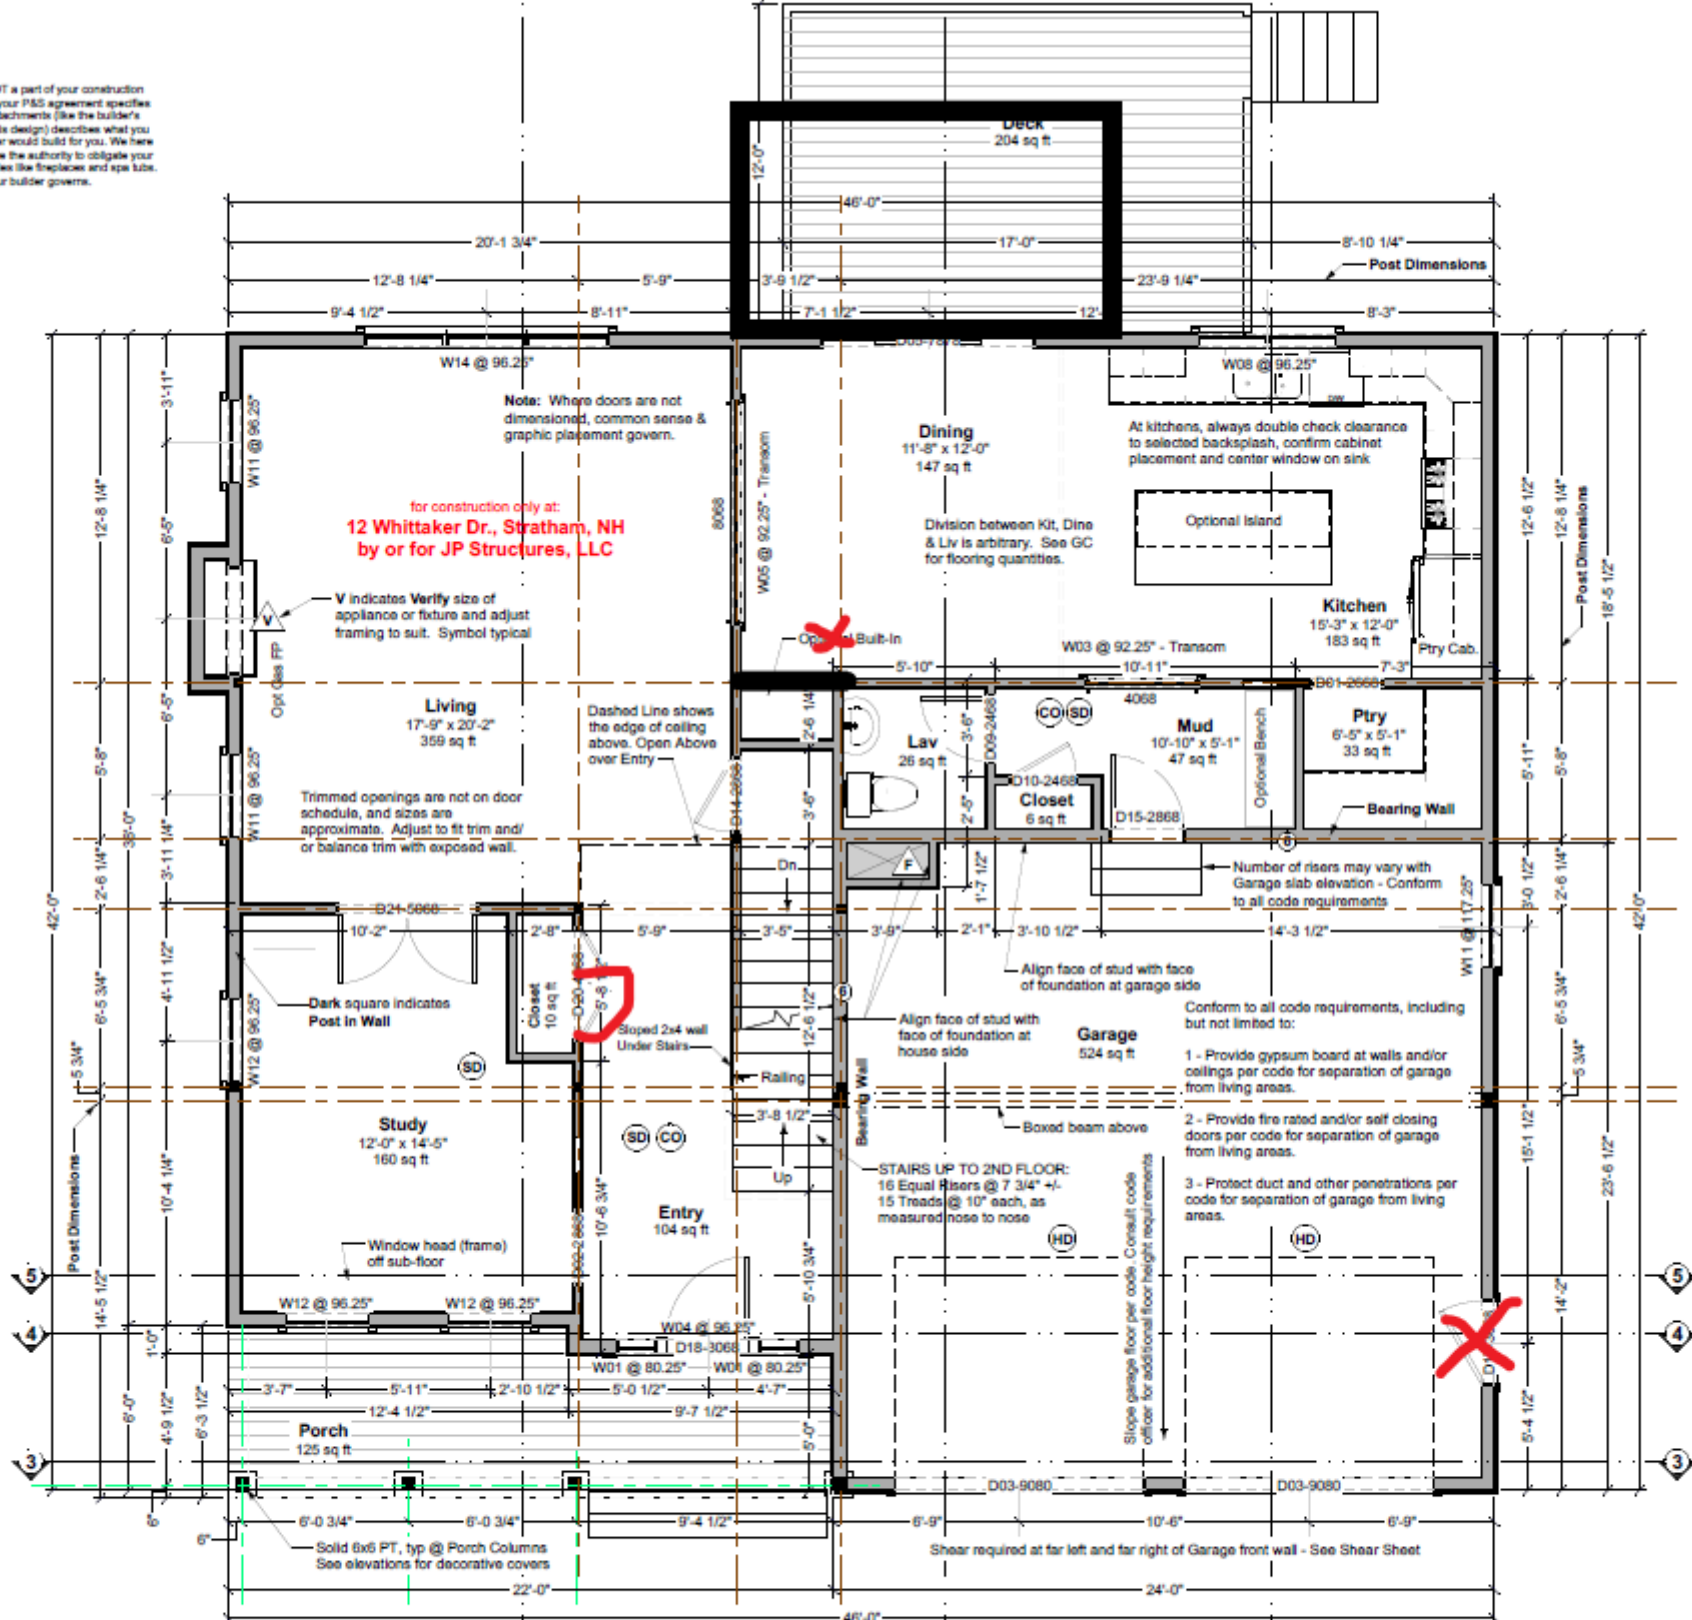

First Floor Plan

Living Area this Floor: 1253 sq ft
Finished Ceiling Height This Floor: 9ft

