

7/15/21

Gordon Variation


Handwritten notes in a cloud shape: "Handwritten notes in a cloud shape"

Handwritten note: "Handwritten note"

Handwritten notes in a cloud shape: "Handwritten notes in a cloud shape"

Handwritten note: "Handwritten note"

Handwritten note: "Handwritten note"

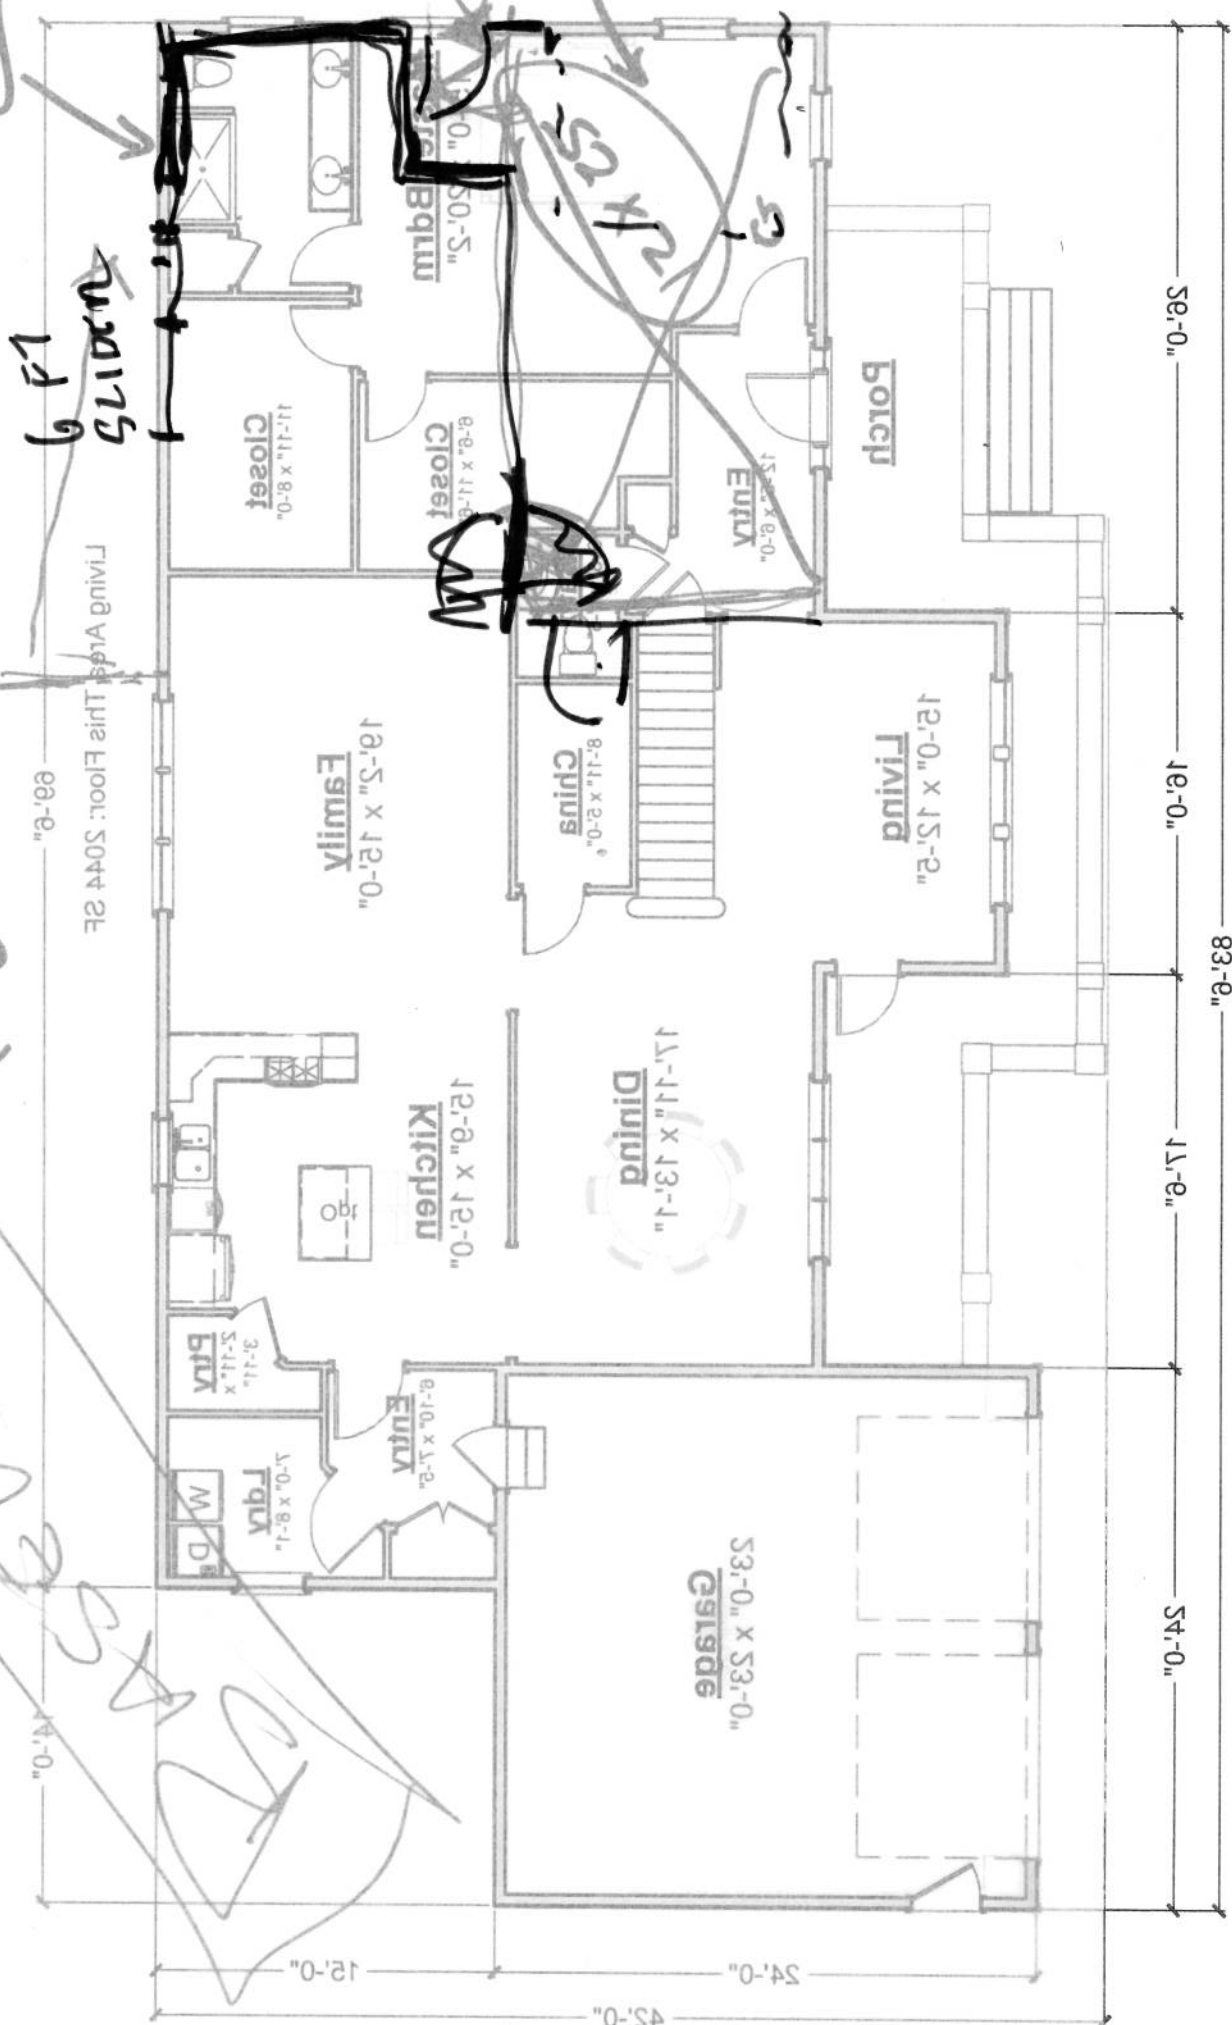

© 2014 Wendy Welter, all rights reserved. You may not build this design without purchasing a license, even if you make changes. This design may have geographic restrictions.

Prelim / Work in Progress 003-431-0220

Wendy Welter Home Plans