

105.003 Moira Ahoy

First Floor

	Area	Beds	Baths
Main	1352 SF	1	1.5
Future	0 SF	0	0
Apt	0 SF	0	0
Total	1352 SF	1	1.5


Ceiling Height
Shown 8'-0"
Possible* 8'-0"

* See Major Change information on plan page for cost

Let 4 Rock
garage
x 1.10
left

ADD
DOOR

Artform Home Plans

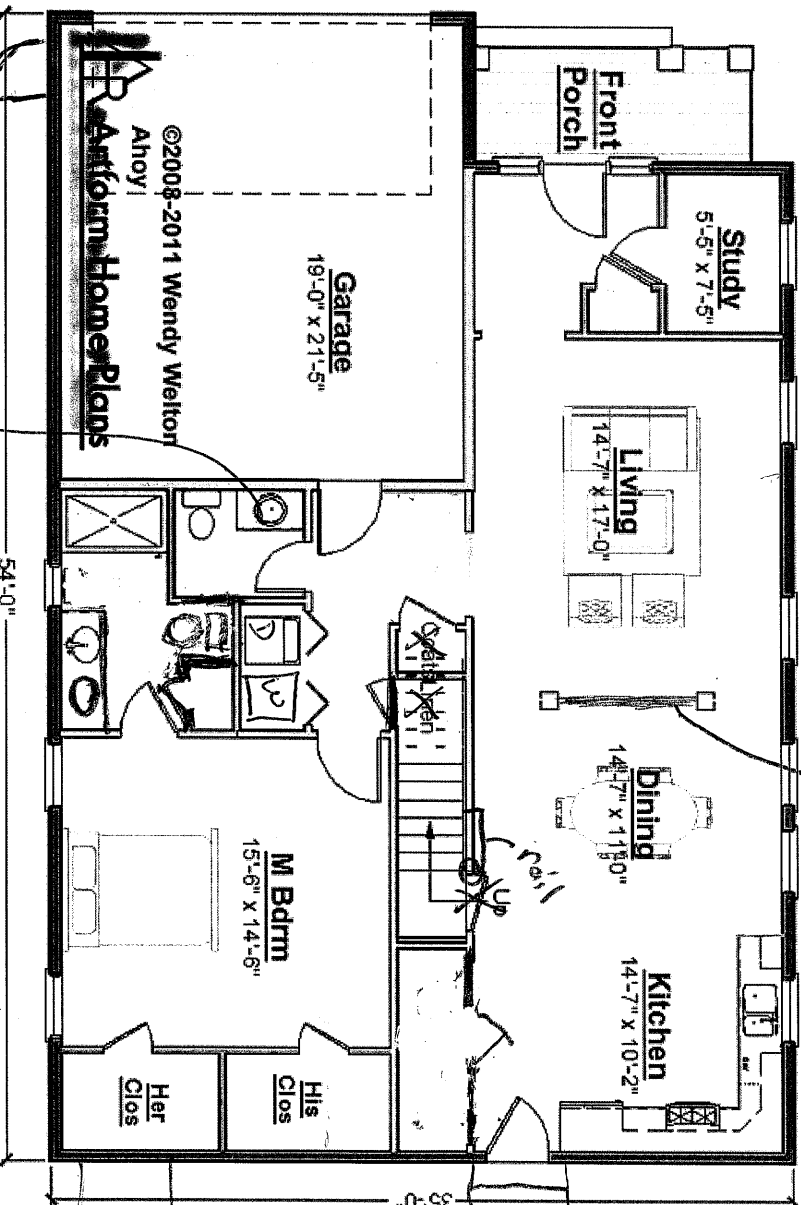

Use of this document is governed by our Terms and Conditions, found on our website:
<http://www.artformhomeplans.com/TermsConditions.a5w>

© 2008 Art Form Architecture, Inc. ALL RIGHTS RESERVED.
You may not build this Design without purchasing a License to Build (as defined in our Terms). Unauthorized changes are not permitted and violate copyright laws, which provide substantial penalties for infringement.

Some features show are optional. Your Purchase & Sale Agreement governs, whether items are labeled "optional" in this document or not.
We are not responsible for typographical errors.

Steps to patio
Bullhead


PEDASTAL

105.003 Moira Ahoy

Second Floor

Area	Beds	Baths
Main	2	1
Future	0 SF	0
Apt	0 SF	0
Total	700 SF	2
Ceiling Height		
Shown	8'-0"	
Possible *	8'-0"	

* See Major Change information on plan page for cost

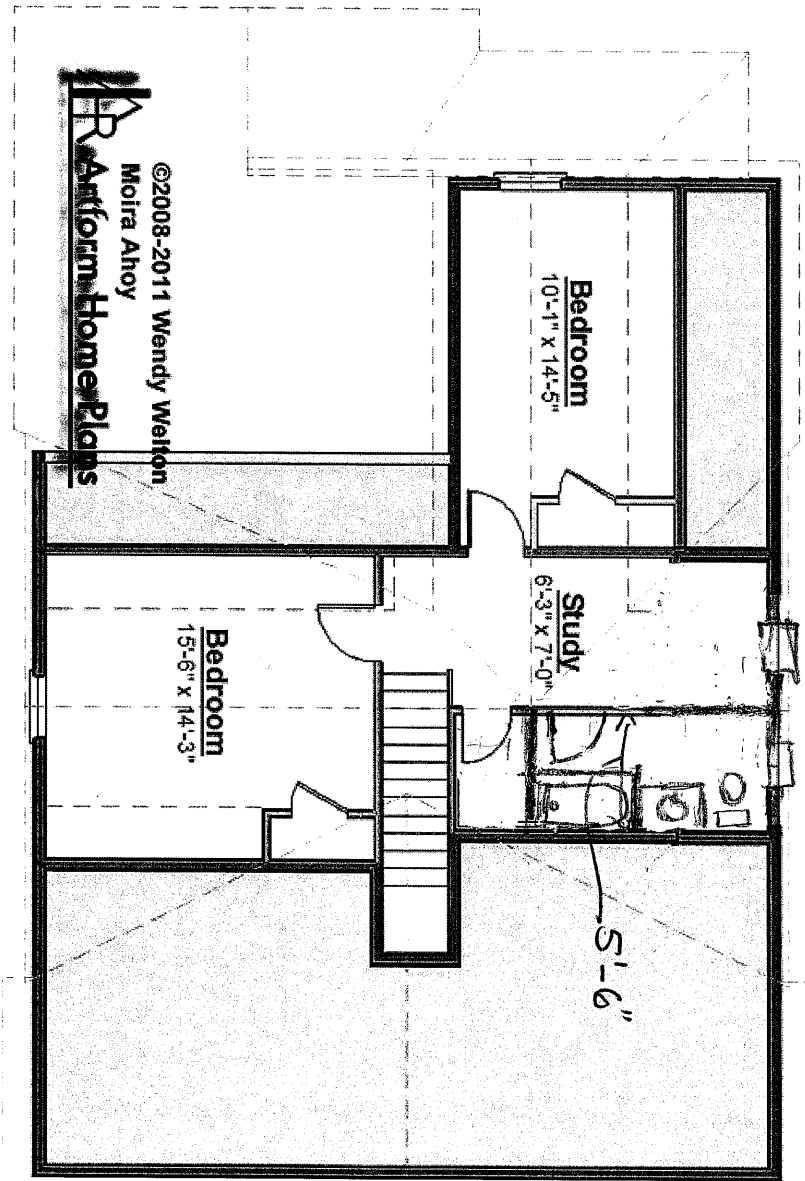

Use of this document is governed by our **Terms and Conditions**, found on our website:
<http://www.artformhomeplans.com/TermsConditions.a5w>

© 2008 Art Form Architecture, Inc. ALL RIGHTS RESERVED.
You may not build this Design without purchasing a License to Build (as defined in our Terms). Unauthorized changes are not permitted and violate copyright laws, which provide substantial penalties for infringement.

Artform Home Plans

Some features show are optional. Your Purchase & Sale Agreement governs, whether items are labeled "optional" in this document or not.

We are not responsible for typographical errors.