


Merlot Cottage

989.124



Prelim / Work in Progress 603-431-9559

© Art Form Architecture, Inc., all rights reserved. You may not build this design without purchasing a license, even if you make changes. This design may have geographic restrictions.

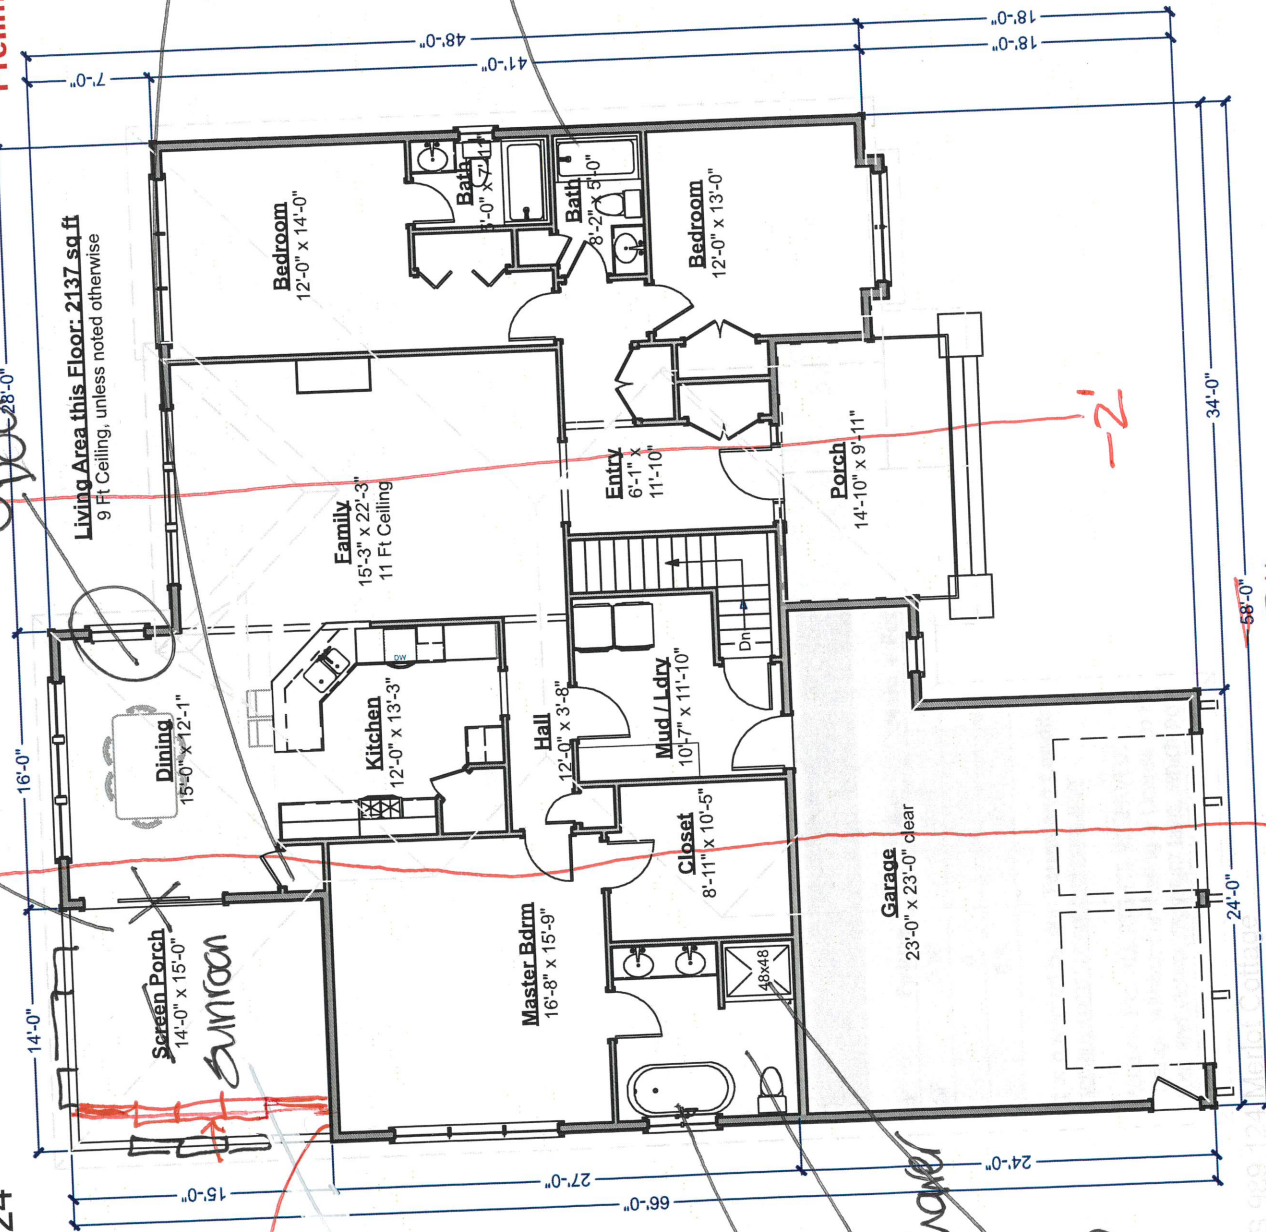

CRS 989.124