
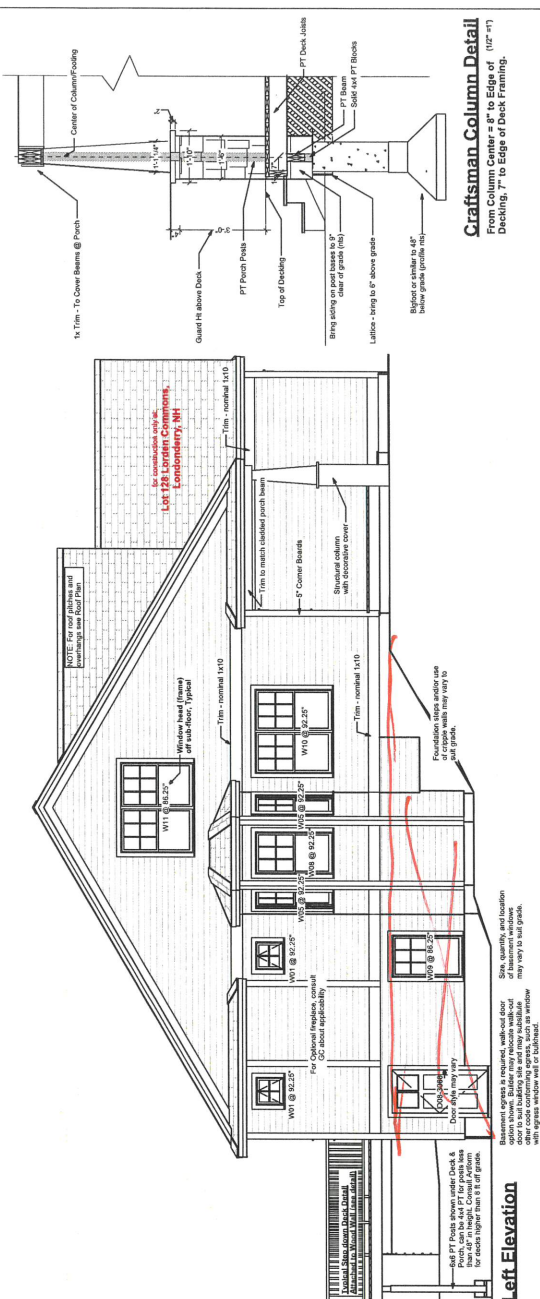
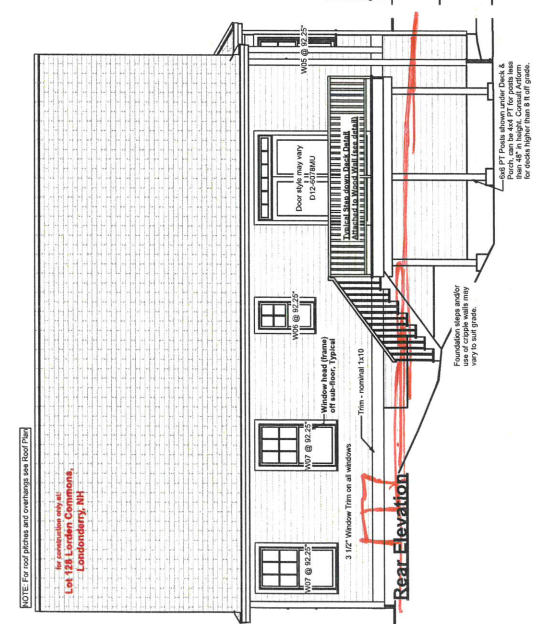
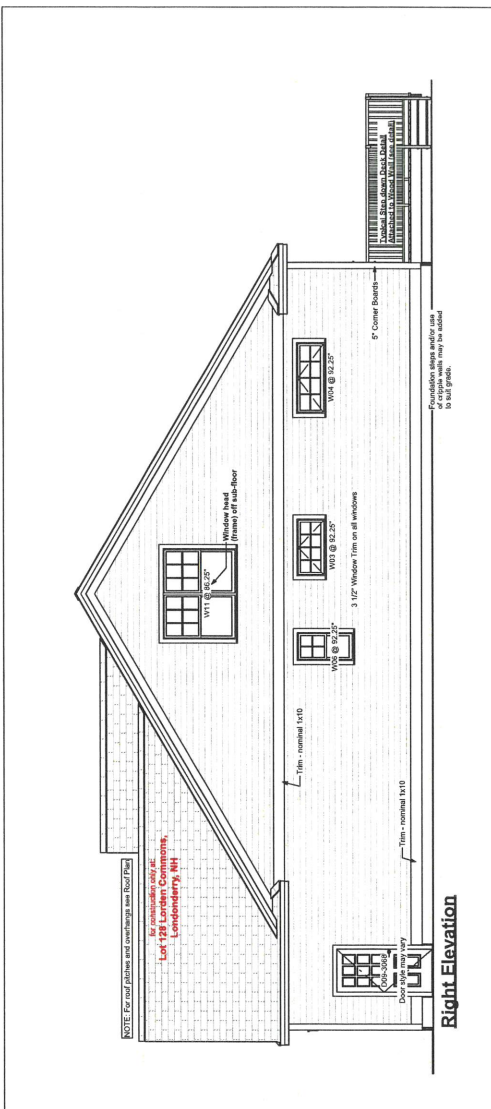


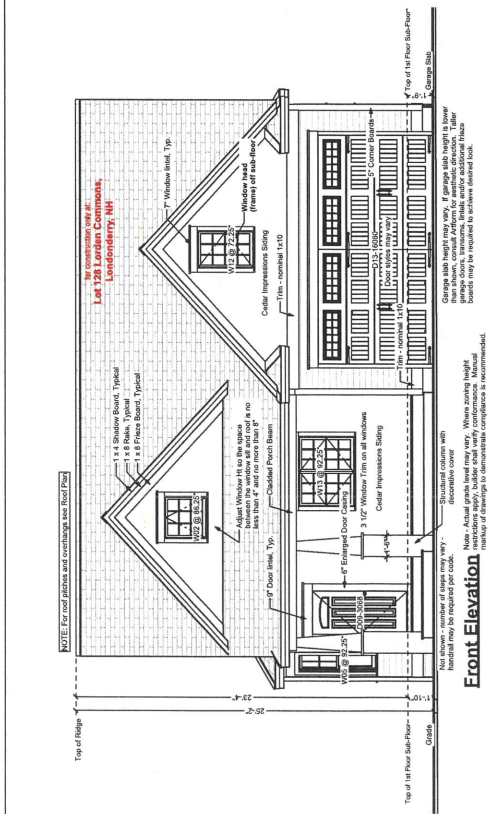

Notes:

- 1. All dimensions are to the centerline of the structure unless otherwise noted.
- 2. All dimensions are to the centerline of the structure unless otherwise noted.
- 3. All dimensions are to the centerline of the structure unless otherwise noted.
- 4. All dimensions are to the centerline of the structure unless otherwise noted.

Project Name	Project Number	Project Date
128 Landon Commons	128	12/20/2020

Project Name	Project Number	Project Date
128 Landon Commons	128	12/20/2020

Craftsman Column Detail
From Column Center 2" to Edge of Decking, 7" to Edge of Deck Framing.