


Shelby

357.120.v4 GL (10/2/2020)

© 2013-2020 for Form Architecture, Inc. All rights reserved.
No part of this document may be reproduced without written permission.

ne Plans

603-431-9559

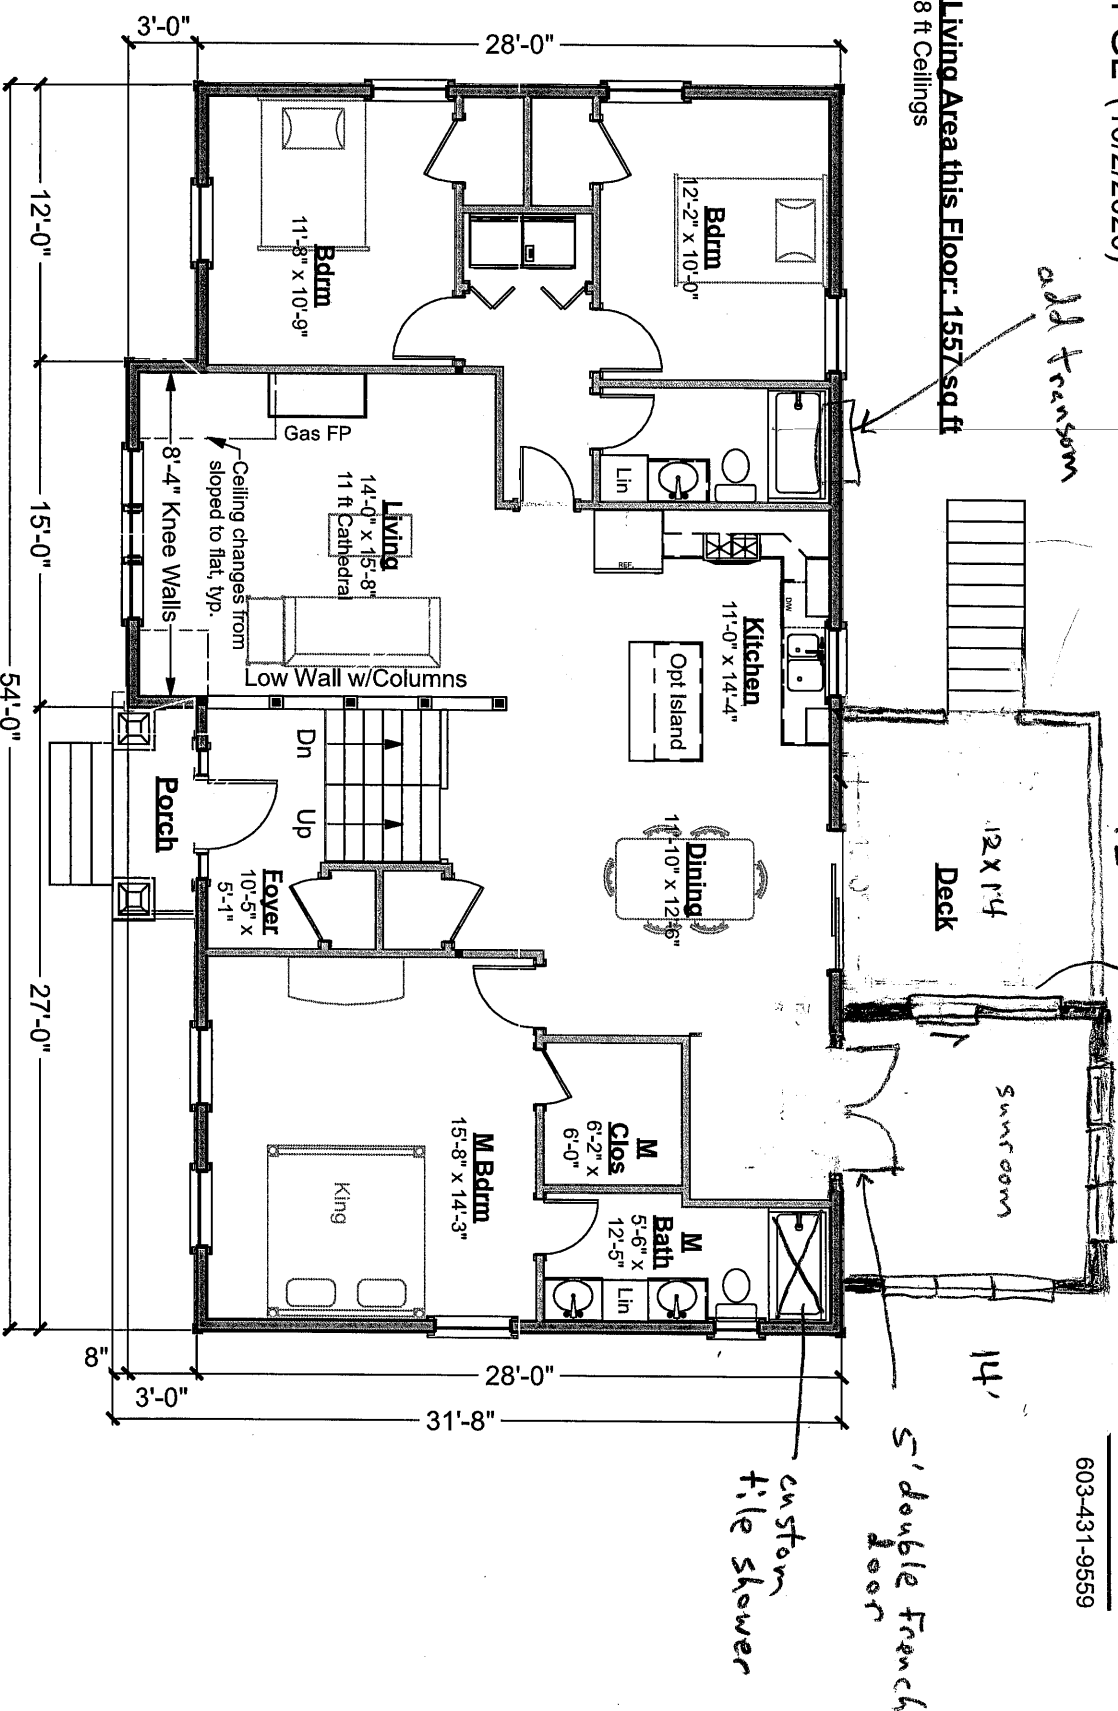

First Floor Plan

Scale: 1/8" = 1'-0"

Shelby Basement Plan

6 slider

