




single transom centered

add 2ft

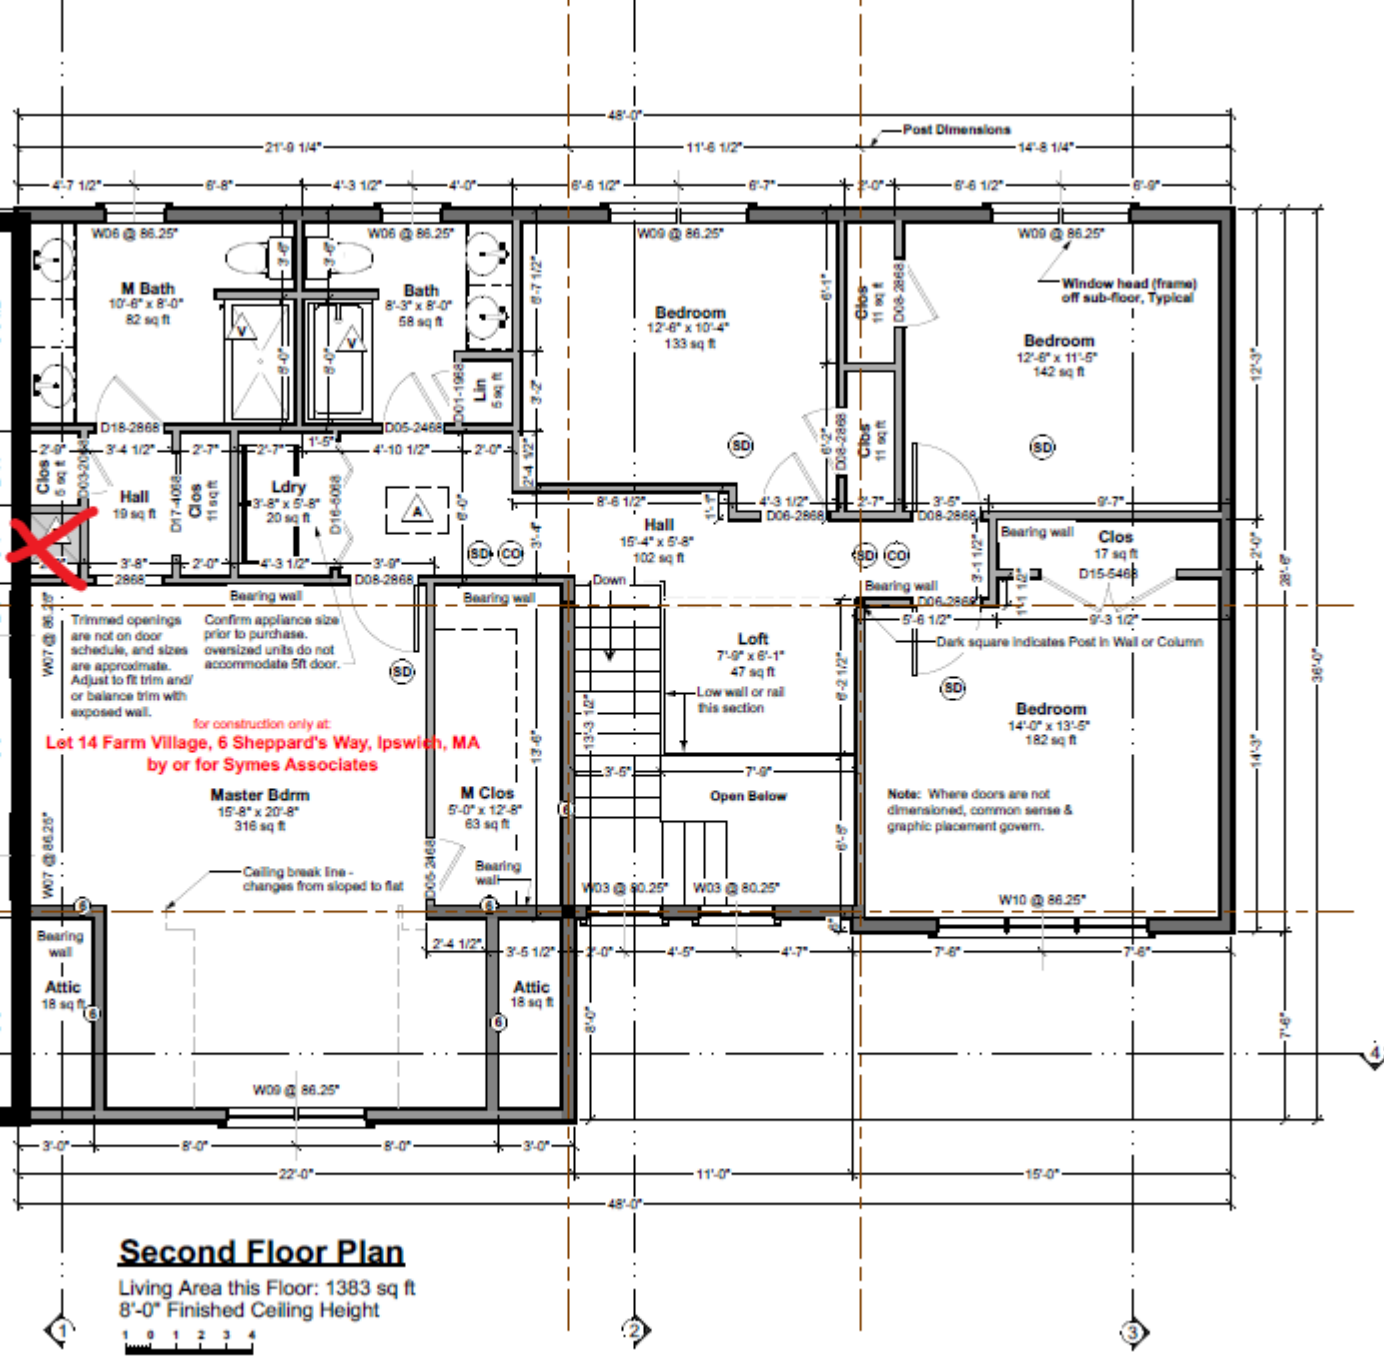

2ft to garage and house

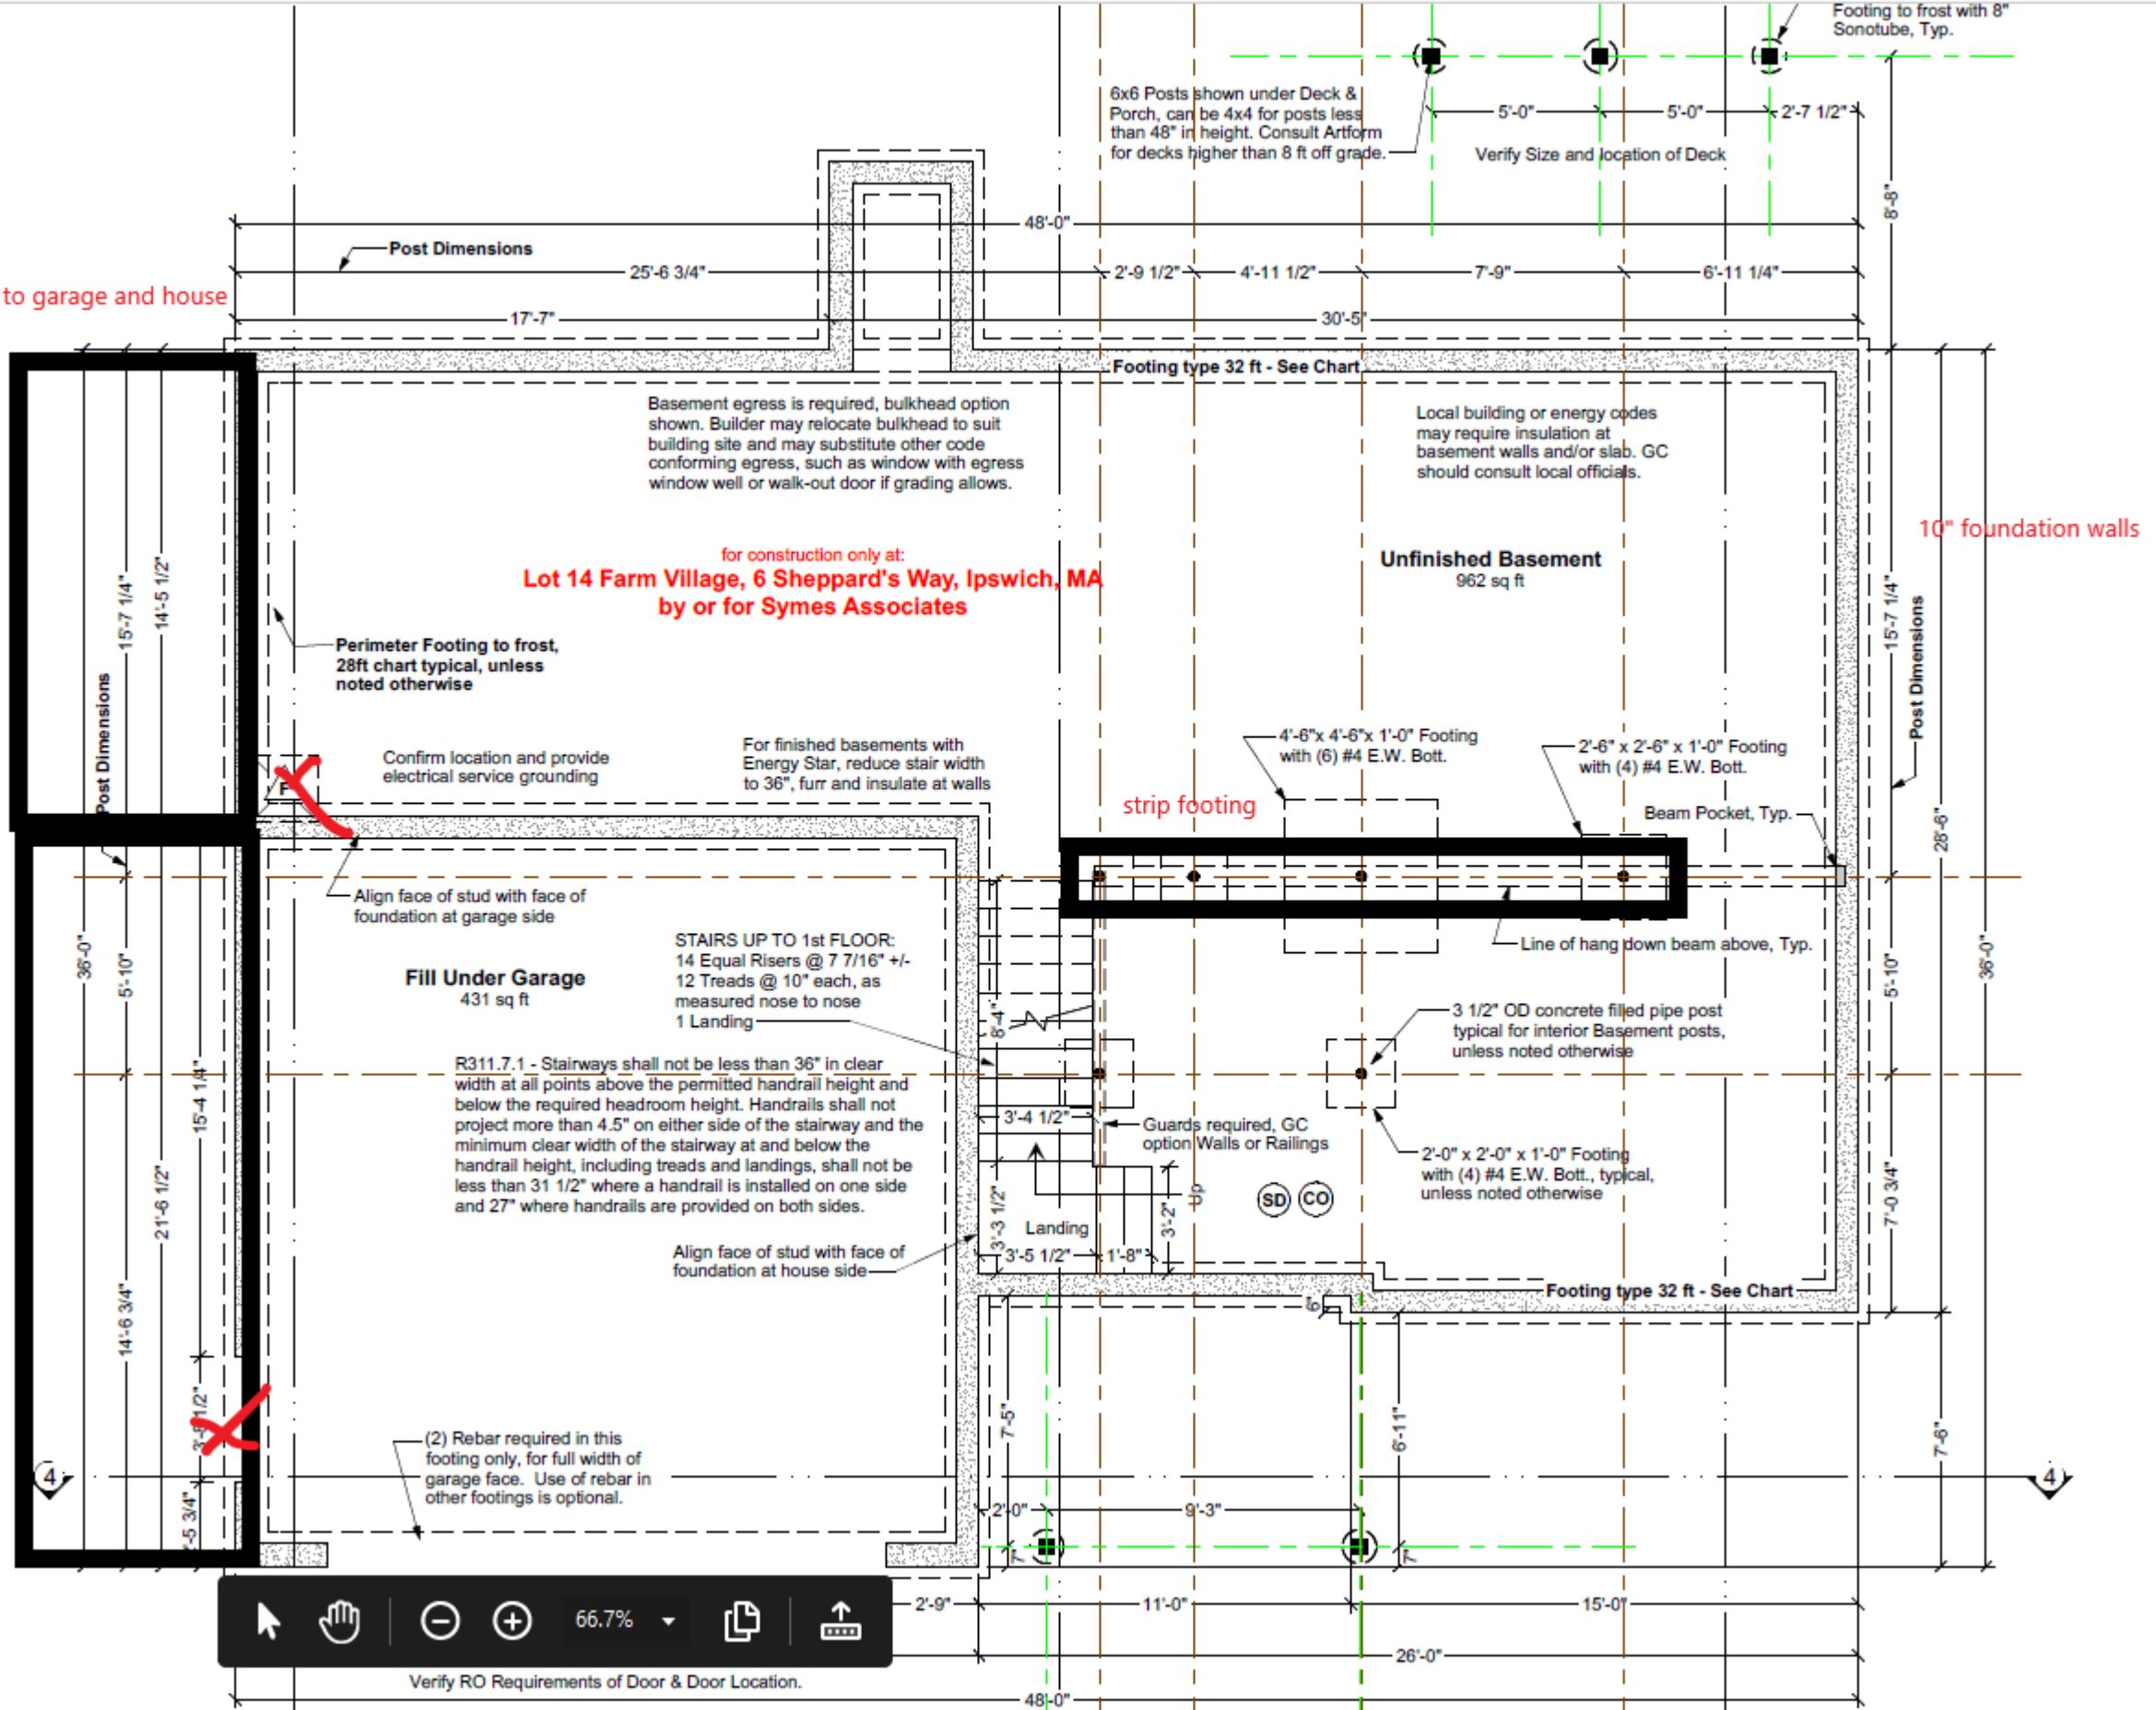

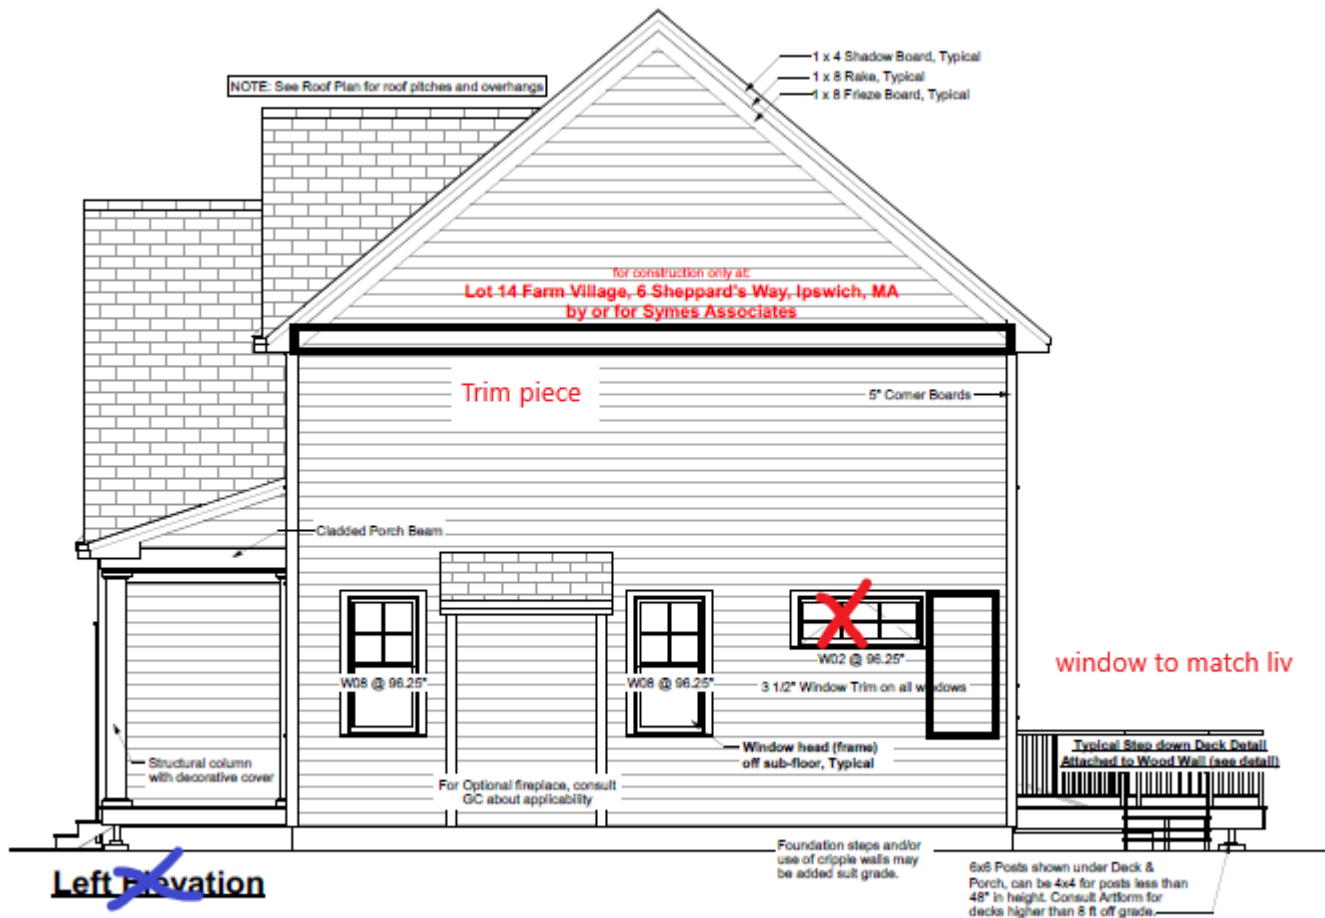

Right