

(5)

Lot 95 Laderen

Sir Isaac Newton

627.124.v9 GR (6/19/2020)

© 2017-2020 Art Form Architecture, Inc., all rights reserved .
You may not build this design without purchasing a license,
even if you make changes. This design may have geographic
restrictions.



Artform Home Plans

603-431-9559

Some items shown are optional and/
or may vary. Builder's written
specifications always govern.

1. Gas fireplace and it's surround or mantel
2. Kitchen - island, cabinet style & trim, countertop material, etc.
3. Door styles and trim
4. Window grilles and trim, window treatments
5. Stair balusters or low walls at stairs
6. Lighting
7. Material selections (flooring, siding, roofing, paint colors, etc.)
8. Other furnishings
9. Landscaping, paving and walkways
10. Gutters, shutters and other exterior trim components
11. Deck size, railing style, stair location, etc.
12. Amount of exposed basement and/or wood framed walls at basement.

These images are not of any specific building site. Sun and view through windows will vary, as will the site around the house on the exterior and the slope of the land.

Sir Isaac Newton

627.124.v9 GR (6/19/2020)

© 2017-2020 Art Form Architecture, Inc., all rights reserved.
You may not build this design without purchasing a license,
even if you make changes. This design may have geographic
restrictions.



603-431-9559




Sir Isaac Newton

627.124.v9 GR (6/19/2020)

© 2017-2020 Art Form Architecture, Inc., all rights reserved.
You may not build this design without purchasing a license,
even if you make changes. This design may have geographic
restrictions.

Artform Home Plans

603-431-9559

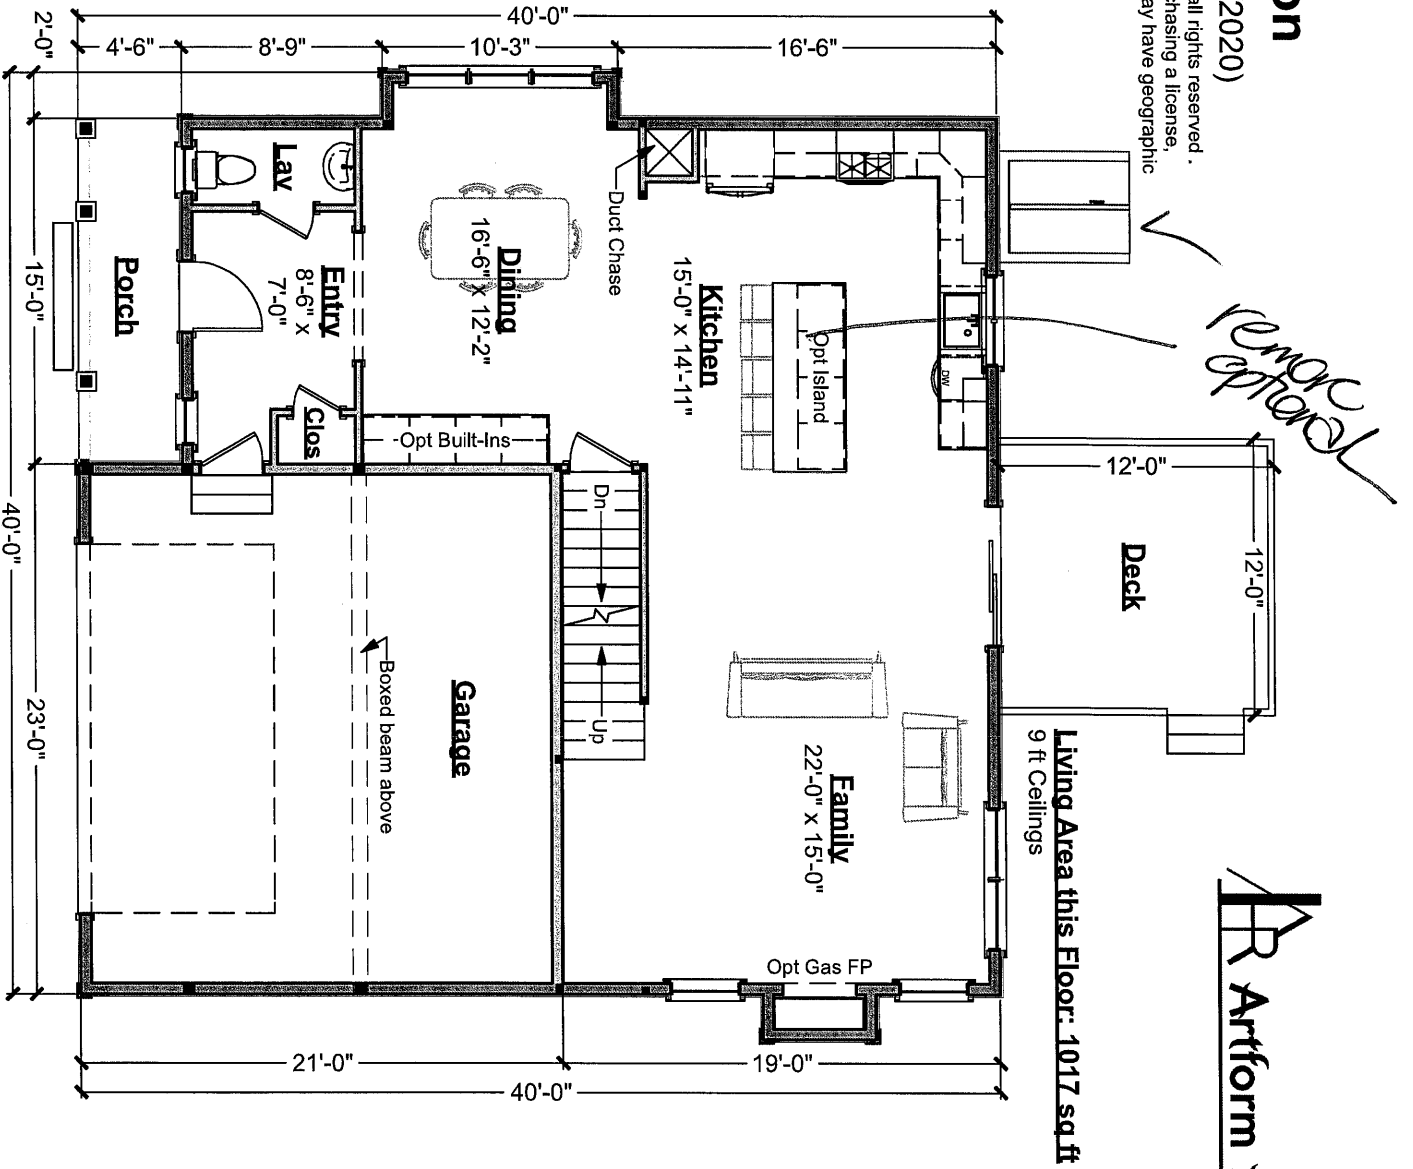

First Floor Plan 2'-0"

Garage Right

Sir Isaac Newton


627.124.v9 GR (6/19/2020)

© 2017-2020 Art Form Architecture, Inc., all rights reserved.
You may not build this design without purchasing a license,
even if you make changes. This design may have geographic
restrictions.

 Artform Home Plans

603-431-9559

Living Area this Floor: 1388 sq. ft.
8 ft Ceilings

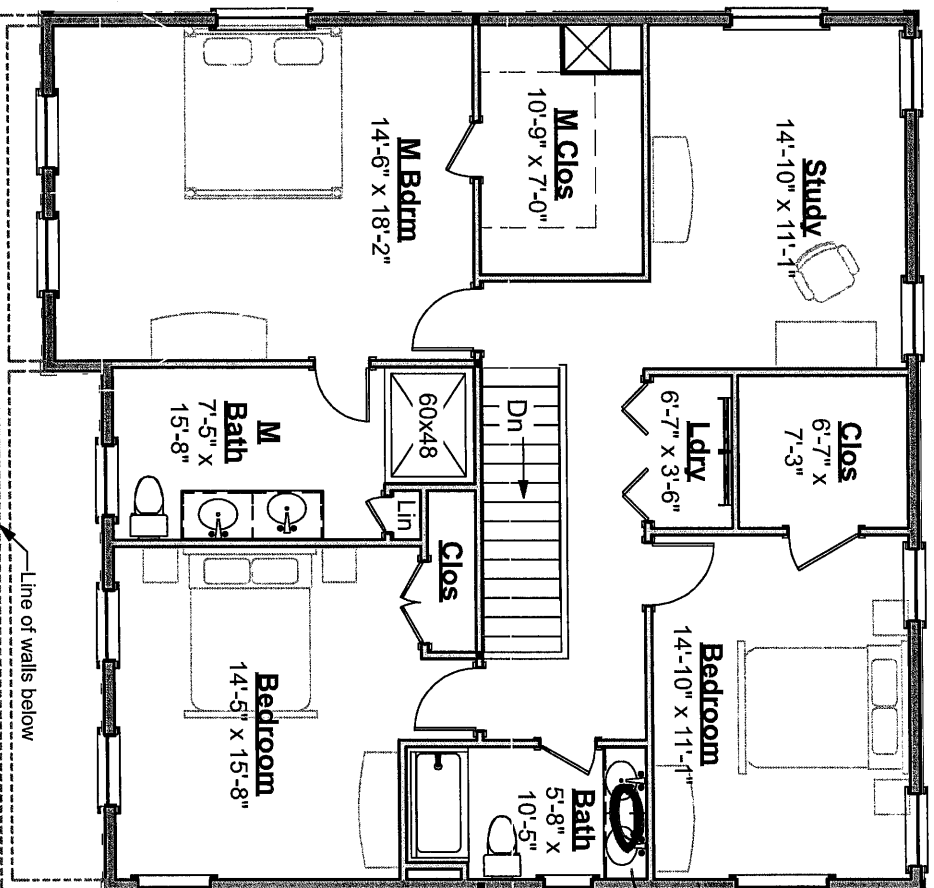

leaves
double please


Second Floor Plan

Sir Isaac Newton

627.124.v9 GR (6/19/2020)

© 2017-2020 Art Form Architecture, Inc., all rights reserved.
You may not build this design without purchasing a license,
even if you make changes. This design may have geographic
restrictions.

*Bulkhead
Corkboard*

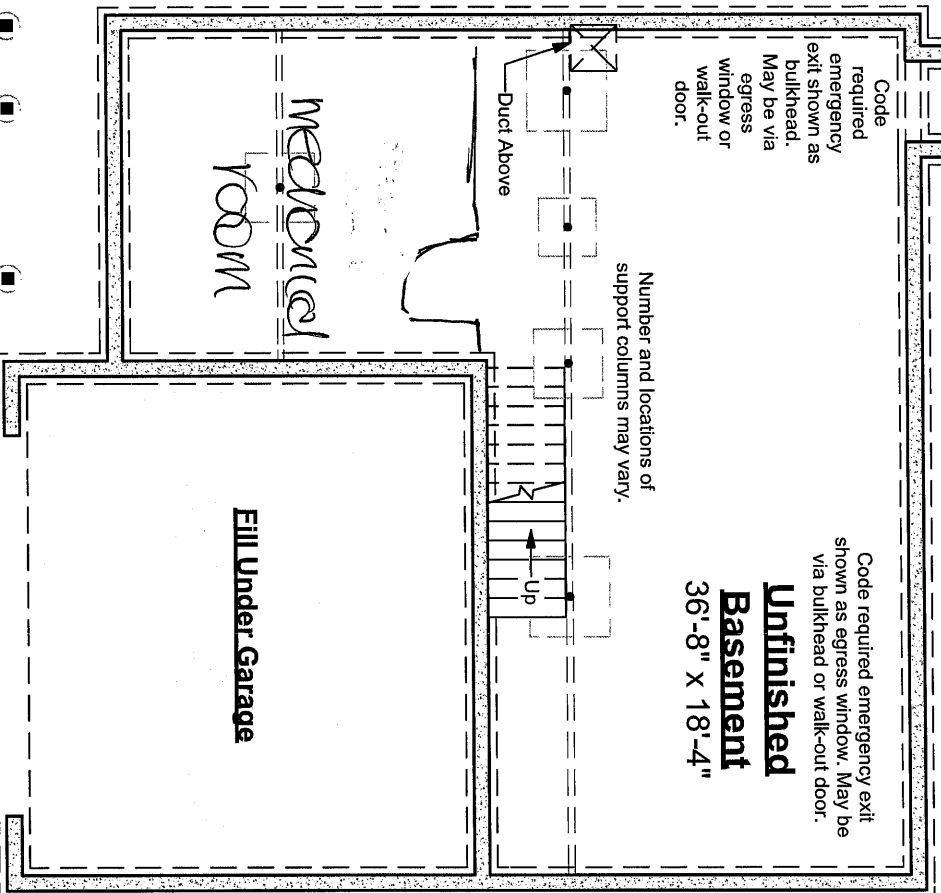

Foundation Plan


Sir Isaac Newton

627.124.v9 GR (6/19/2020)

© 2017-2020 Art Form Architecture, Inc., all rights reserved .
You may not build this design without purchasing a license,
even if you make changes. This design may have geographic
restrictions.



603-431-9559

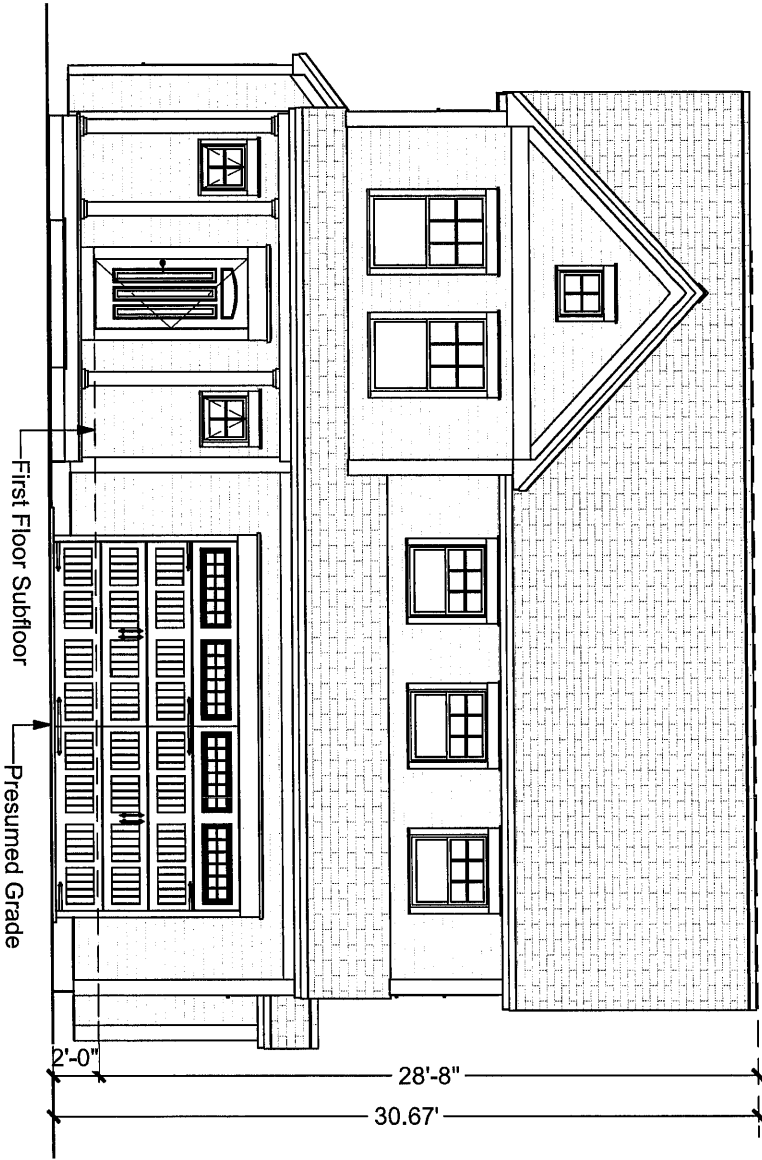

Front Elevation


Sir Isaac Newton

627.124.v9 GR (6/19/2020)

© 2017-2020 Art Form Architecture, Inc., all rights reserved .
You may not build this design without purchasing a license,
even if you make changes. This design may have geographic
restrictions.



603-431-9559

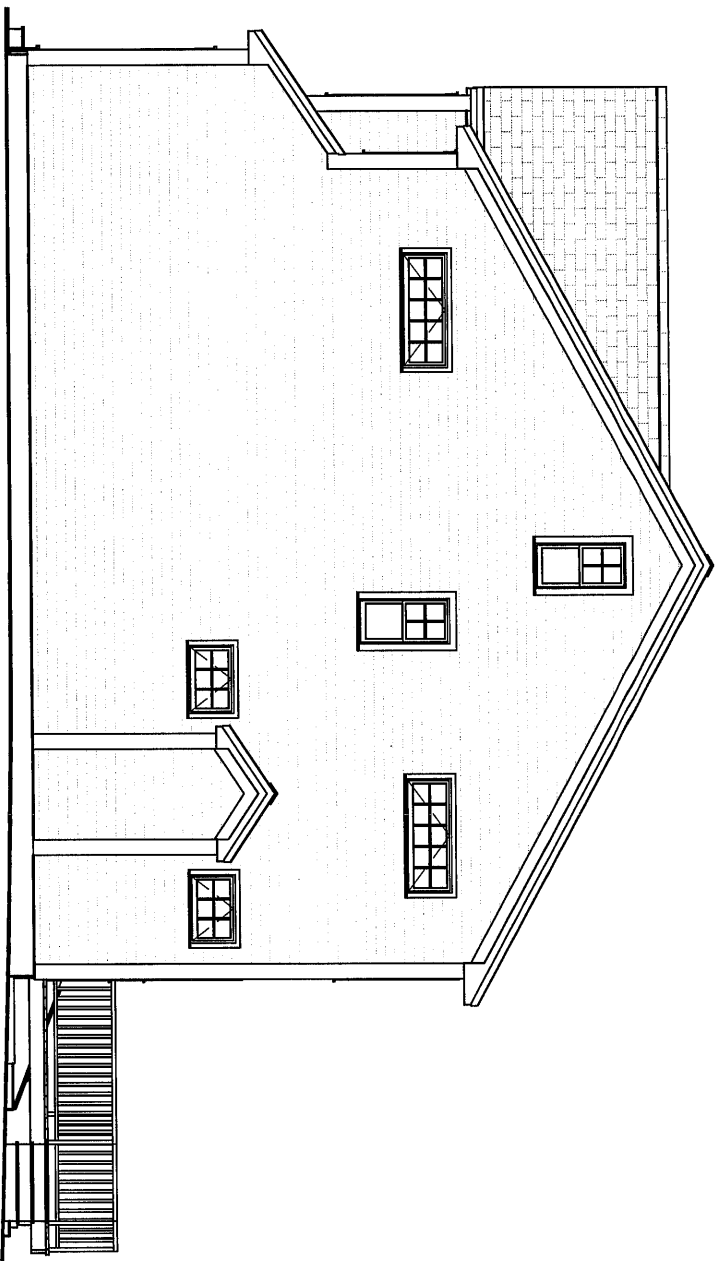


Right Elevation


Sir Isaac Newton

627.124.V9 GR (6/19/2020)

© 2017-2020 Art Form Architecture, Inc., all rights reserved.
You may not build this design without purchasing a license,
even if you make changes. This design may have geographic
restrictions.

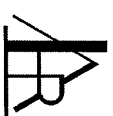 **Artform Home Plans**

603-431-9559

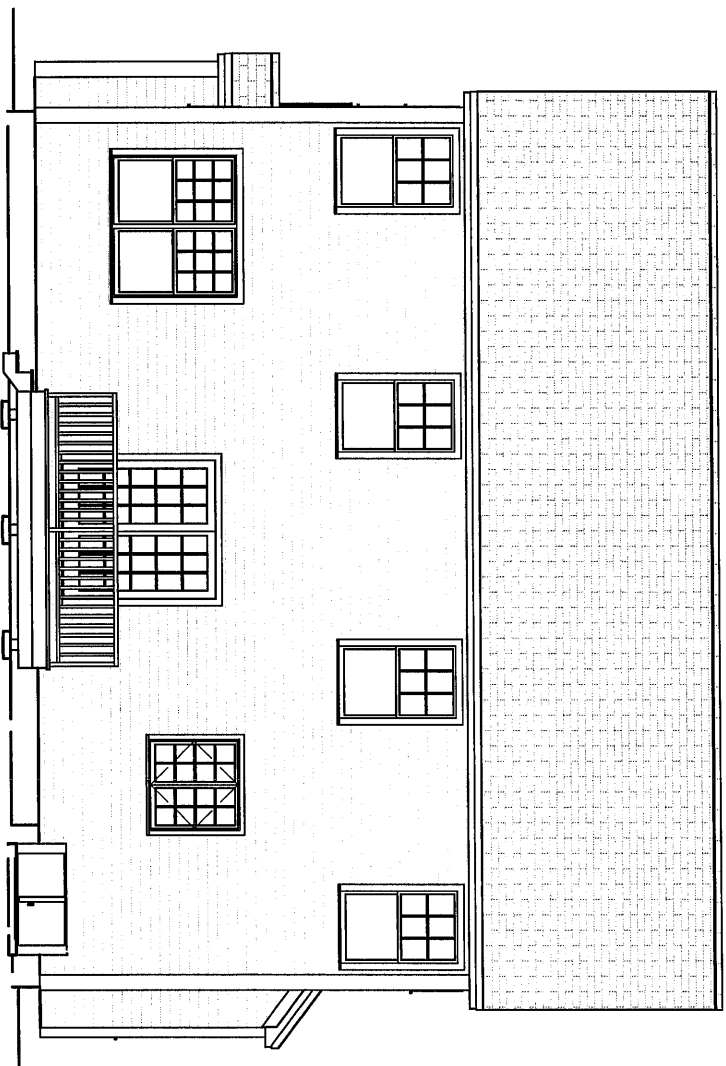

Rear Elevation


Sir Isaac Newton

627.124.v9 GR (6/19/2020)

© 2017-2020 Art Form Architecture, Inc., all rights reserved .
You may not build this design without purchasing a license,
even if you make changes. This design may have geographic
restrictions.



603-431-9559

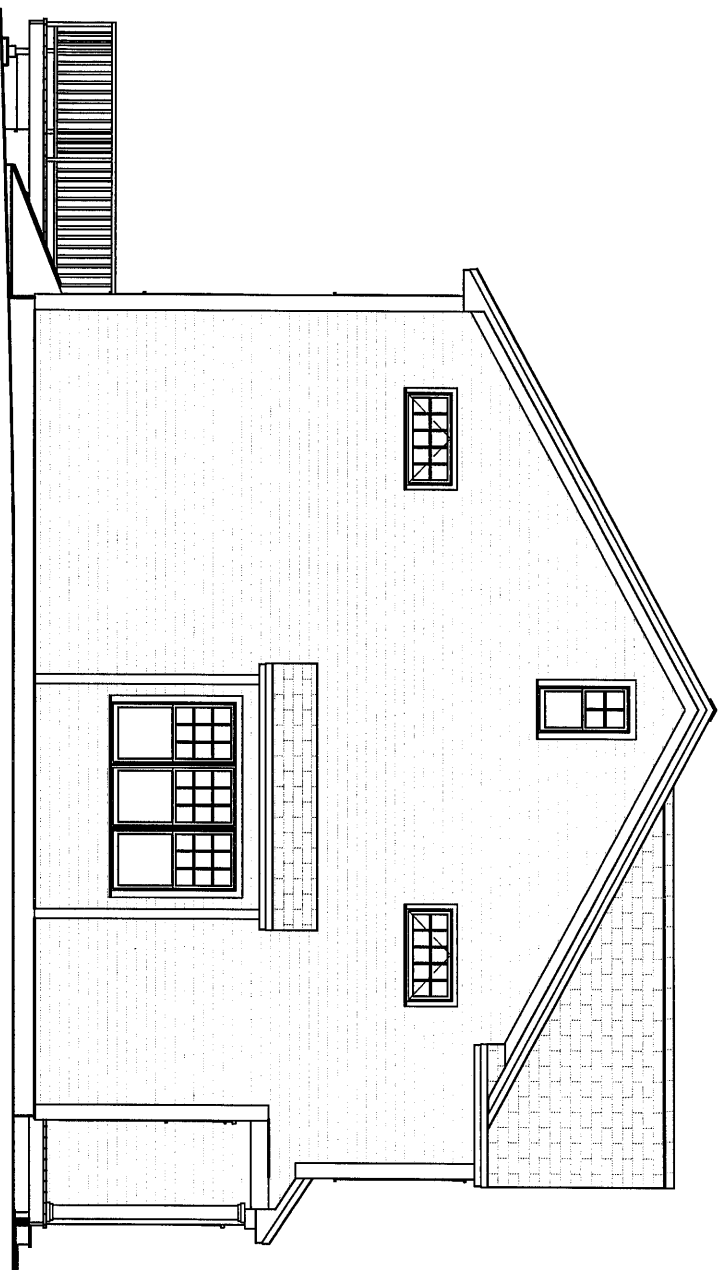

Left Elevation