


Lot 20 Hobbs




©2012 Wendy Welton
Spencer

Artform Home Plans

First Floor

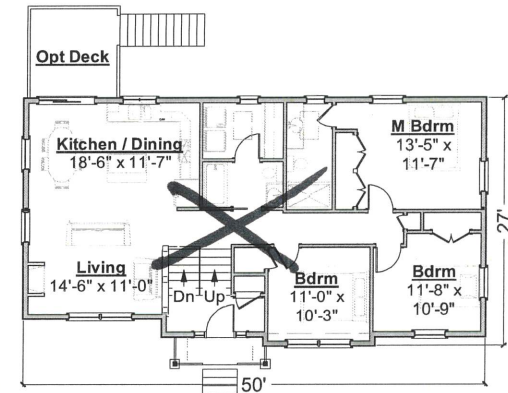

Lower Level

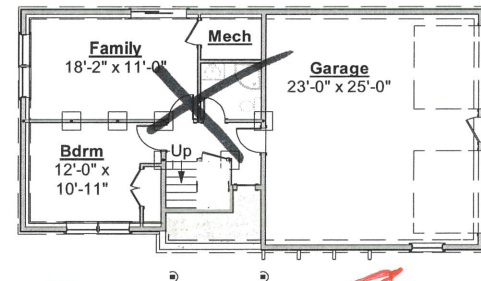

FLIP
Garage Left

PAUL HERRICK Group

500 Cummings Center, Suite 1550
Beverly, MA 01915

Office: 978.927.1959
Direct: 978.979.7900
Fax: 978.927.4944

KW

KELLER WILLIAMS
REALTY

Spencer

356.007

© 2012 Wendy Welton, all rights reserved.

You may not build this design without purchasing a license, even if you make changes. This design may have geographic restrictions. Contact the Builder or RE Agent at left or call Artform Home Plans at 603-431-9559.

	Base Above Grade
Living Area	1848
Bedroom	4
Baths	3

Some items optional or designer's vision. Builder's written specifications always govern. Dimensions supercede Square Foot data.


Spencer
356.007

© 2012 Wendy Welton, all rights reserved. You may not build this design without purchasing a license, even with changes. Some Artform designs have geographic restrictions. Contact the Builder or RE Agent or call Artform at 603-431-9559

 **Artform Home Plans**

Paul J. Herrick 978-927-1959

First Floor

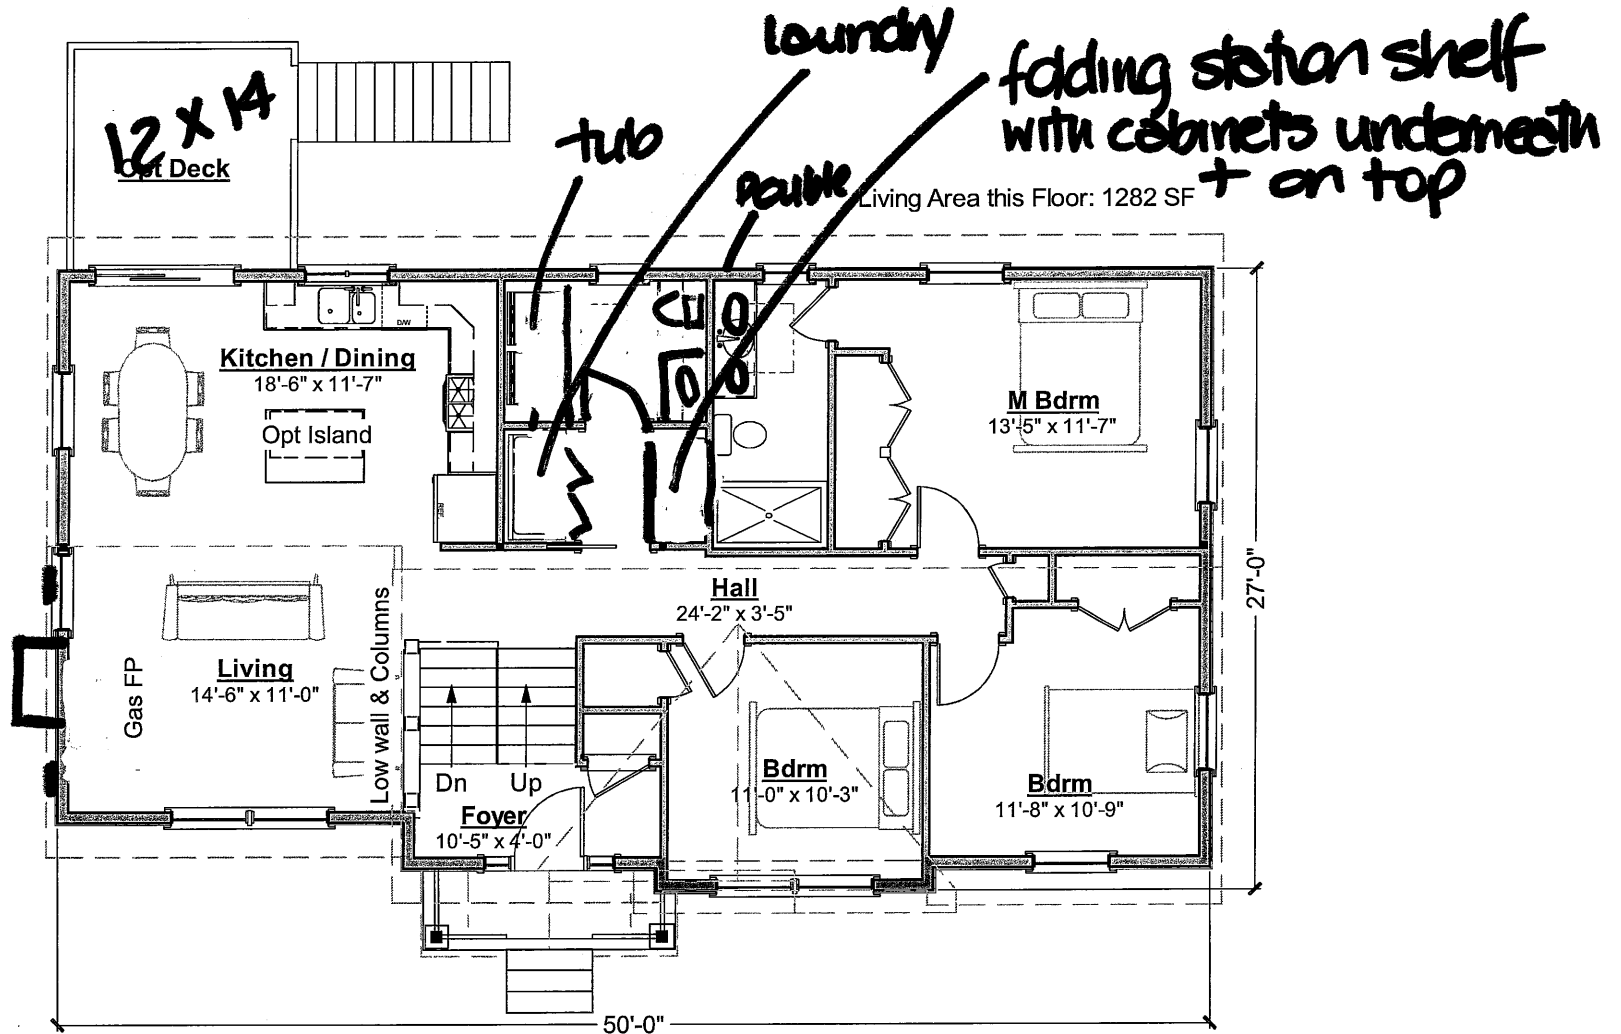


Spencer 356.007

© 2012 Wendy Welton, all rights reserved. You may not build this design without purchasing a license, even with changes. Some Artform designs have geographic restrictions. Contact the Builder or RE Agent or call Artform at 603-431-9559



Paul J. Herrick 978-927-1959

Lower Level

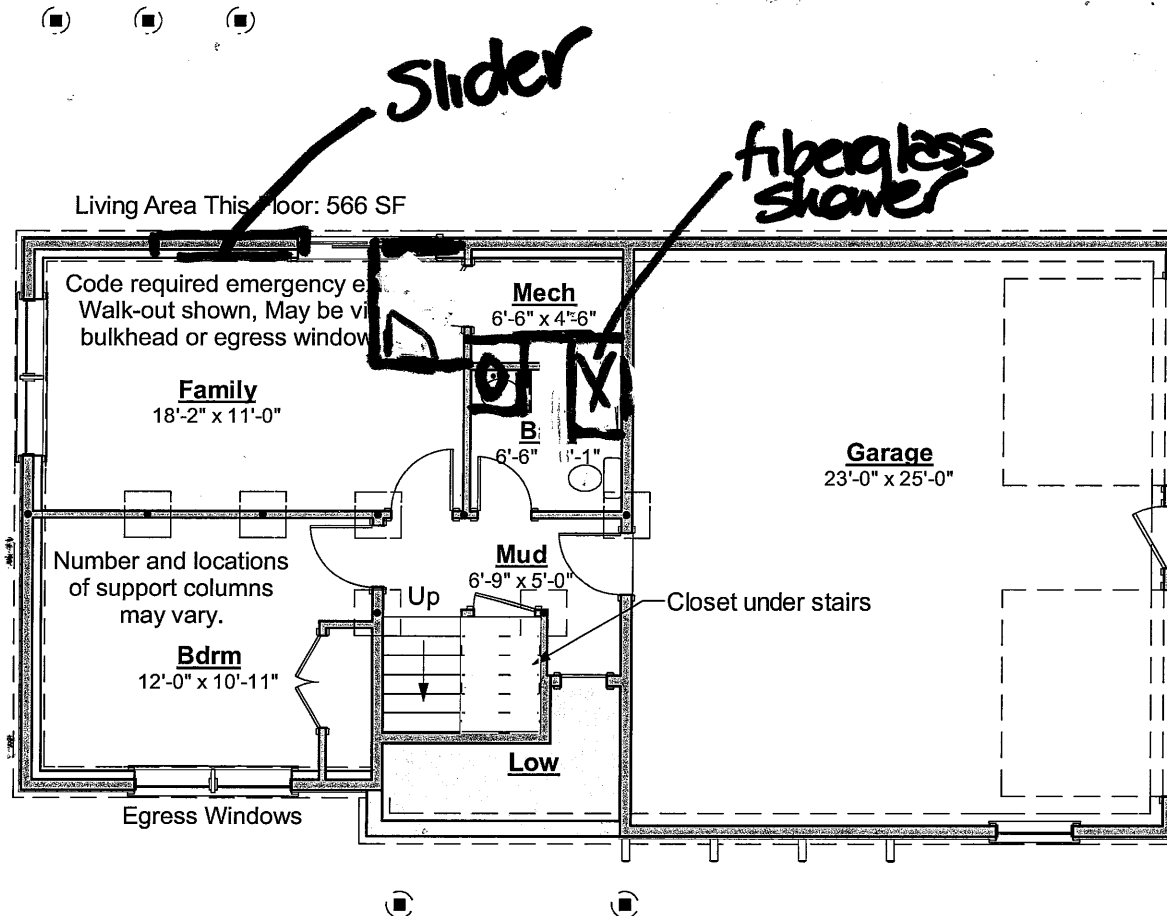

Spencer

356.007

© 2012 Wendy Welton, all rights reserved. You may not build this design without purchasing a license, even with changes. Some Artform designs have geographic restrictions. Contact the Builder or RE Agent or call Artform at 603-431-9559



Paul J. Herrick 978-927-1959



Builder's written specifications always govern. Some items shown are optional or may vary, including but not limited to:

- Gas fireplace and surround
- Kitchen - island, cabinet style & trim, counter material, etc.
- Bath – vanity size, number / style of sinks, tub or shower...
- Other built-ins.
- Door styles and trim
- Window grilles and trim, window treatments
- Stair balusters or low walls at stairs
- Lighting
- Material selections (flooring, siding, roofing, paint colors...)
- Landscaping, paving and walkways
- Gutters, shutters and other exterior trim components
- Deck – size, railing style, stair location, etc.
- Amount of exposed basement and/or wood framed walls at basement.

These images are not of any specific building site. Sun and view through windows will vary, as will the site surrounding the house and the slope of the land.