

569.124.v3 Strawberry Shortcake




First Floor

	Area	Beds	Baths
Main	1308 SF	1	2
Future	0 SF	0	0
Apt	0 SF	0	0
Total	1308 SF	1	2

Ceiling Height

Shown	8'-0"
Possible*	8'-0"

* See Major Change information on plan page for cost

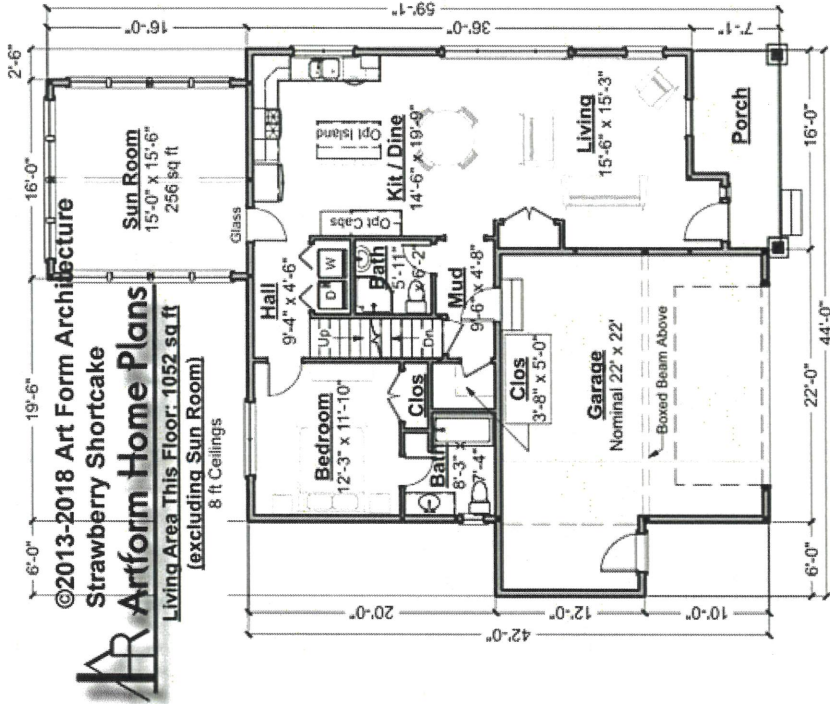

Use of this document is governed by our Terms and Conditions, found on our website: <http://www.artformhomeplans.com/TermsConditions.a5w>

© 2013 Art Form Architecture, Inc. ALL RIGHTS RESERVED.
You may not build this Design without purchasing a License to Build (as defined in our Terms). Unauthorized changes are not permitted and violate copyright laws, which provide substantial penalties for infringement.

Some features show are optional. Your Purchase & Sale Agreement governs, whether items are labeled "optional" in this document or not.

We are not responsible for typographical errors.

569.124.v3 Strawberry Shortcake



Second Floor


	Area	Beds	Baths
Main	1076 SF	3	2
Future	0 SF	0	0
Apt	0 SF	0	0
Total	1076 SF	3	2

Ceiling Height

Shown 9'-0"

Possible* 8'-0"

* See Major Change information on plan page for cost

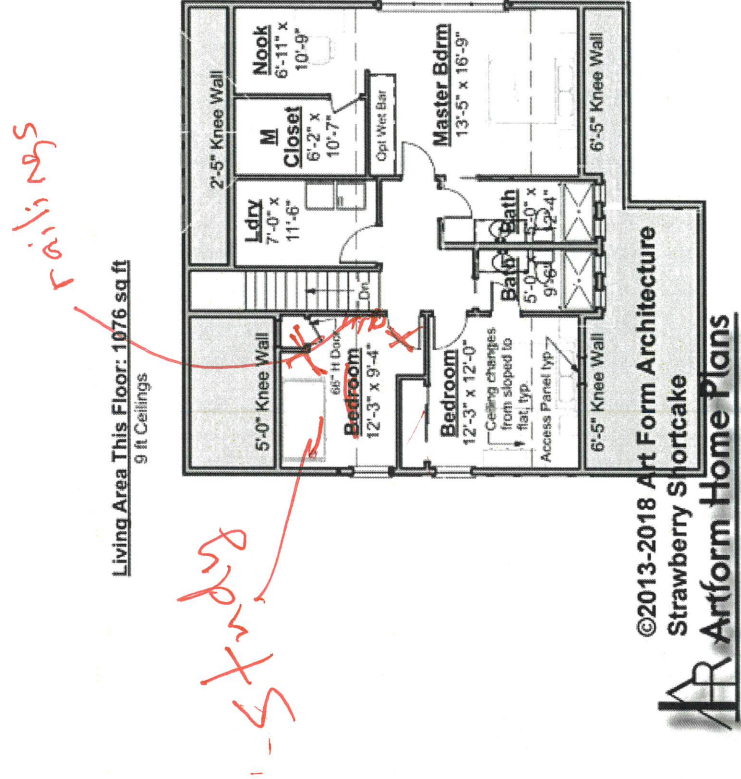

Use of this document is governed by our Terms and Conditions, found on our website:
<http://www.artformhomeplans.com/TermsConditions.a5w>

© 2013 Art Form Architecture, Inc. ALL RIGHTS RESERVED.
You may not build this Design without purchasing a License to Build (as defined in our Terms). Unauthorized changes are not permitted and violate copyright laws, which provide substantial penalties for infringement.

Some features show are optional. Your Purchase & Sale Agreement governs, whether items are labeled "optional" in this document or not.

We are not responsible for typographical errors.