

9/3/2019


Raspberry Biscotti

564.144.v32 KR (9/3/2019)

© 2013-2019 Art Form Architecture, Inc., all rights reserved .
You may not build this design without purchasing a license,
even if you make changes. This design may have geographic
restrictions.

Artform Home Plans
603-431-9559

Living Area First Floor: 1754 sq ft
8 ft Ceilings

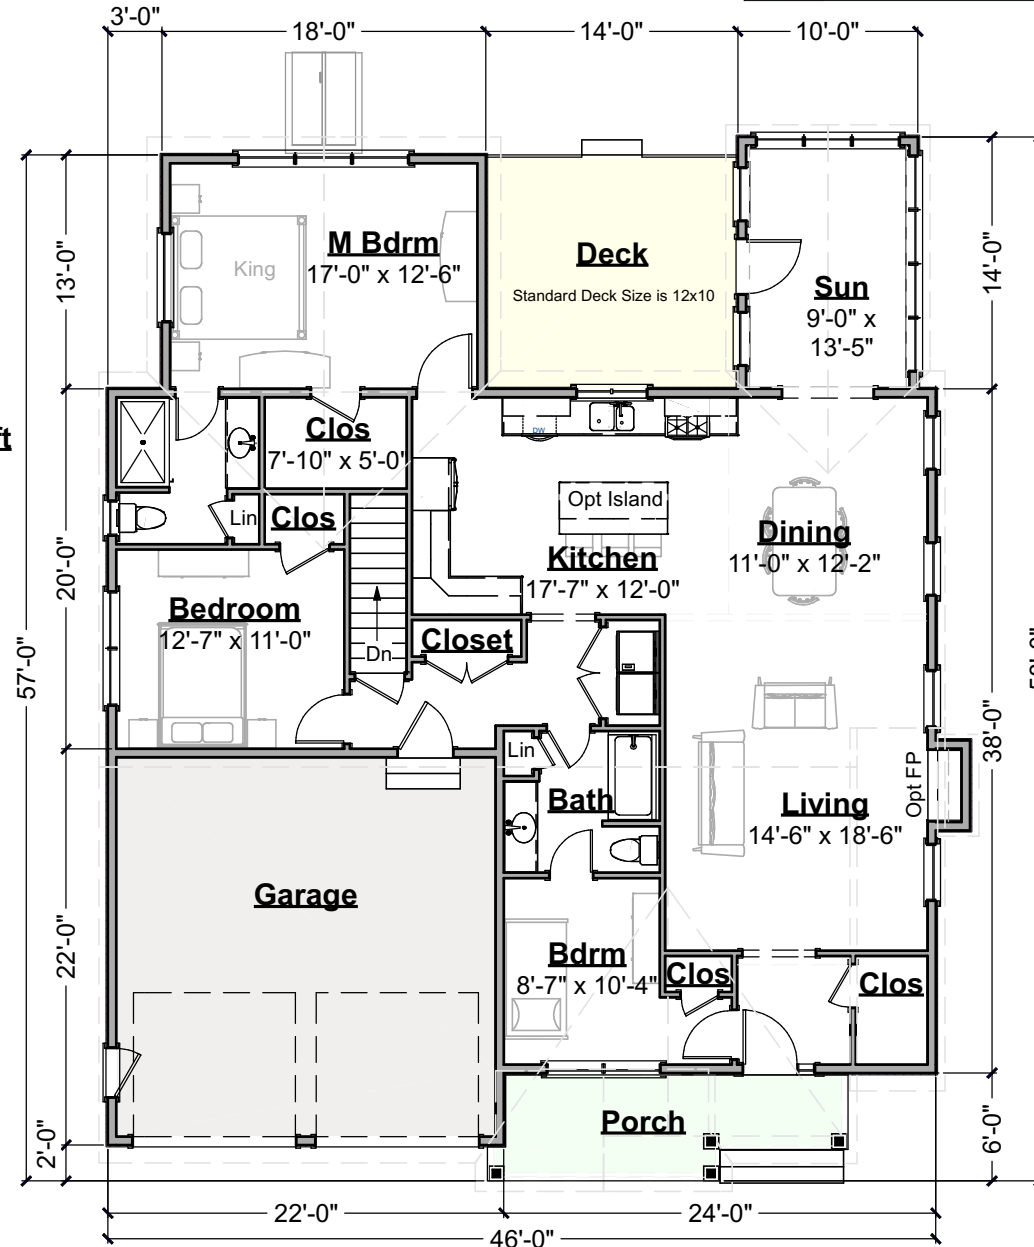

Remove bathroom door to
bathroom in front bedroom

Insert french doors between
dining and sunroom

Doghouse instead of
Bulkhead

Include Fireplace

First Floor Plan
Scale: 3/32" = 1'-0"

CRS 564.144.v32 KR Raspberry Biscotti