


Bally Kiss


554.126.v34 GR (9/16/2020)

© 2013-2020 Art Form Architecture, Inc., all rights reserved. You may not build this design without purchasing a license, even if you make changes. This design may have geographic restrictions.

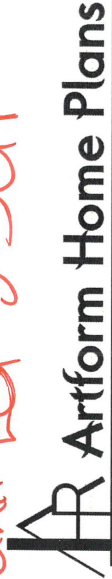

603-431-9559

Unit 3 SGP.

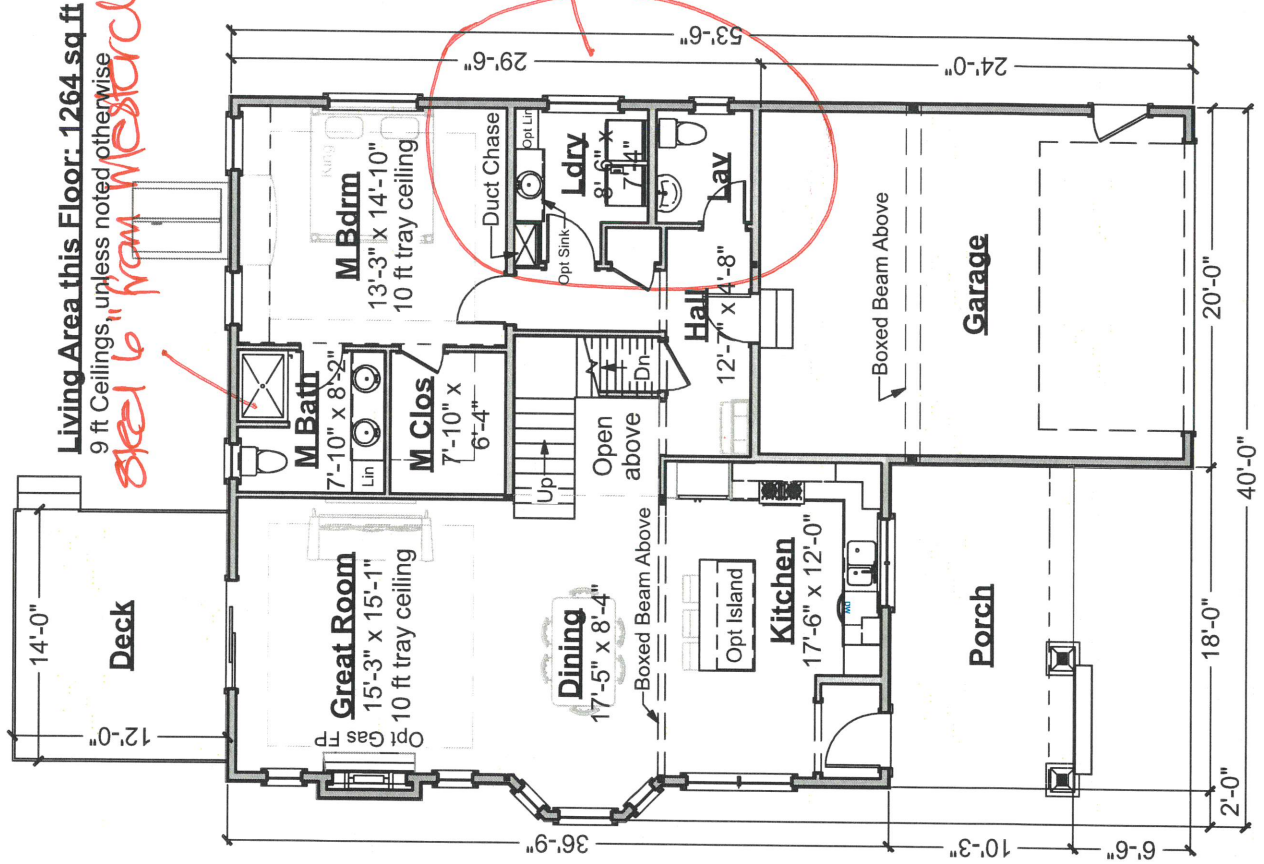

Living Area this Floor: 1264 sq ft
9 ft Ceilings, unless noted otherwise
steel 6" from West end of shower room.

Please configure to have W/D + Dog shower in Laundry room Will need to steel space from powder room and may need to use pocket doors and shrink windows.

First Floor Plan
Scale: 3/32" = 1'-0"


Bally Kiss

554.126.v34 GR (9/16/2020)

© 2013-2020 Art Form Architecture, Inc., all rights reserved. You may not build this design without purchasing a license, even if you make changes. This design may have geographic restrictions.



603-431-9559

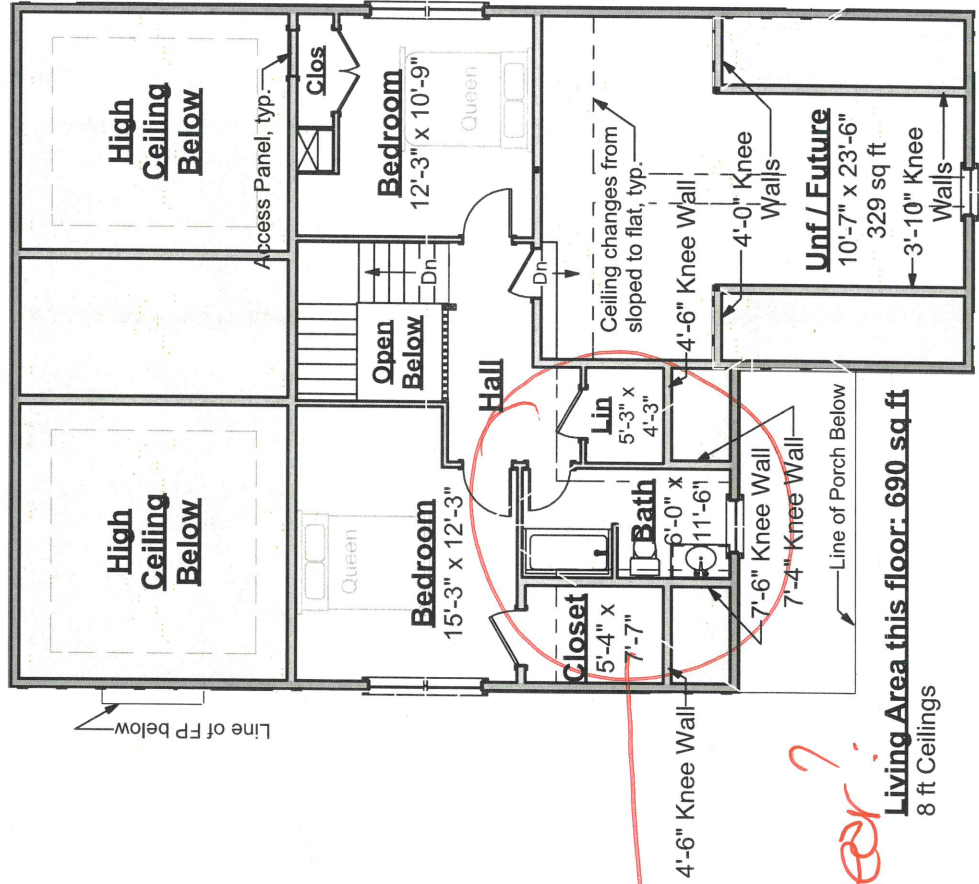

Is there anything we can do here to make this bathroom less linear?

Second Floor Plan
Scale: 3/32" = 1'-0"

Bally Kiss

554.126.v34 GR (9/16/2020)

© 2013-2020 Art Form Architecture, Inc., all rights reserved. You may not build this design without purchasing a license, even if you make changes. This design may have geographic restrictions.




603-431-9559

IMPORTANT BASEMENT NOTES:

- Unless an area is specifically designed as "no posts", additional posts may be required.
- Unless specifically noted otherwise, basement beams will be framed below the floor joists.
- Basement spaces accommodate utilities, mechanical equipment and the horizontal movement of plumbing pipes, electrical wires and heating ducts. Both as part of any Construction Drawings produced based on this design and as future decisions made by the builder, changes to accommodate these items must be expected.
- Basement window locations are dependent on site conditions and utility locations. Clarify number and location with your builder.

*Awedug crentation
eggres*

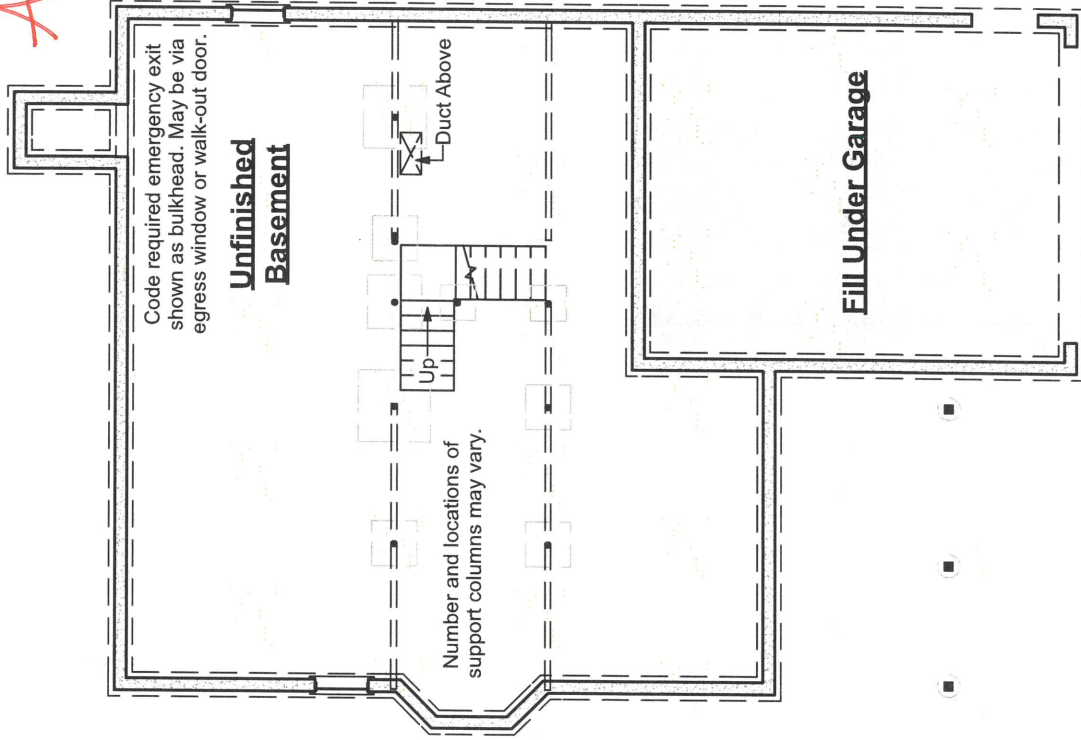

Foundation Plan
Scale: 3/32" = 1'-0"