

418.124.v4 KR Sweet Peekaboo

First Floor

	Area	Beds	Baths
Main	838 SF	0	0.5
Future	0 SF	0	0
Apt	0 SF	0	0
Total	838 SF	0	0.5
Ceiling Height			
Shown	8'-0"		
Possible*	9'-0"		


* See Major Change information on plan page for cost

1. Window grids: Top grids only
2. Slider: No grids
3. Kitchen Window: No grids
4. 9' Ceilings on 1st Floor
5. Remove Comp. Closet
6. Transom Above Slider + 3-Window Bank in LR + Front Door

Use of this document is governed by our **Terms and Conditions**, found on our website:
<http://www.artformhomeplans.com/TermsConditions.a5w>

© 2011 Art Form Architecture, Inc. ALL RIGHTS RESERVED.
 You may not build this Design without purchasing a License to Build (as defined in our Terms). Unauthorized changes are not permitted and violate copyright laws, which provide substantial penalties for infringement.

Artform Home Plans

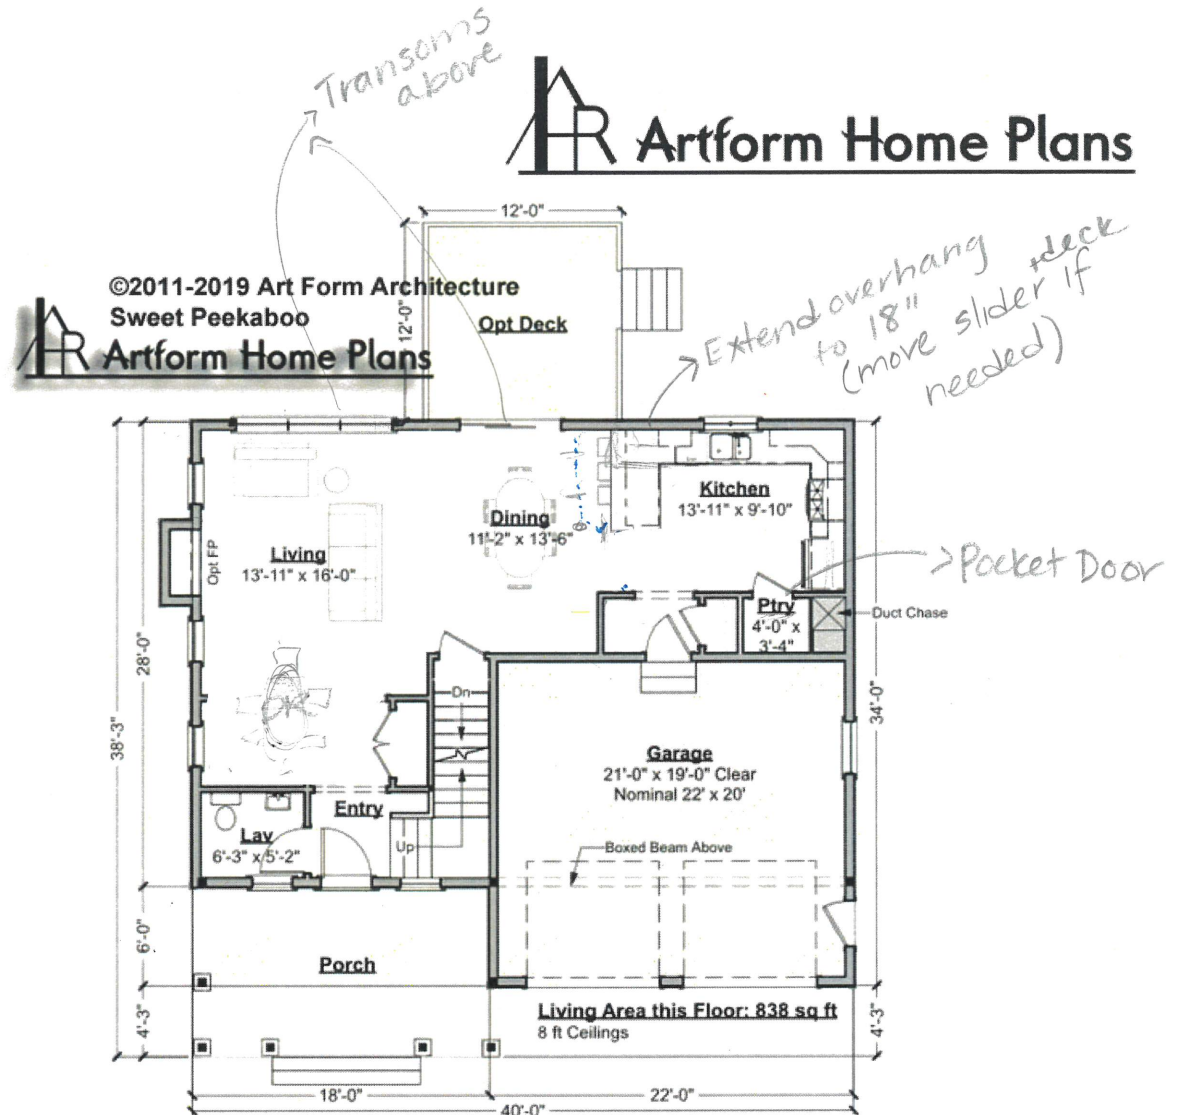

Some features show are optional. Your Purchase & Sale Agreement governs, whether items are labeled "optional" in this document or not.

We are not responsible for typographical errors.

418.124.v4 KR Sweet Peekaboo




Second Floor

	Area	Beds	Baths
Main	1233 SF	3	2
Future	0 SF	0	0
Apt	0 SF	0	0
Total	1233 SF	3	2

Ceiling Height	
Shown	8'-0"
Possible*	8'-0"

* See Major Change information on plan page for cost

©2011-2019 Art Form Architecture
Sweet Peekaboo
Artform Home Plans

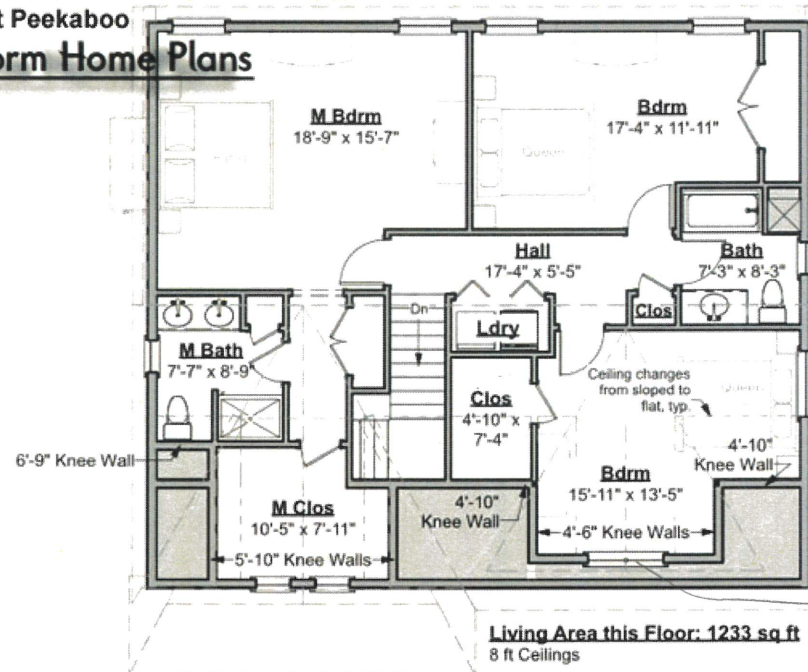

Double hung

Use of this document is governed by our **Terms and Conditions**, found on our website:
<http://www.artformhomeplans.com/TermsConditions.a5w>

© 2011 Art Form Architecture, Inc. ALL RIGHTS RESERVED.
You may not build this Design without purchasing a License to Build (as defined in our Terms). Unauthorized changes are not permitted and violate copyright laws, which provide substantial penalties for infringement.

Some features show are optional. Your Purchase & Sale Agreement governs, whether items are labeled "optional" in this document or not.

We are not responsible for typographical errors.