


Unit 5 Ferncrest
#15 Sagamore Court.

separate 2
full size windows

1. No Front Arch
2. Add 6" to Foundation Height
3. Prairie Style Window Grilles

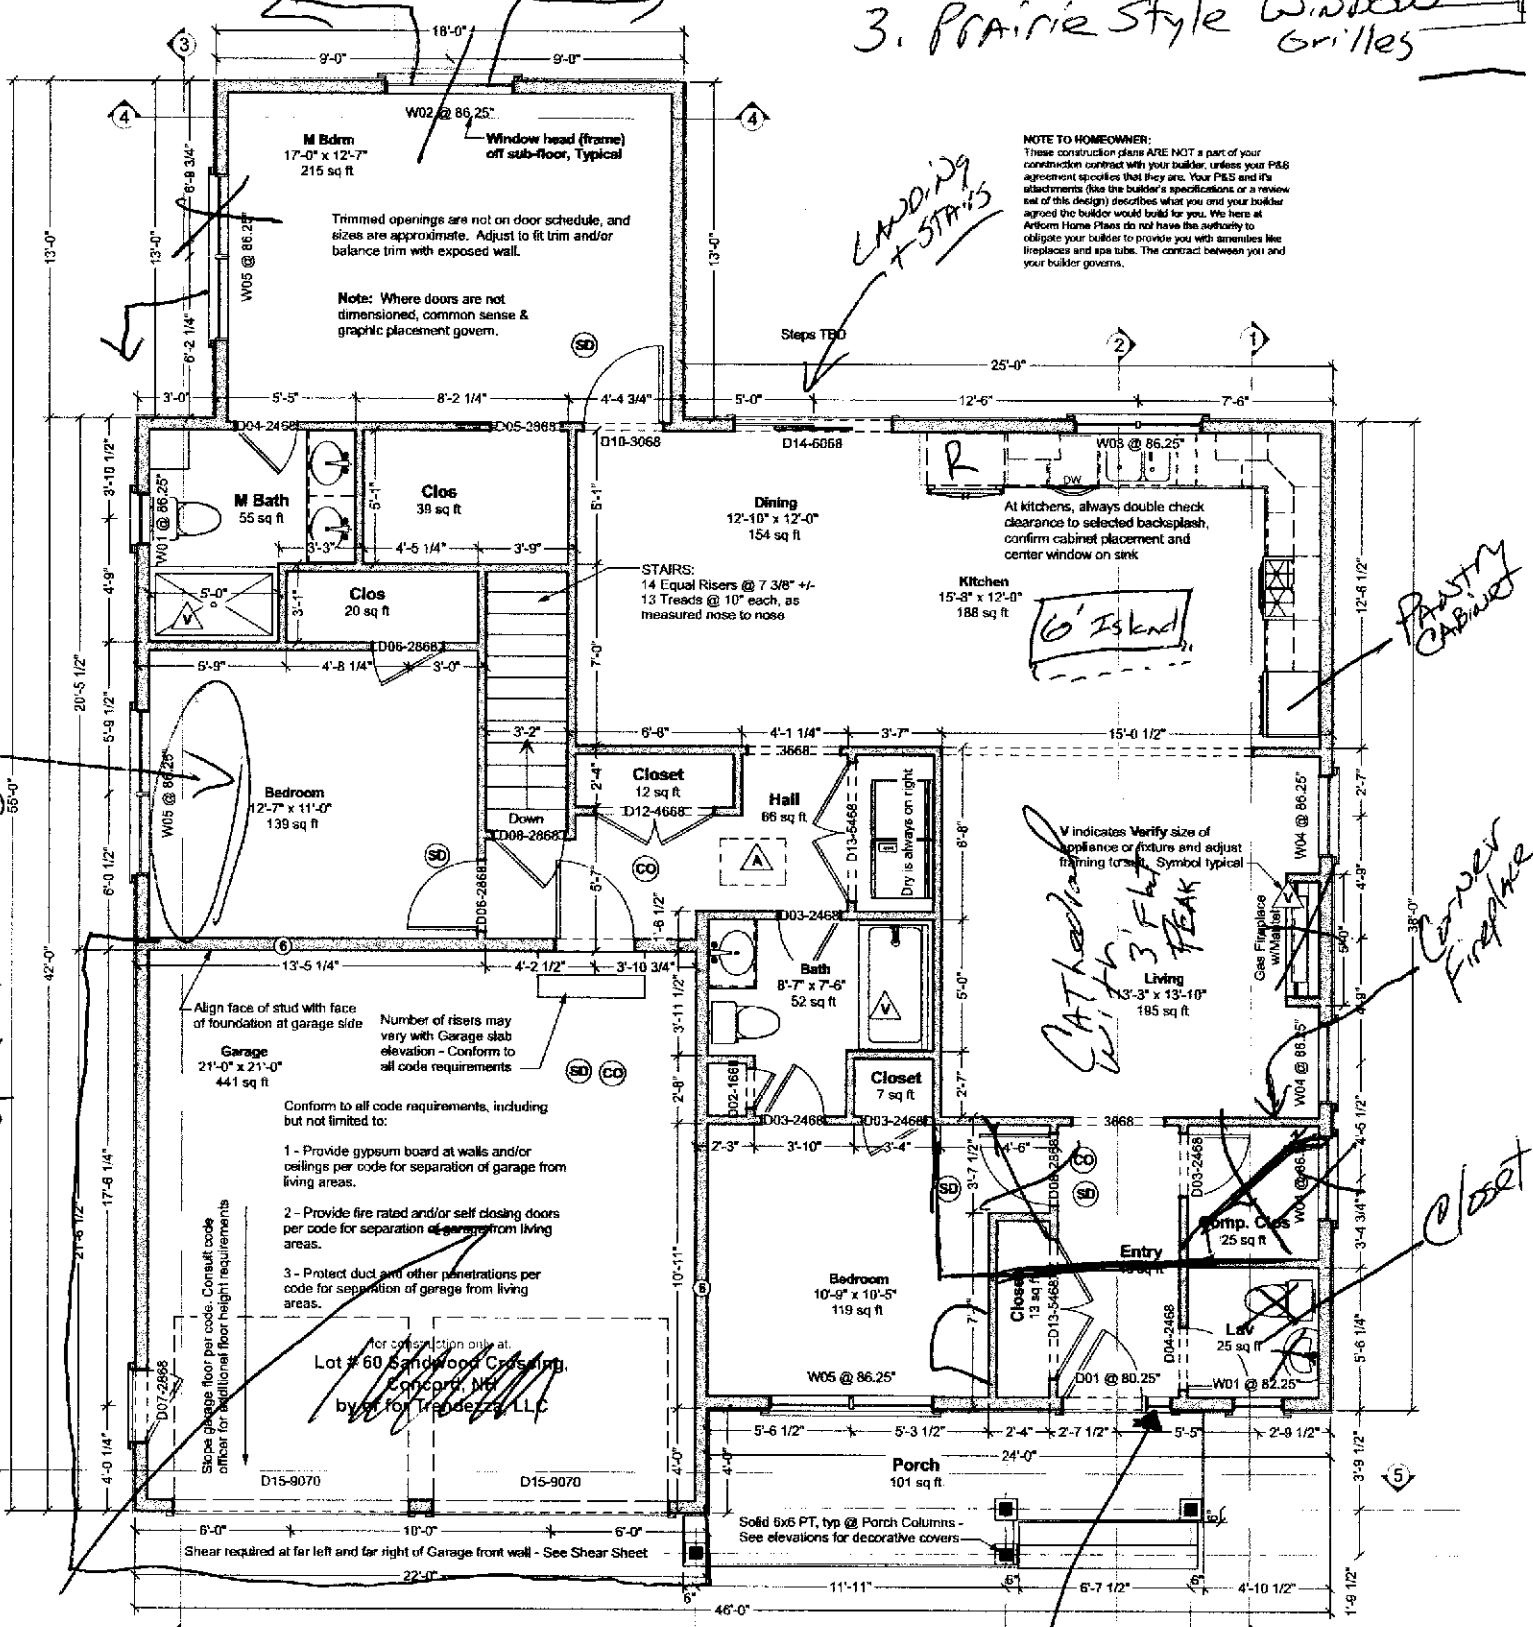

Increase
Garage to 24X24
Garage right - mirror image of above

NUMBER	QTY	WIDT
W01	2	23 1/2"
W02	1	59 1/2"
W03	1	59"
W04	3	38"
W05	5	76"

1/2 Lite like
size like