

Boysenberry Biscotti

702.144.v9 GR


(5/7/2019)

Living Area this Floor: 1614 sq ft

9 ft Ceilings, unless noted otherwise

603-431-9559

Artform Home Plans

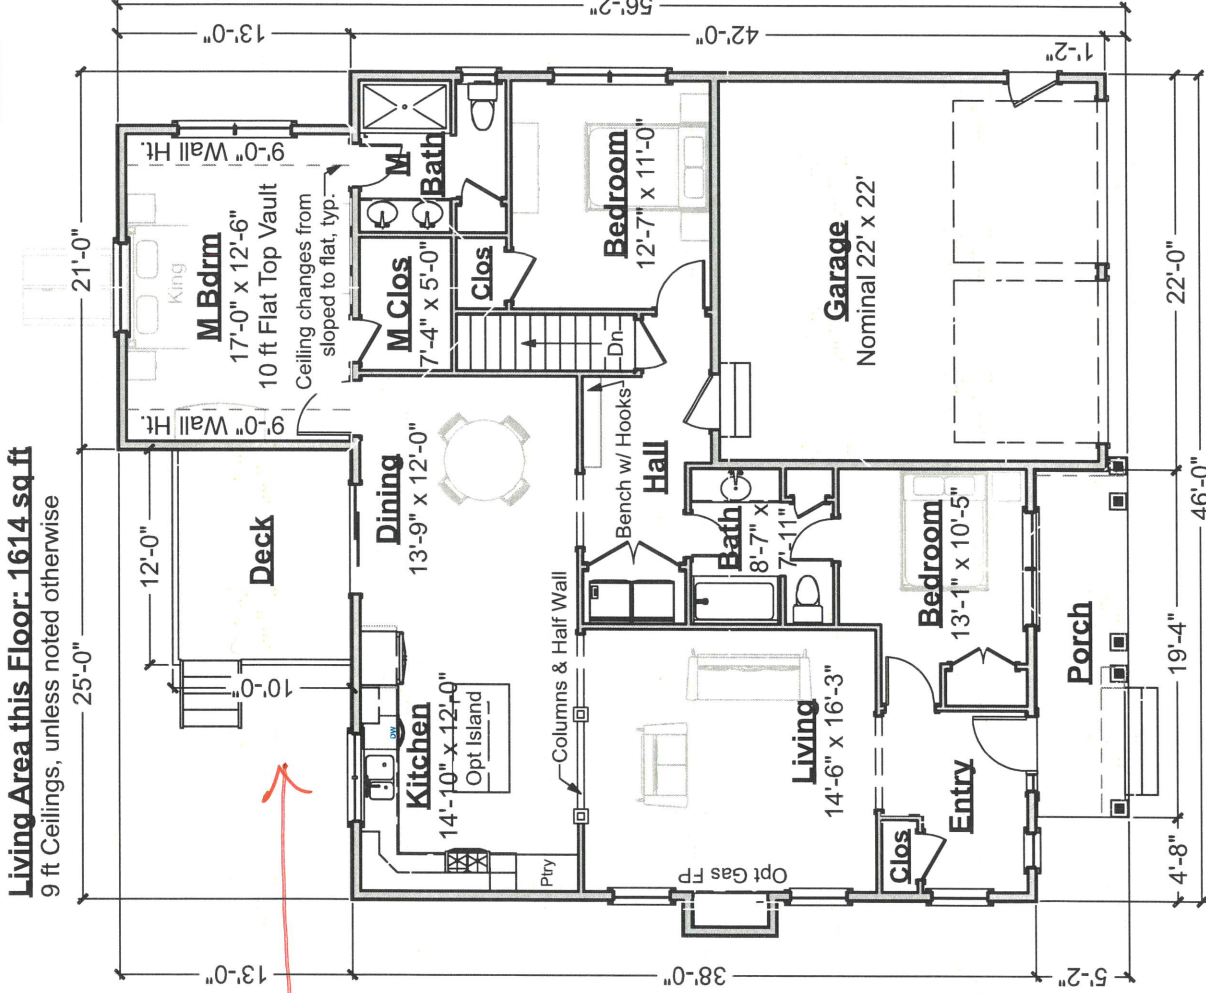

First Floor Plan
Scale: 3/32" = 1'-0"

Boysenberry Biscotti


702.144.v9 GR
(5/7/2019)

© 2014-2019 Art Form Architecture, Inc., all rights reserved.
You may not build this design without purchasing a license,
even if you make changes. This design may have geographic
restrictions.



603-431-9559

- IMPORTANT BASEMENT NOTES:**
- Unless an area is specifically designed as "no posts", additional posts may be required.
 - Unless specifically noted otherwise, basement beams will be framed below the floor joists.
 - Basement spaces accommodate utilities, mechanical equipment and the horizontal movement of plumbing pipes, electrical wires and heating ducts. Both as part of any Construction Drawings produced based on this design and as future decisions made by the builder, changes to accommodate these items must be expected.
 - Basement window locations are dependent on site conditions and utility locations. Clarify number and location with your builder.

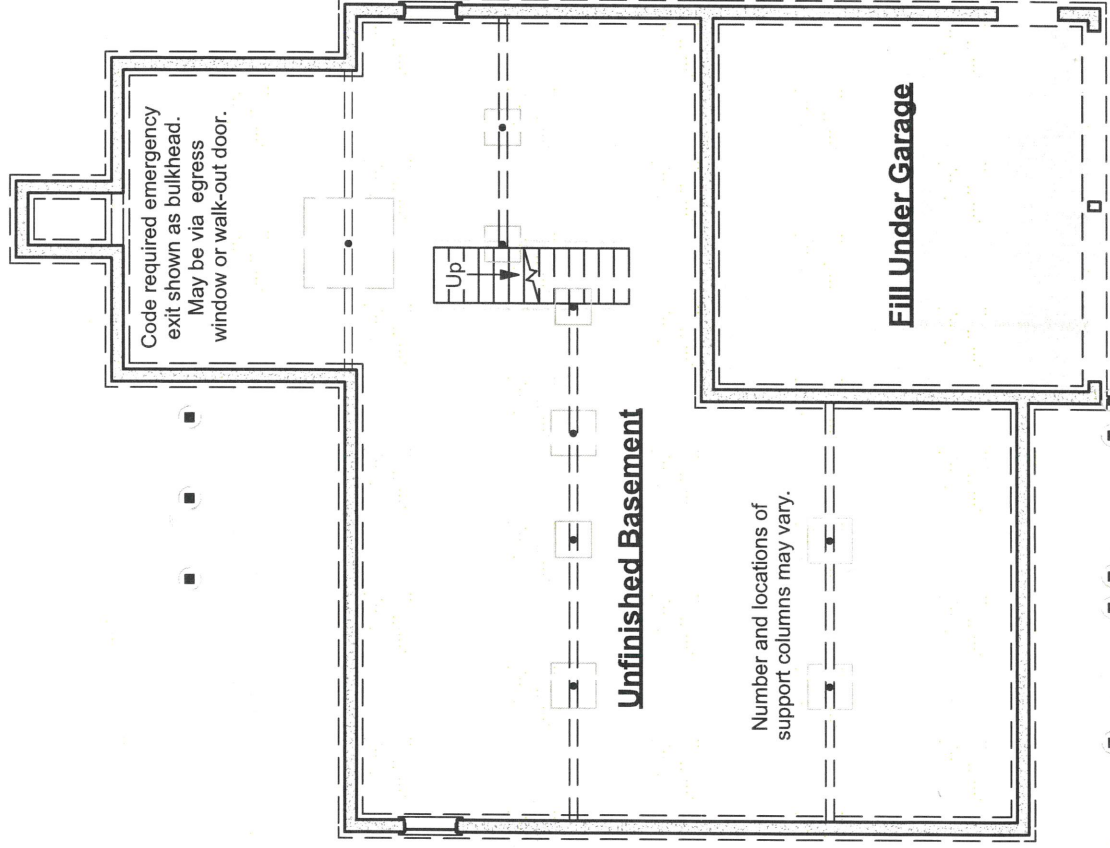

orientation & egress
TBD.

Foundation Plan
Scale: 3/32" = 1'-0"