

Transitory Window


Double Window

Close 3 SEH 800 W

6' slider


Add closet / door

First Floor Plan

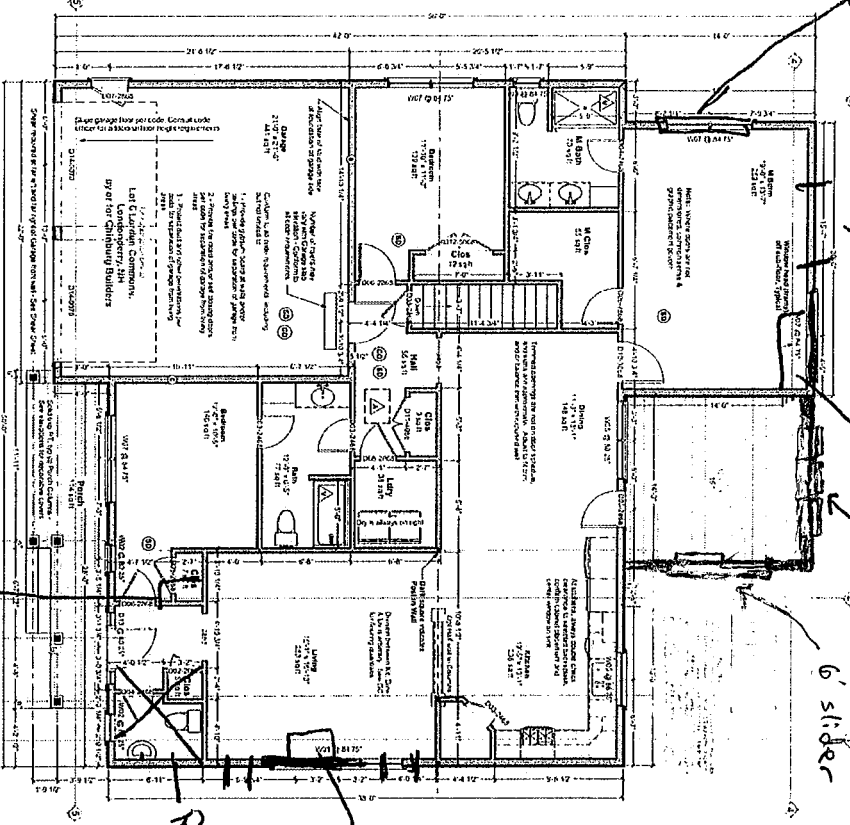

Lose this half main

Fire place on chimney

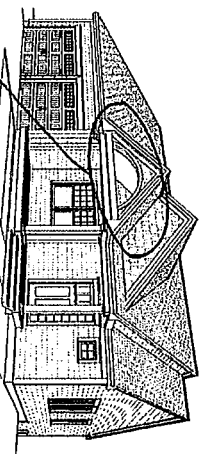

Raspberry Crisp

Room	Area	Perimeter	Volume	Notes
Living Room	12' x 14'	50'	168'	
Dining Room	10' x 12'	44'	120'	
Kitchen	10' x 12'	44'	120'	
Bedroom 1	10' x 12'	44'	120'	
Bedroom 2	10' x 12'	44'	120'	
Bedroom 3	10' x 12'	44'	120'	
Bath	5' x 7'	24'	35'	
Hall	3' x 4'	14'	12'	
Closet	3' x 4'	14'	12'	
Staircase	3' x 4'	14'	12'	
Entry	3' x 4'	14'	12'	
Front Porch	10' x 12'	44'	120'	
Back Porch	10' x 12'	44'	120'	
Garage	10' x 12'	44'	120'	
Driveway	10' x 12'	44'	120'	
Yard	10' x 12'	44'	120'	

NOTES:

1. All dimensions are in feet and inches.
2. All areas are in square feet.
3. All volumes are in cubic feet.
4. All materials are to be specified by the architect.
5. All construction is to be in accordance with the building code.
6. All finishes are to be specified by the architect.
7. All fixtures are to be specified by the architect.
8. All equipment is to be specified by the architect.
9. All landscaping is to be specified by the architect.
10. All site work is to be specified by the architect.

Architect: [Name]

Client: [Name]

Date: 11/26/2011