


DOUGHTY

ART FORM ARCHITECTURE, INC.


APR 03 2012

20' L x 8' W

2 DOORS

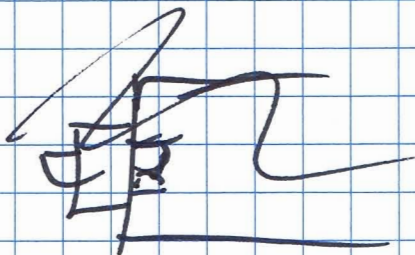

1) ADD WOOD SHED

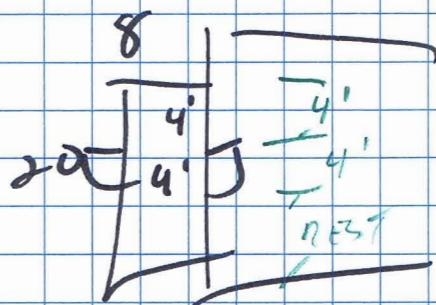

SCREENED VENTS

2) ROOF RIDGE VENT
SHOULD BE 2 FT
ABOVE CONNECTION ROOF