



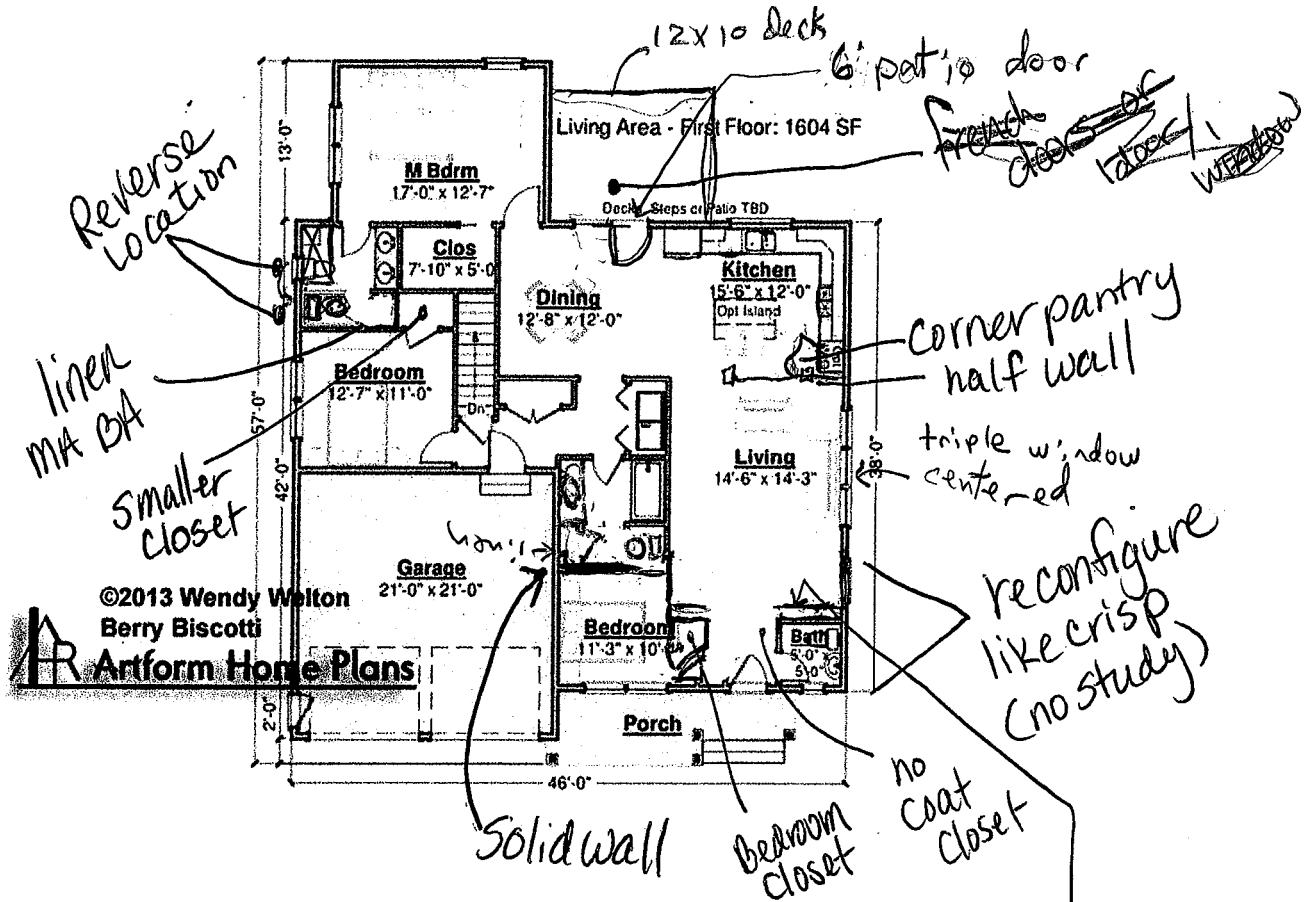

Basement

Floor Plan

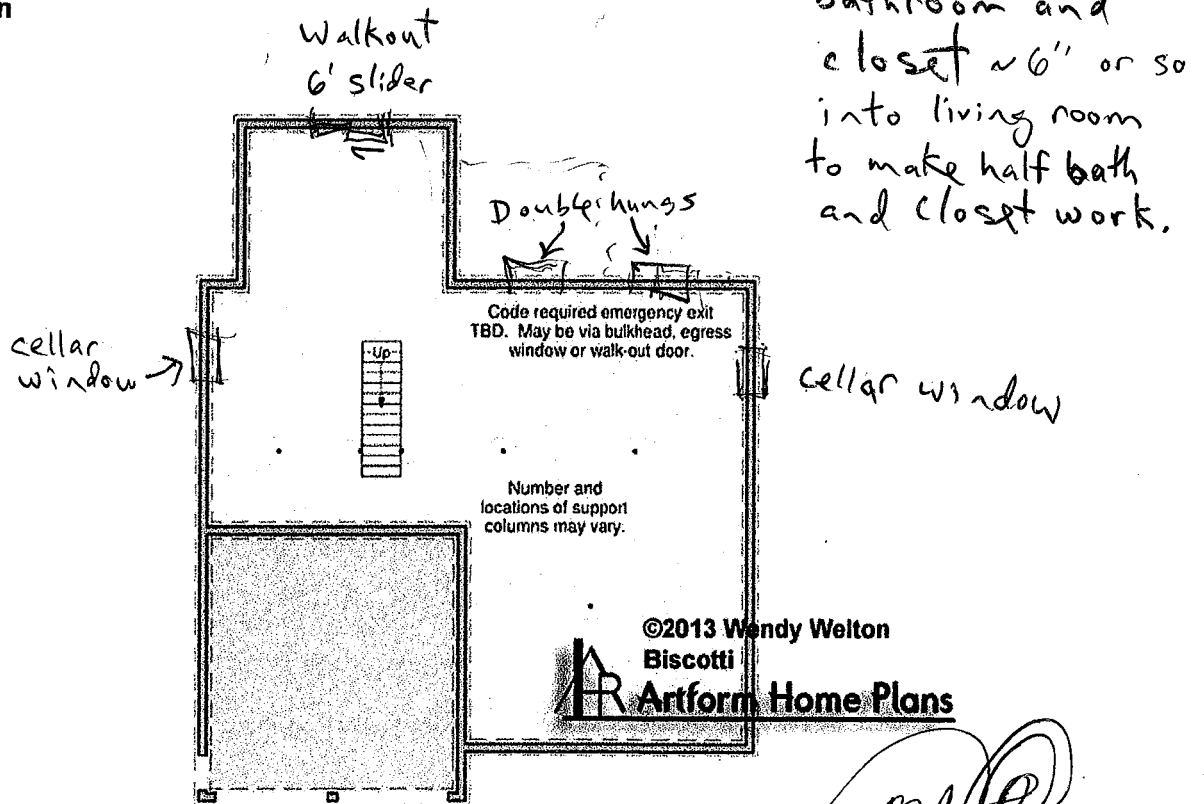

KE (MLO)

J Chinburg

From: Wendy Welton <wendy@artform.us>
Sent: Thursday, October 16, 2014 7:27 PM
To: Paul Kerrigan; J Chinburg
Cc: Holly Ciampa, Chief of Staff
Subject: First look Apple Crisp, 2nd look Boysenberry

And I already had a Boysenberry Crisp tucked away somewhere:



And here's what an Apple Crisp might look like:

Handwritten signature/initials, possibly "JC" or "JCW", with a large circular flourish below it.