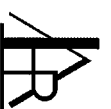



Brandywine Classic

260.124 KL

© 2014 Wendy Welton, all rights reserved. You may not build this design without purchasing a license, even if you make changes. This design may have geographic restrictions.

 Artform Home Plans

603-431-9559

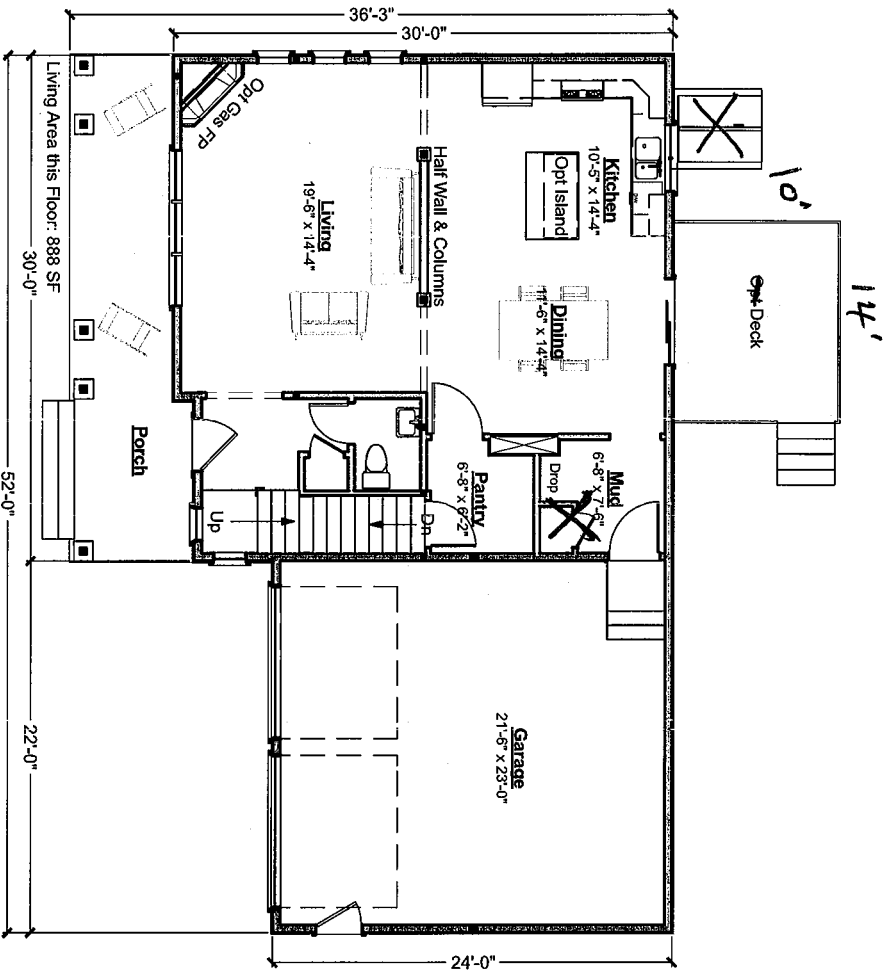

First Floor Plan

Brandywine Classic


260.124 KL

© 2014 Wendy Welton, all rights reserved. You may not build this design without purchasing a license, even if you make changes. This design may have geographic restrictions.



603-431-9559

bi-fold
doors

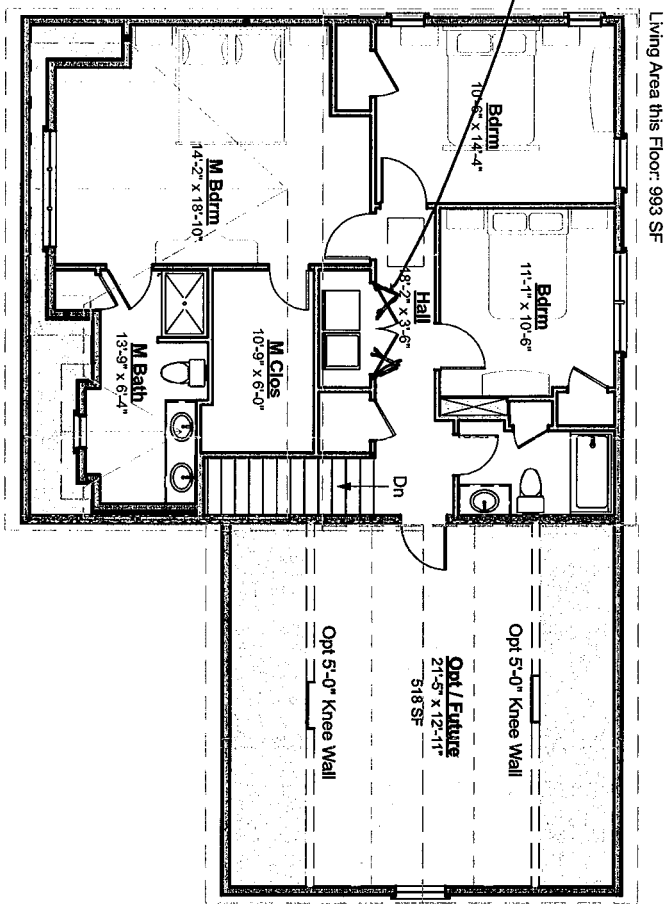

Brandywine Classic


260.124 KL

© 2014 Wendy Welton, all rights reserved. You may not build this design without purchasing a license, even if you make changes. This design may have geographic restrictions.



603-431-9559

9-light walkout

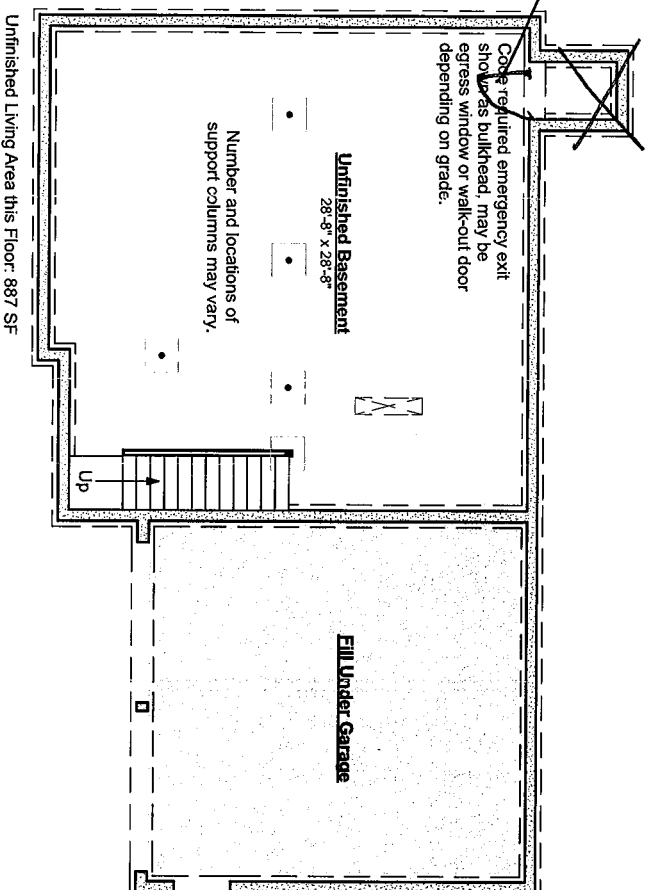

Unfinished Living Area this Floor: 887 SF

Foundation Plan