

Butterscotch

430.001

© 2013 Art Form Architecture, Inc. All Rights Reserved . <http://www.artformhomeplans.com>

First Floor

Living Area: 884 SF


Bedrooms: 1

Bathrooms: 1.0

Ceiling Height Shown: 8'-0"

Ceiling Height Possible*: 8'-0"

* - Increasing ceiling height requires a Major Change.

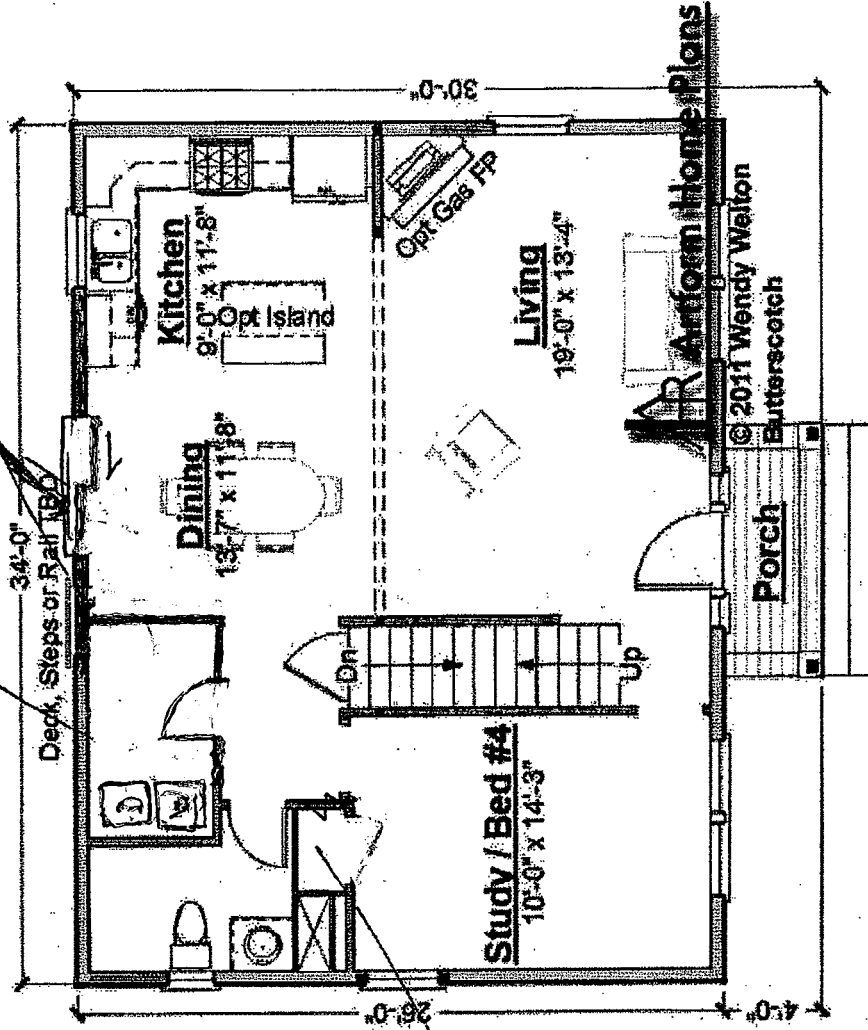

Blw

KC

<http://www.artformhomeplans.com/Contact.a5w>

<http://www.artformhomeplans.com/TermsConditions.a5w>

Butterscotch

430.001

© 2013 Art Form Architecture, Inc. All Rights Reserved . <http://www.artformhomeplans.com>

Second Floor

Living Area: 884 SF


Bedrooms: 3

Bathrooms: 2.0

Ceiling Height Shown: 8'-0"

Ceiling Height Possible*: 8'-0"

* -- Increasing ceiling height requires a Major Change.

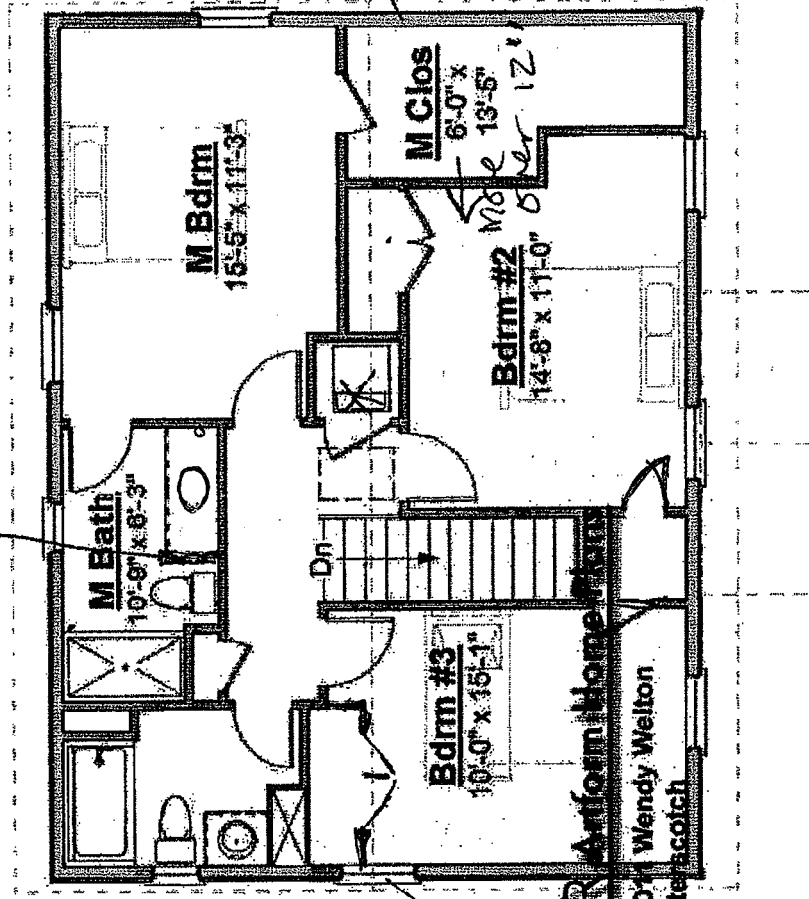

<http://www.artformhomeplans.com/Contact.a5w>

<http://www.artformhomeplans.com/TermsConditions.a5w>

KC

2013

Butterscotch

430.001

© 2013 Art Form Architecture, Inc. All Rights Reserved . <http://www.artformhomeplans.com>

Basement Floor

Living Area: 120 SF

Bedrooms: 0

Bathrooms: 0.0


Ceiling Height Shown: 7'-8"

Ceiling Height Possible*: 7'-8"

*-- Increasing ceiling height requires a Major Change.



Artform Home Plans

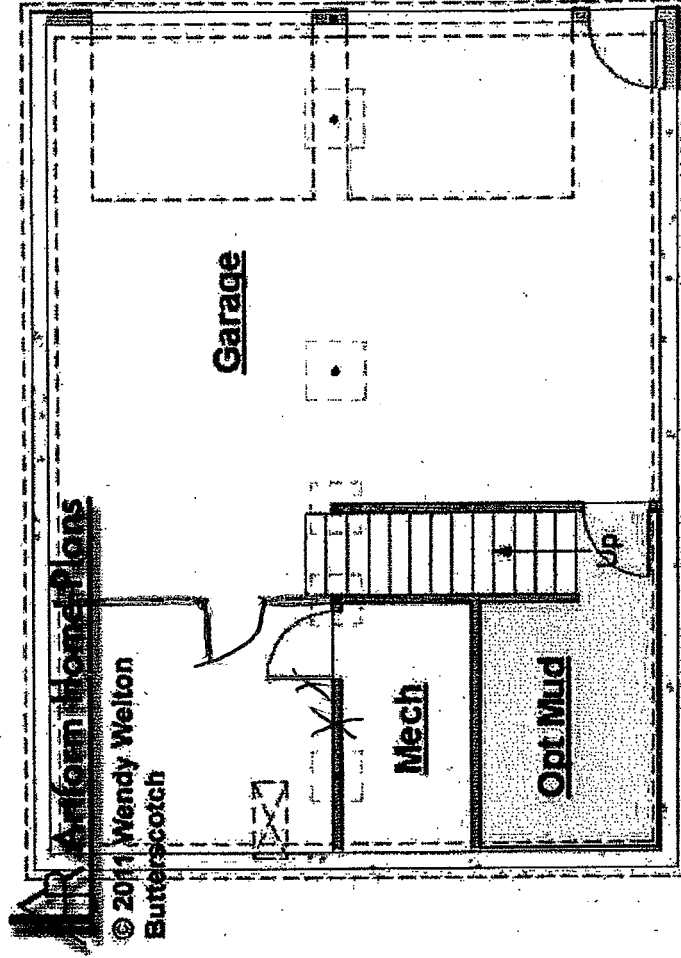

Artform Home Plans

© 2013 Wendy Welton

Butterscotch

<http://www.artformhomeplans.com/Contact.a5w>

<http://www.artformhomeplans.com/TermsConditions.a5w>

XC



CSM

Butterscotch



430.001

© 2013 Art Form Architecture, Inc. All Rights Reserved . <http://www.artformhomeplans.com>

Elevations

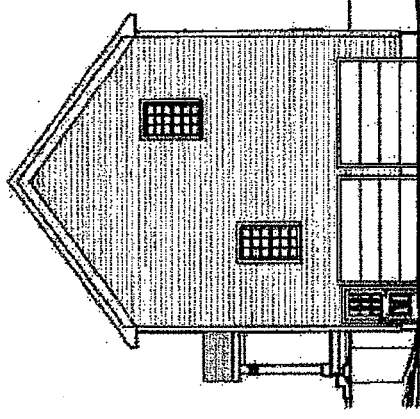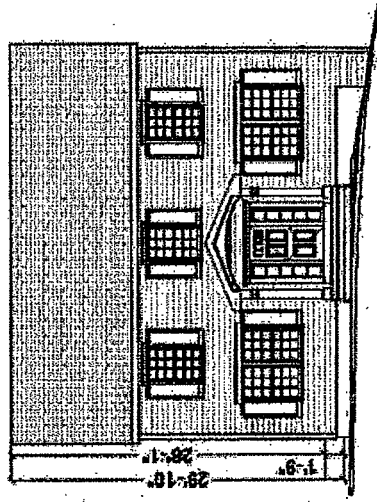

© 2011 Wendy Welton
Butterscotch

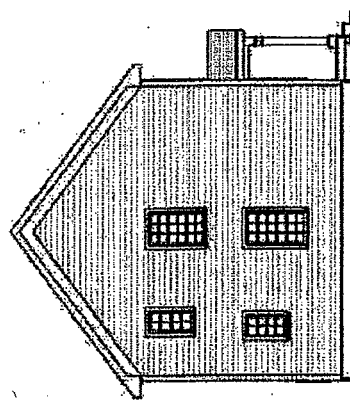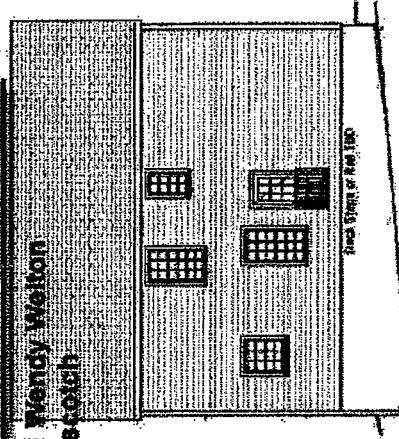

<http://www.artformhomeplans.com/Contact.a5w>

<http://www.artformhomeplans.com/TermsConditions.a5w>

KC

(BWD) LOM