


Artform Home Plans

© 2012 Wendy Welton, all rights reserved

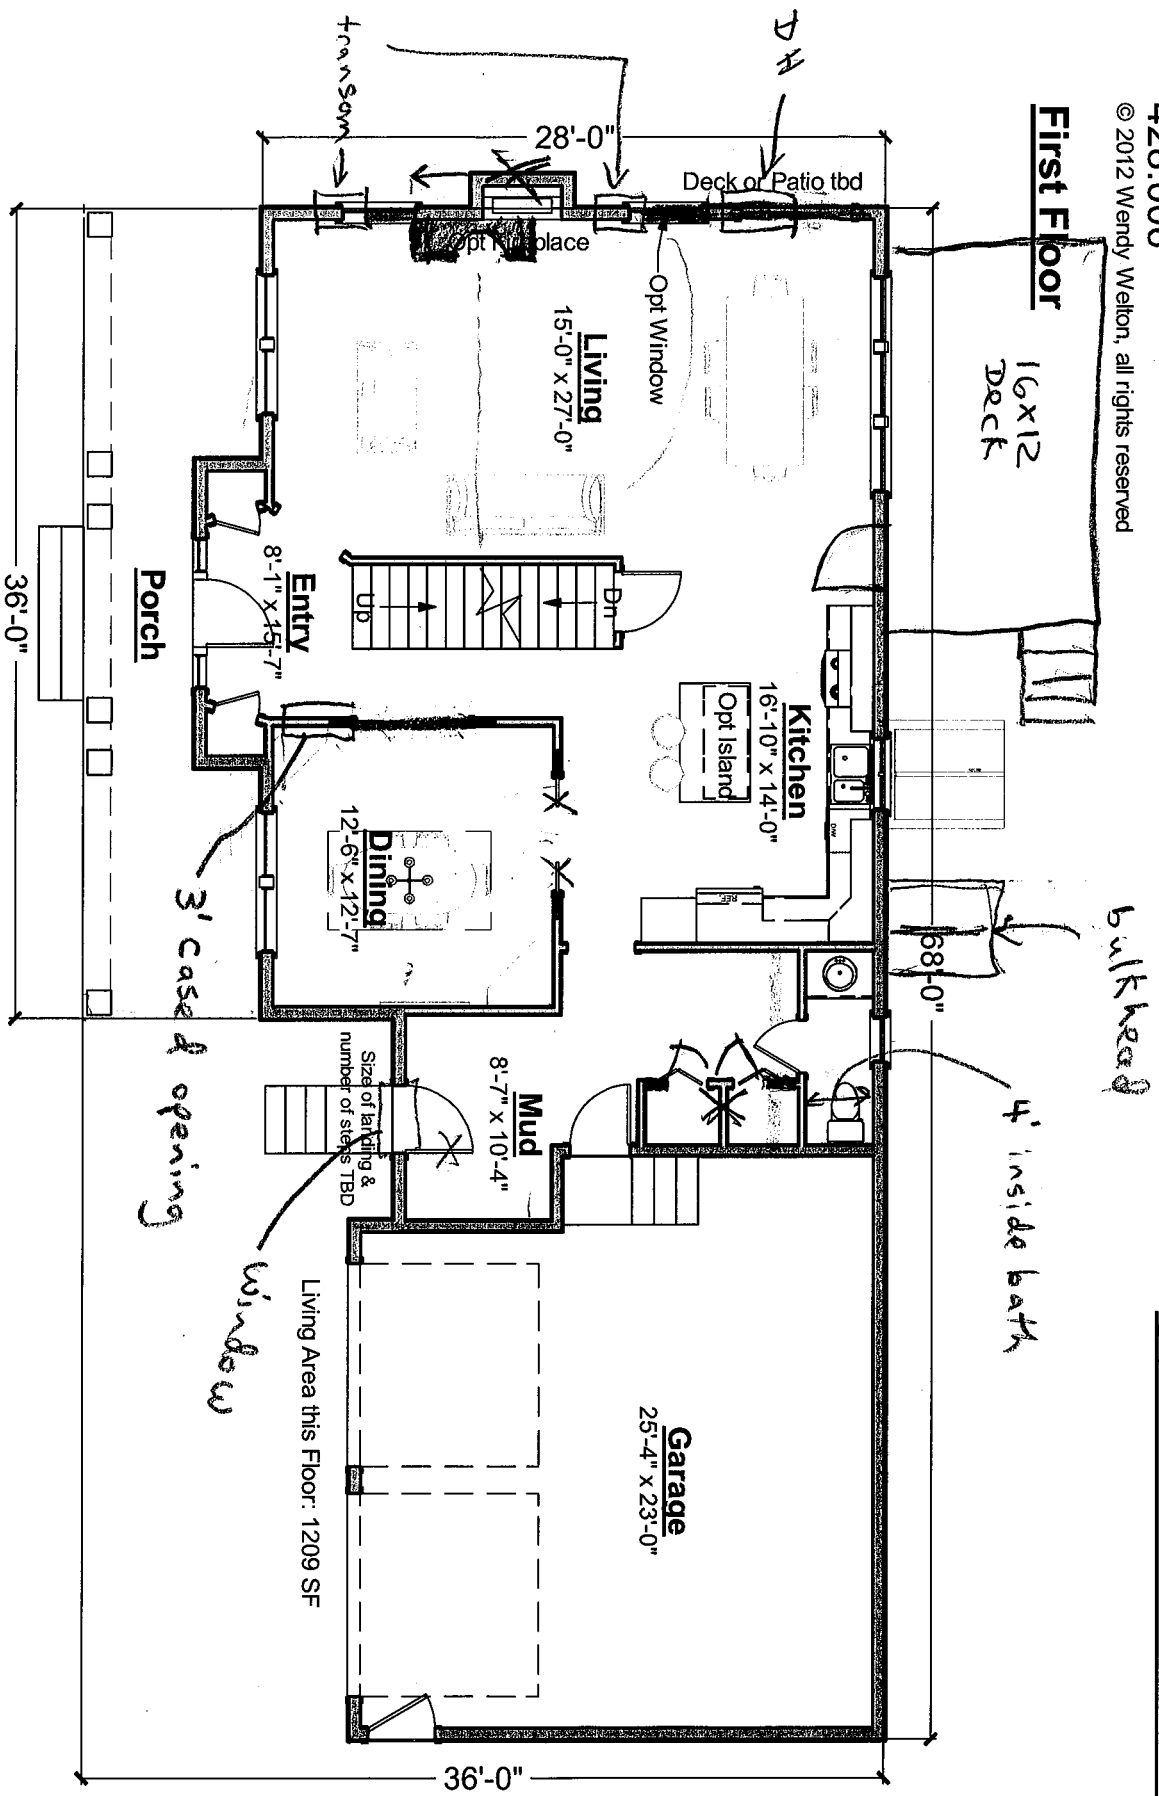


Creme De La Saffron

428.006

© 2012 Wendy Welton, all rights reserved



Second Floor

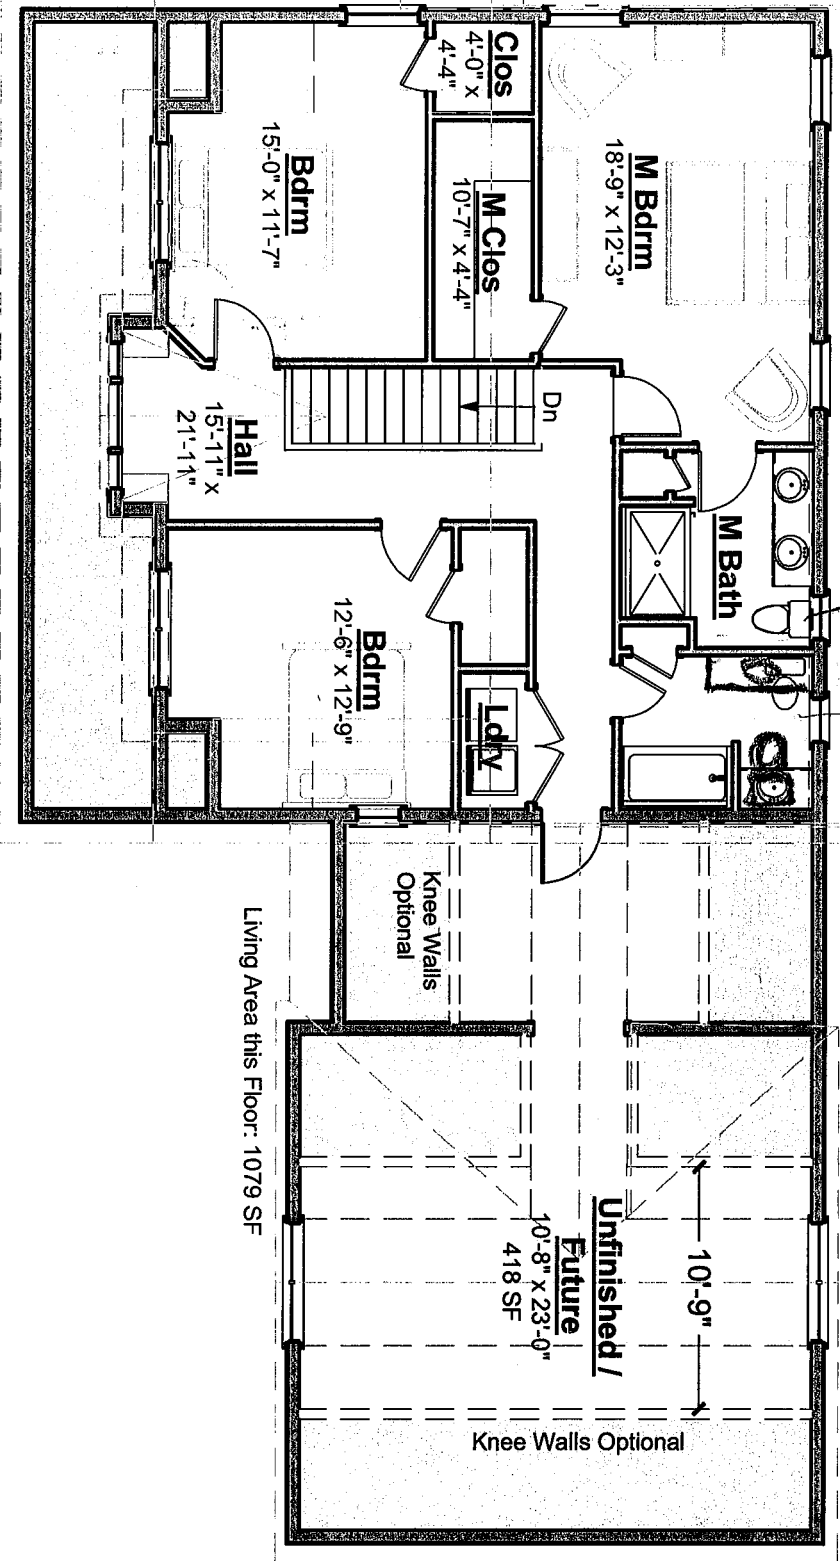

3' space for toilet?

rearrange bath steal a few inches from master if needed

Living Area this Floor: 1079 SF