
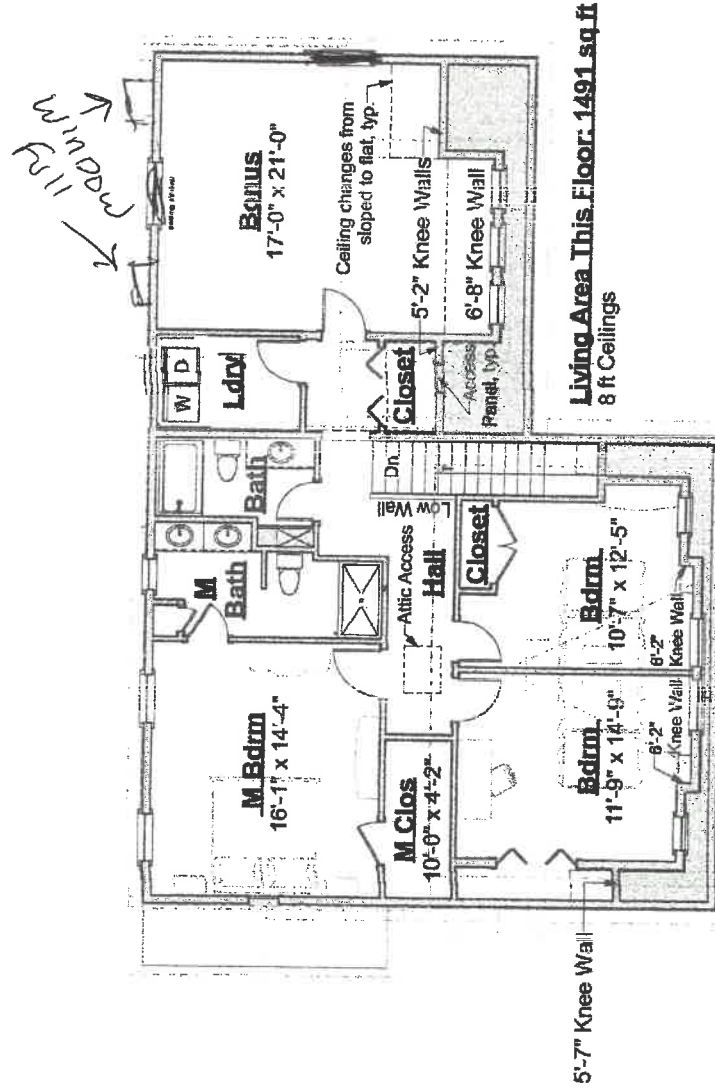


Emerald Sea Premier

320.129.v7 KR

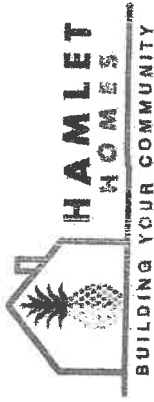

Second Floor Plan
Scale: 3/32" = 1'-0"

2