



changes. This design may have geographic restrictions.

Possibly move window
6" to the right

NUMBER	QTY	WIDTH	HEIGHT	WINDOW
W01	2	20"	36"	21"
W02	1	24"	60"	25"
W03	4	36"	40"	37"
W04	6	36"	60"	37"
W05	1	38"	69"	39"
W06	1	68 1/2"	36"	69"
W07	3	72"	60"	73"
W09	1	84"	48"	85"
W10	1	112"	60"	113"

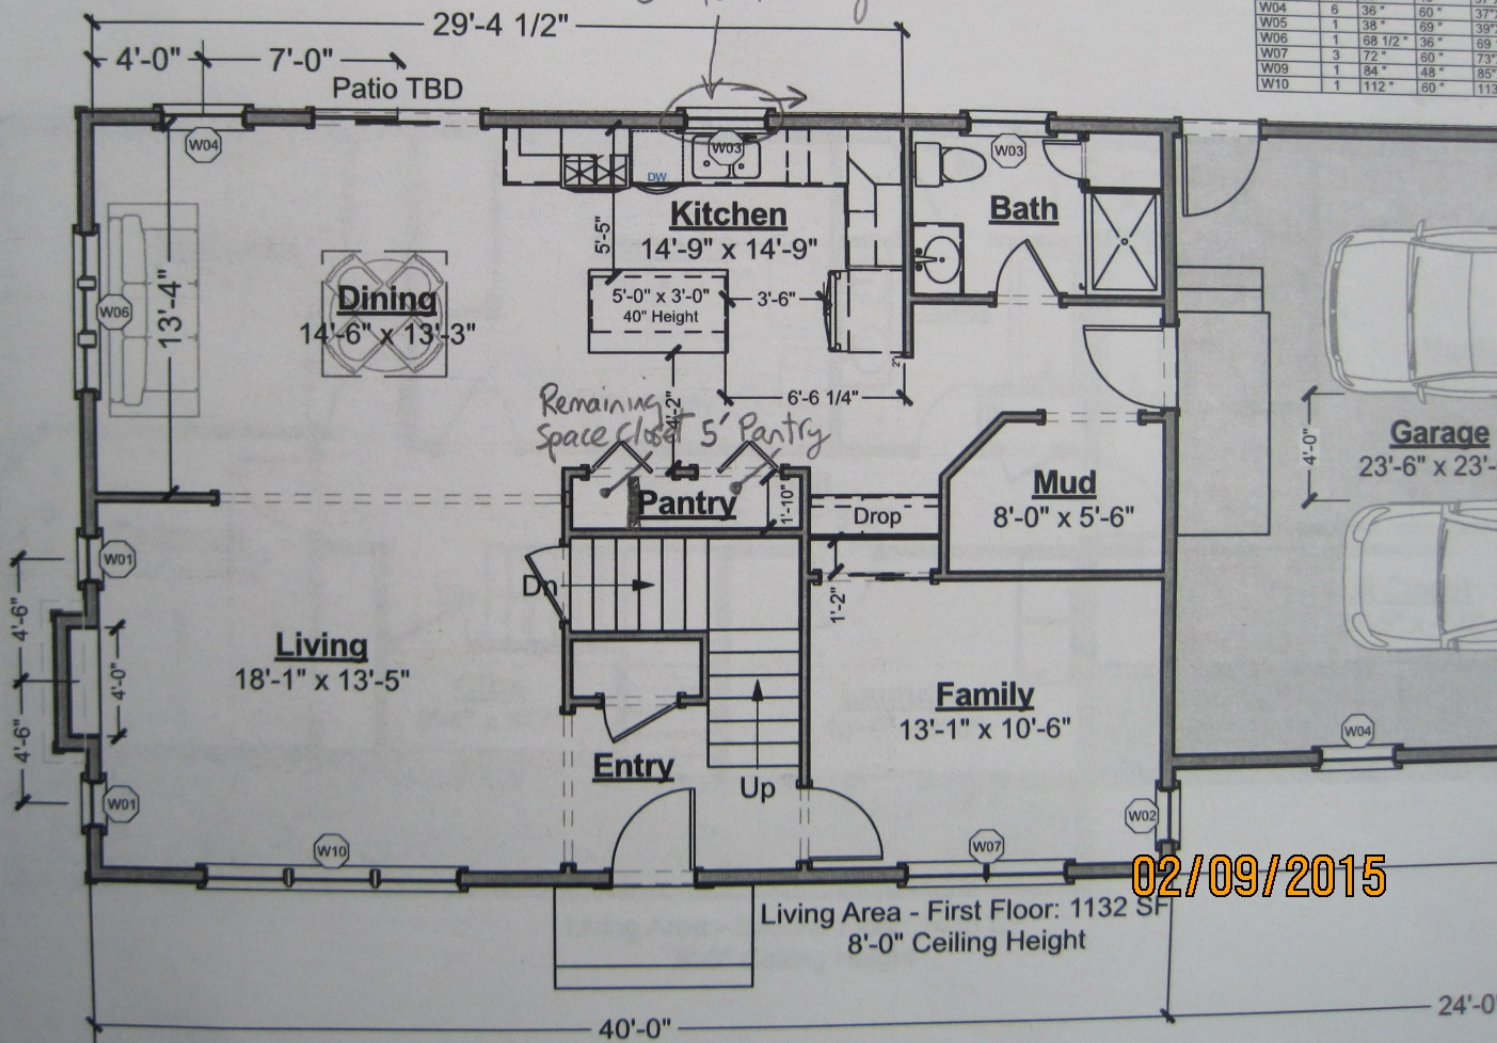

Change to
W04

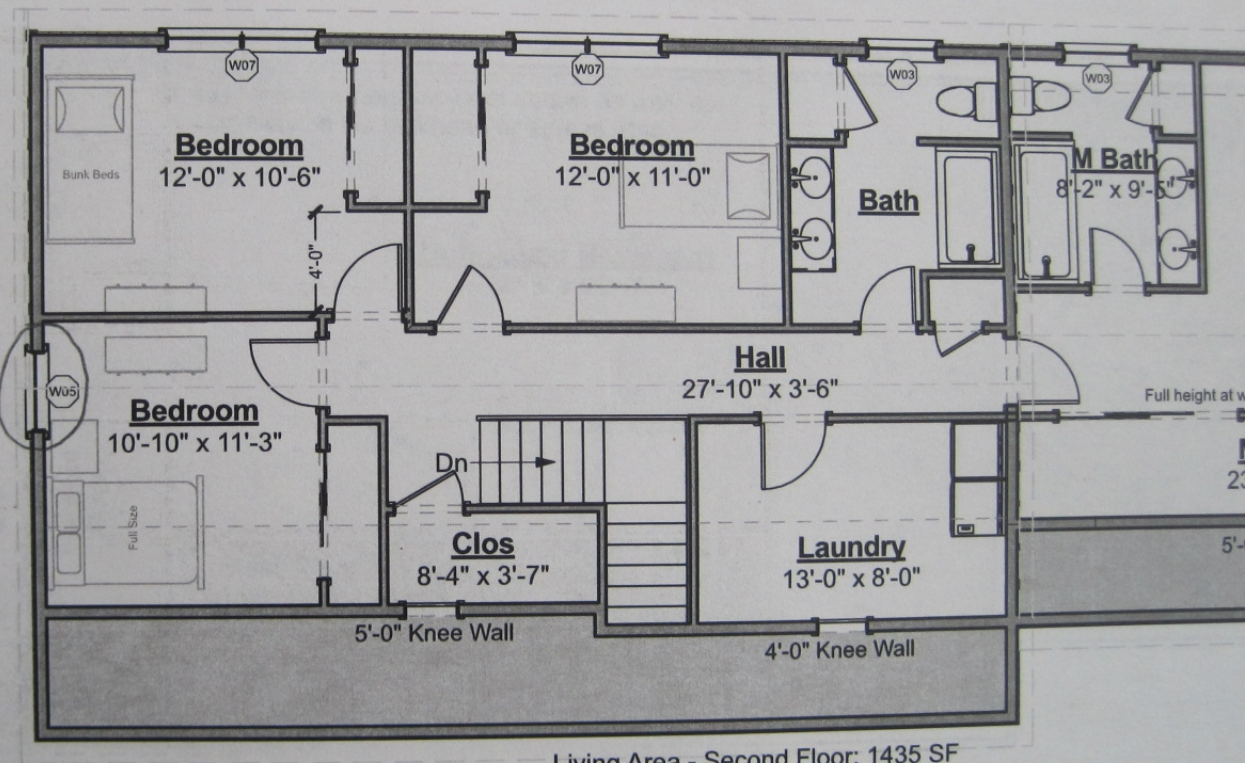


Living Area - Second Floor: 1435 SF
8'-0" Ceiling Height

02/09/2015

Redesigned Pantry for Matt and Laurie Ferguson

Scale: $\frac{1}{2}" = 1'$

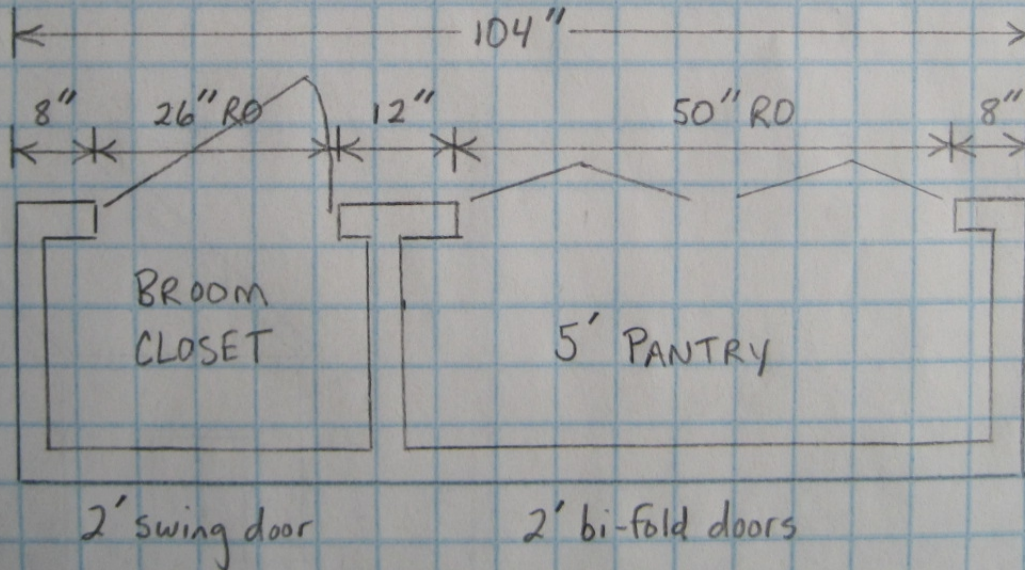


Possibly
Concrete
wall returned
3'

Code required emergency exit shown as walk-out
door. May be via bulkhead or egress window.

Unfinished Basement

38'-8" x 26'-8"

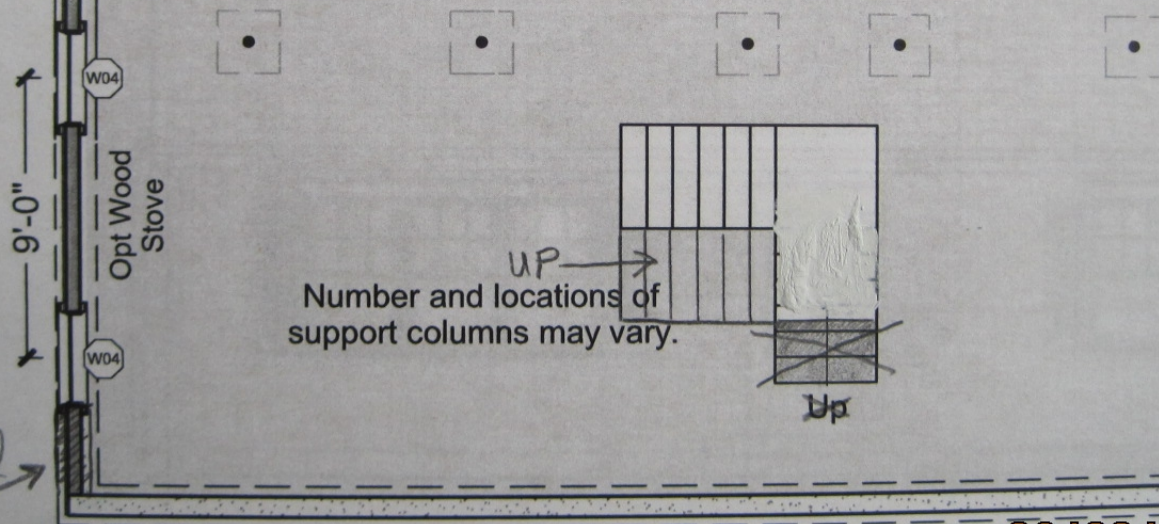

Possibly
Concrete
wall returned
3'

02/09/2015