





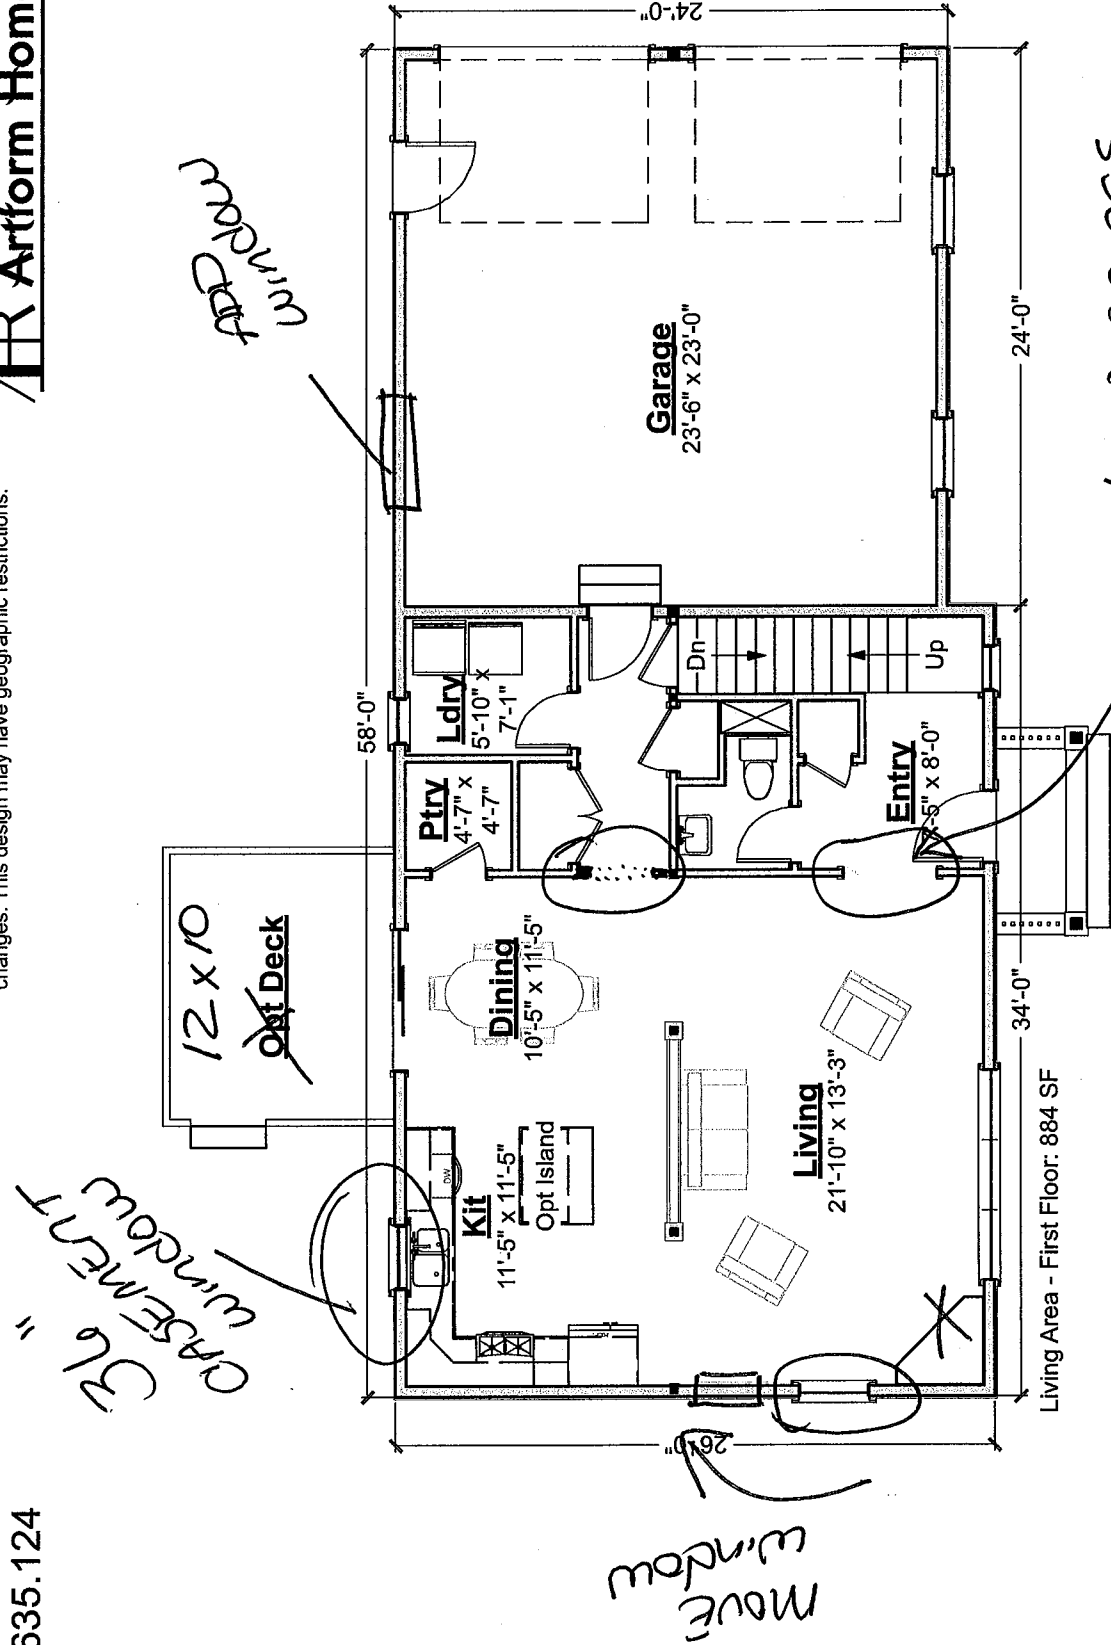

Living Area Second Floor: 834 SF

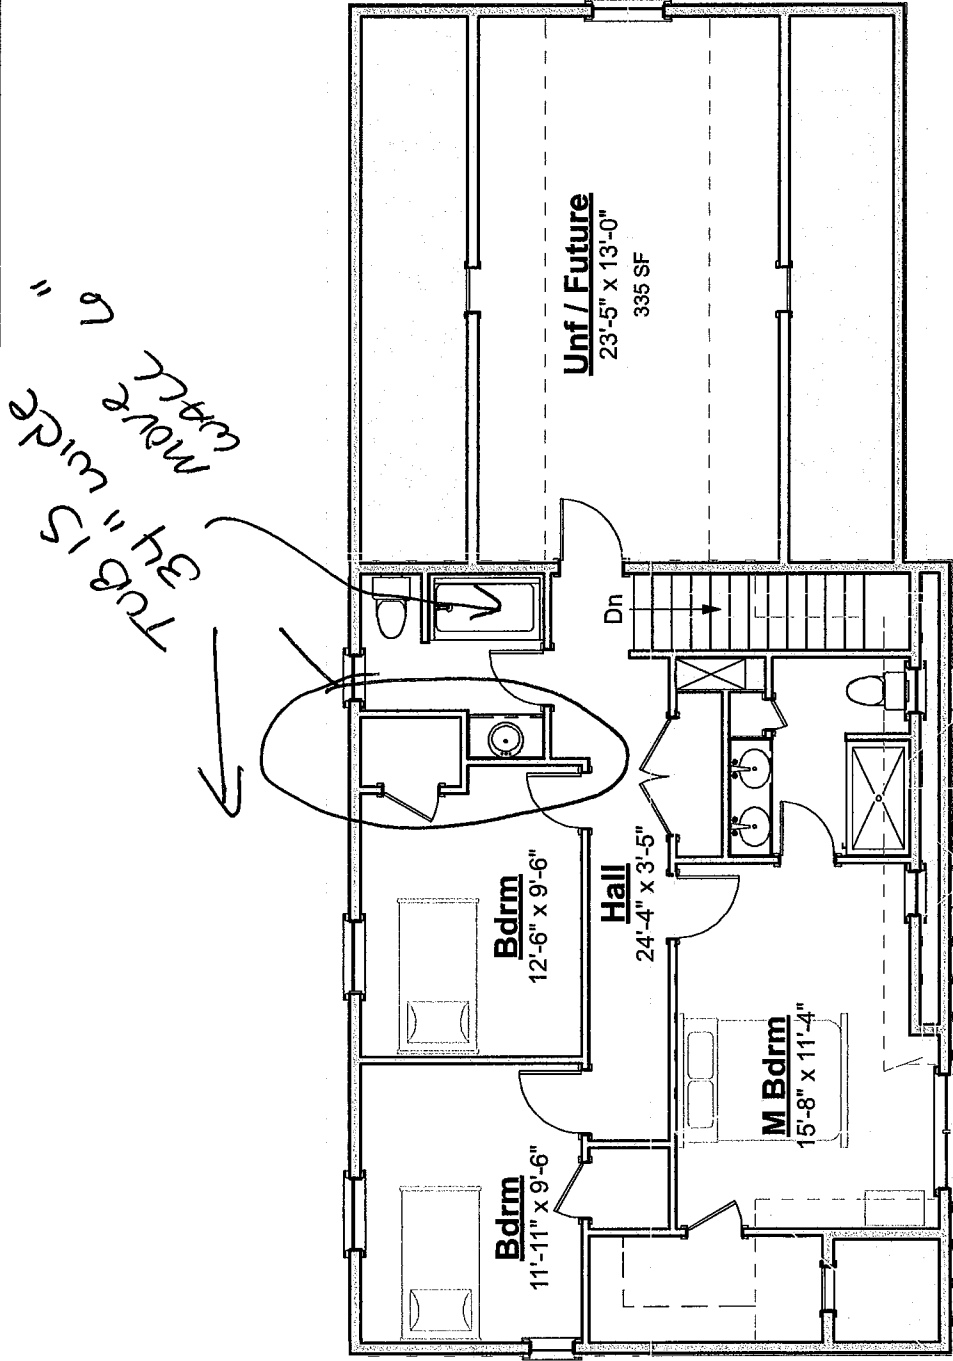