


Hopscotch with Porch

408.004
© 2013 Art Form Architecture, Inc. All Rights Reserved . <http://www.artformhomeplans.com>

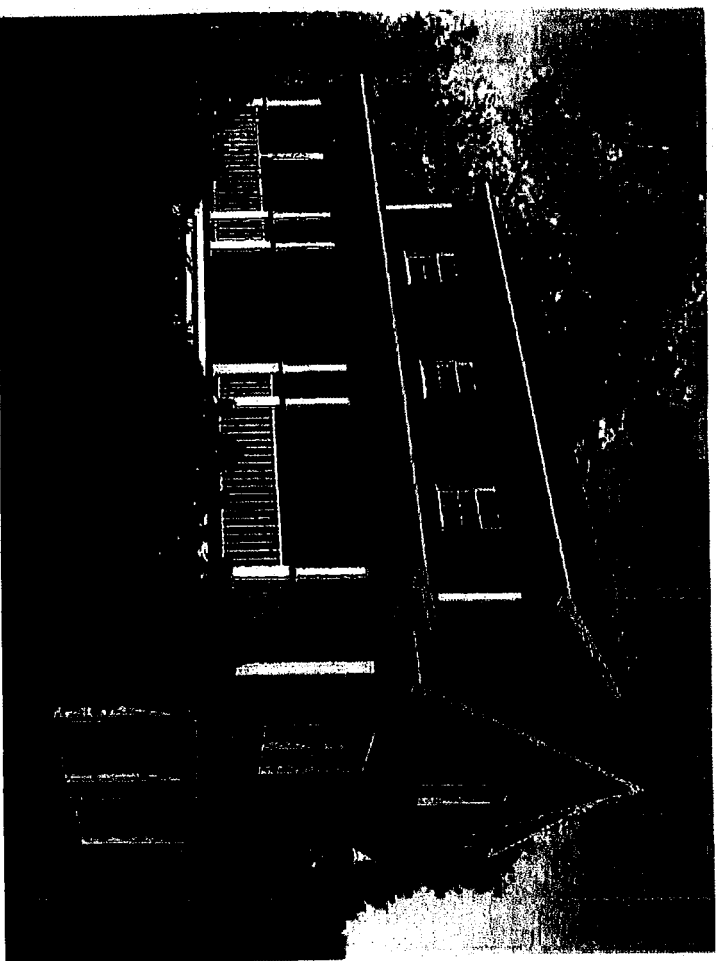

Here's our Hopscotch with a full farmer's porch.

Artform Home Plans

See more plans in the Scott-Scotch Capes & Colonials Collection.

	Living Area	Bedrooms	Bathrooms	Ceiling Height Shown	Ceiling Height Possible
First Floor	884 SF	1	1.0	8'-0"	8'-0"
Second Floor	844 SF	3	2.0	8'-0"	8'-0"
Total Above Grade	1728 SF	4	3.0		
Basement	0 SF	0	0.0		

* - Increasing ceiling height requires a Major Change

<http://www.artformhomeplans.com/Items/Conditions.aspx>

<http://www.artformhomeplans.com/Items/Conditions.aspx>

XL JK (25)

Hopscotch w/Portico

408.003

© 2013 Art Form Architecture, Inc. All Rights Reserved. <http://www.artformhomeplans.com>

First Floor

Living Area: 884 SF


Bedrooms: 1

Bathrooms: 1.0

Ceiling Height Shown: 8'-0"

Ceiling Height Possible*: 8'-0"

* - Increasing ceiling height requires a Major Change.

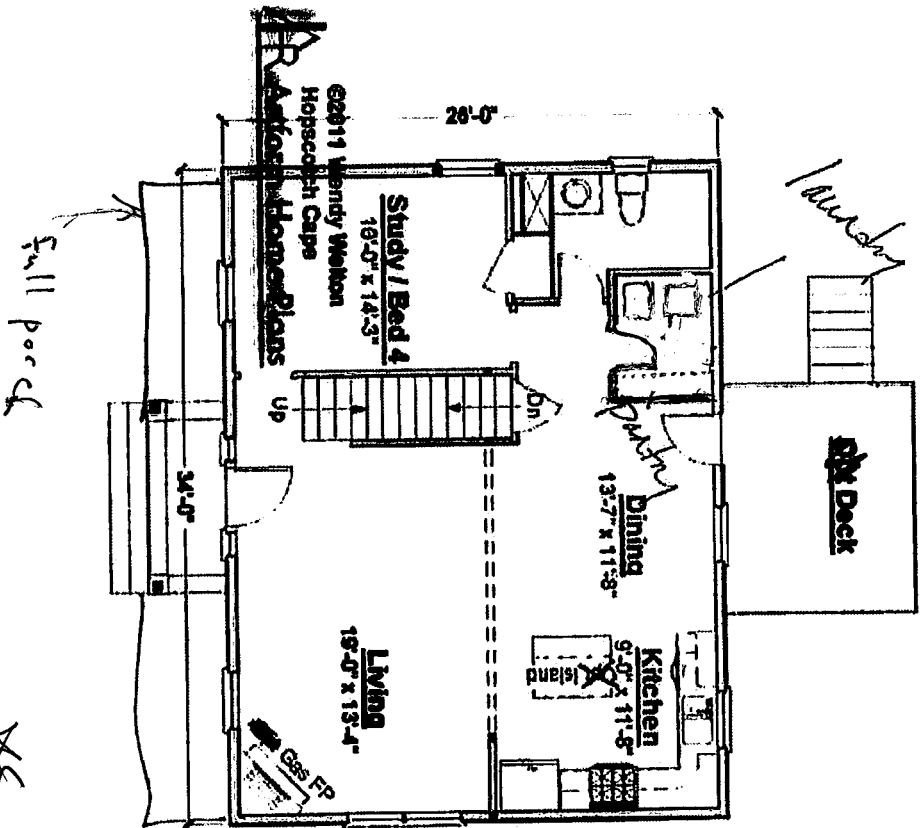

xc

js

Hopscotch w/Portico

408.003

© 2013 Art Form Architecture, Inc. All Rights Reserved . <http://www.artformhomeplans.com>

Second Floor

Living Area: 844 SF


Bedrooms: 3

Bathrooms: 2.0

Ceiling Height Shown: 8'-0"

Ceiling Height Possible*: 8'-0"

* - Increasing ceiling height requires a Major Change.

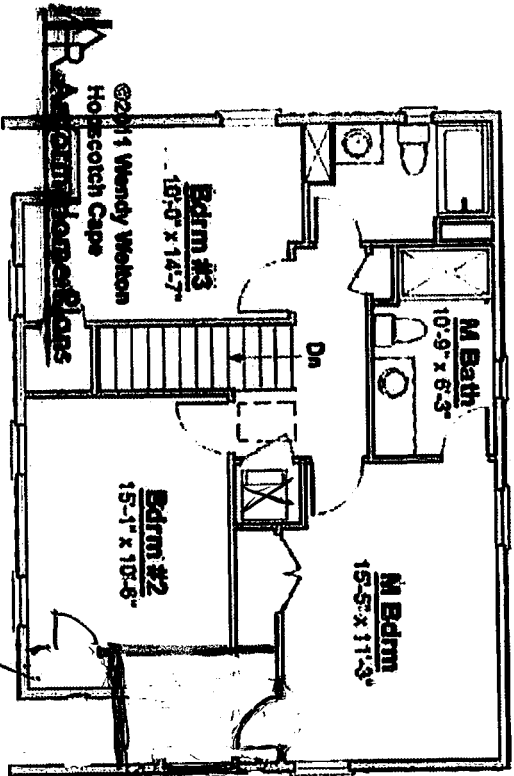

Artform Home Plans

Hopscotch w/Portico

408.003

© 2013 Art Form Architecture, Inc. All Rights Reserved . <http://www.artformhomeplans.com>

Basement Floor

Living Area: 0 SF


Bedrooms: 0

Bathrooms: 0.0

Ceiling Height Shown: 7'-8"

Ceiling Height Possible*: 7'-8"

* - Increasing ceiling height requires a Major Change.

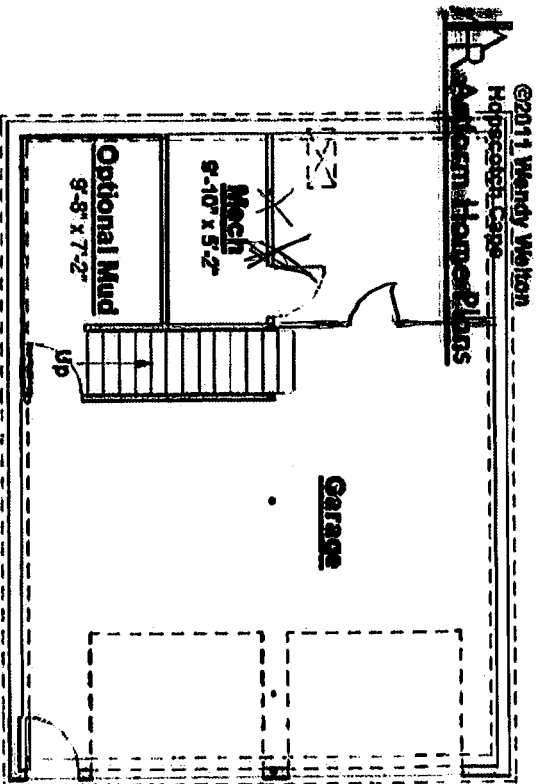

8/11

JS

BS