


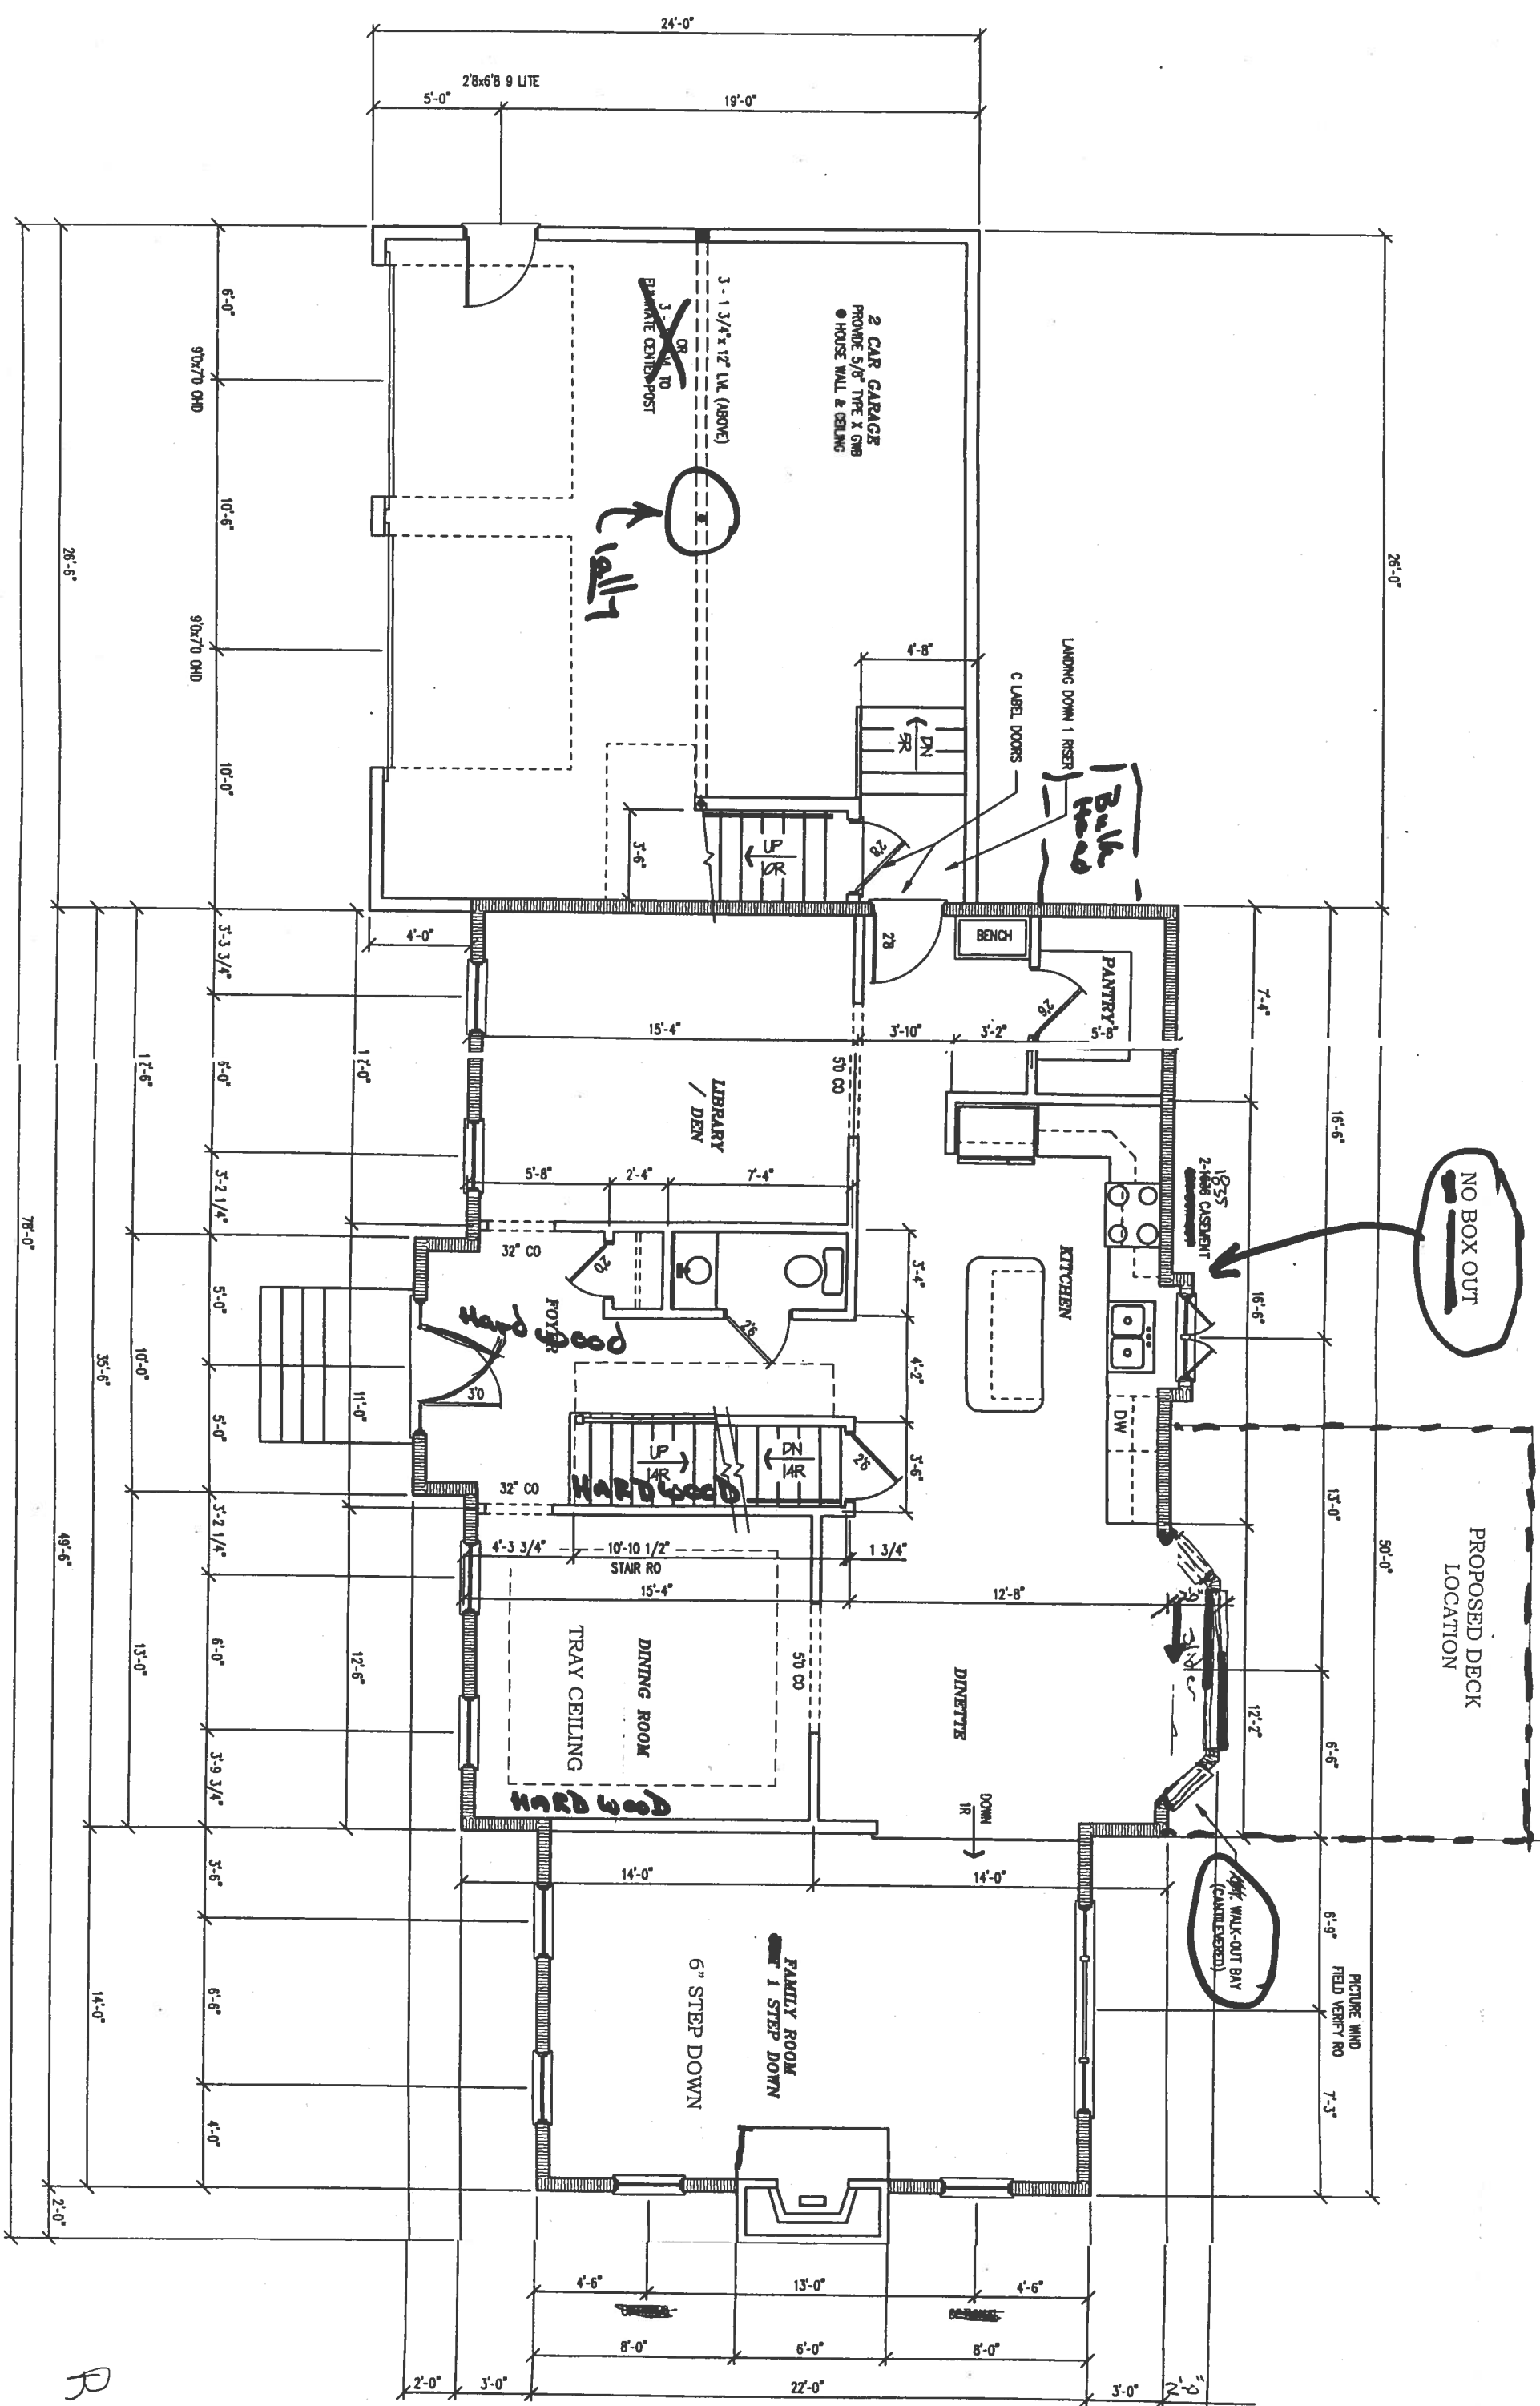

知