




© 2009-2011 Wendy Welton
182 Pesto Cottage

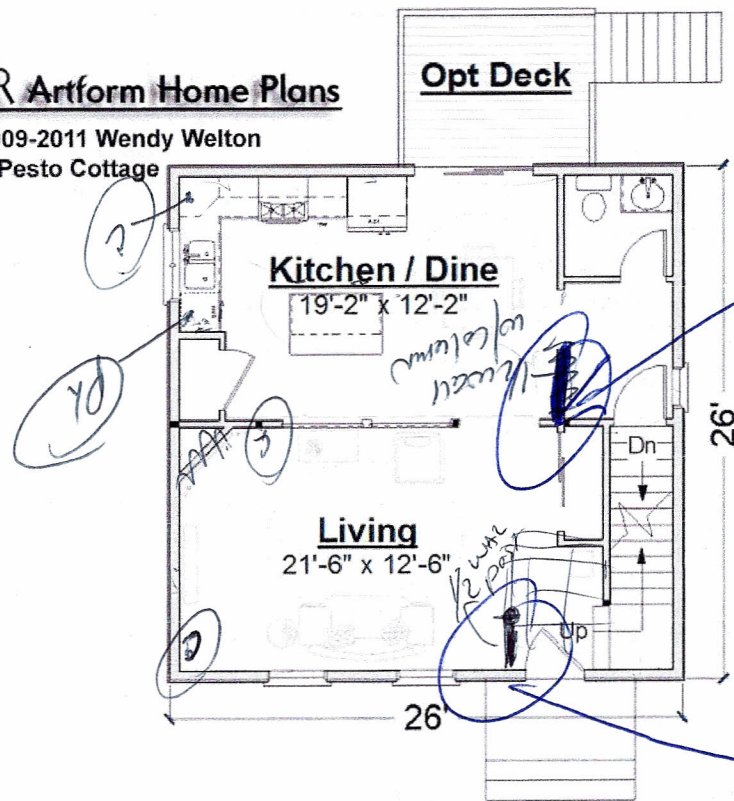


Second Floor Plan

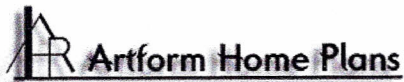

© 2009-2011 Wendy Welton
182 Pesto Cottage

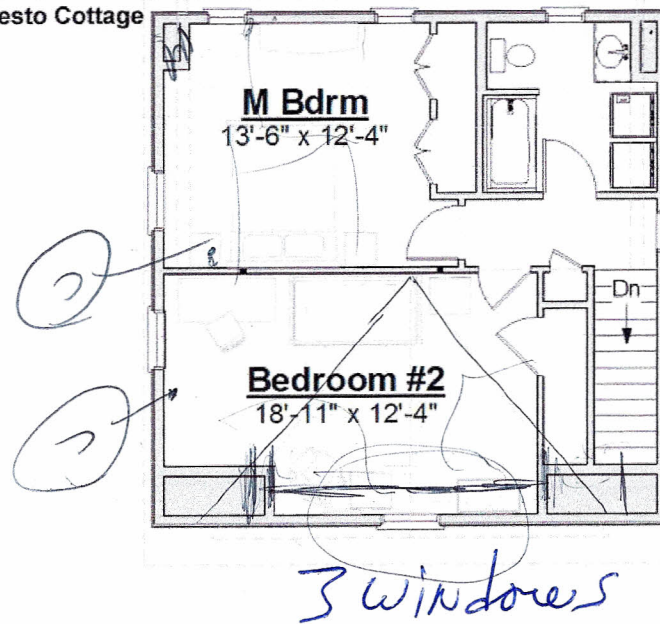


Basement Floor Plan

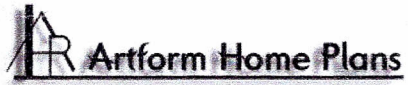


© 2009-2011 Wendy Welton
182 Pesto Cottage


Extend
2'
w/ shed roof

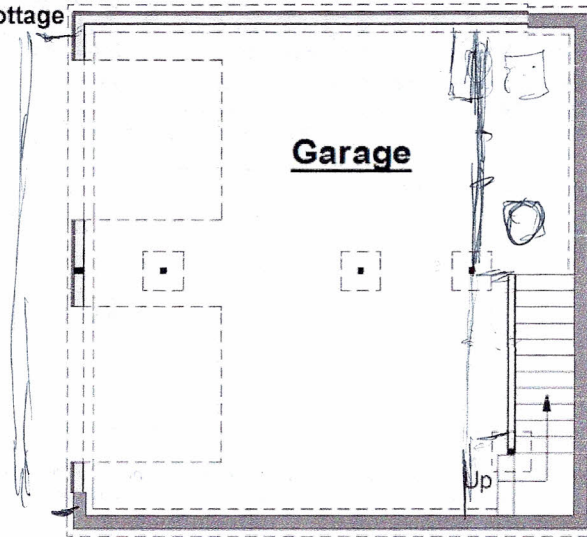

Elevations

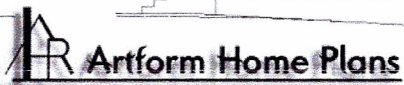

© 2009-2011 Wendy Welton
182 Pesto Cottage

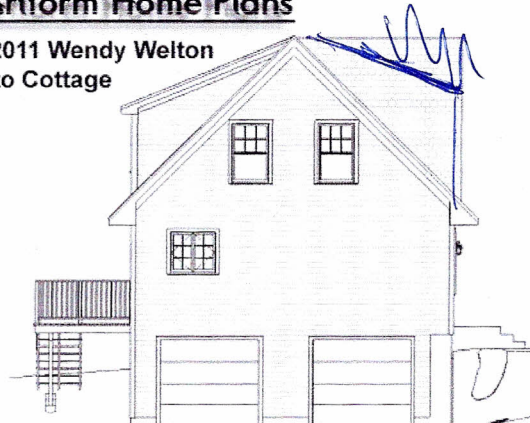

[Terms of Use](#) | [Privacy Policy](#) | [Pay Invoice](#) | [About Us](#) | [Contact Us](#) | [Sitemap](#)

© 2007 - 2012 Art Form Architecture, Inc. All Rights Reserved.

Web design by Artform Home Plans and [Steele Marketing Services](#) and [AlphaBase Solutions, LLC](#) on a framework by [AlphaToGo](#).