

form Home Plans

\* See Major Change information on plan page for cost


175 Rem  
+  
LMAVIA

11

WINDY  
DELETED

Southern Option  
+44k

Andersen Slipping Down  
(p5610)

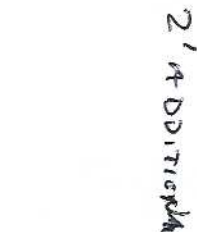

Some features show are optional. Your Purchase & Sale Agreement governs, whether items are labeled "optional" in this document or not.

We are not responsible for typographical errors.

# 426.129.v2 SR Merry Opal Cottage




## Second Floor

	Area	Beds	Baths
Main	913 SF	3	2
Future	246 SF	1	0
Apt	0 SF	0	0
Total	1159 SF	4	2

Ceiling Height
Shown 8'-0"
Possible* 9'-0"

\* See Major Change information on plan page for cost

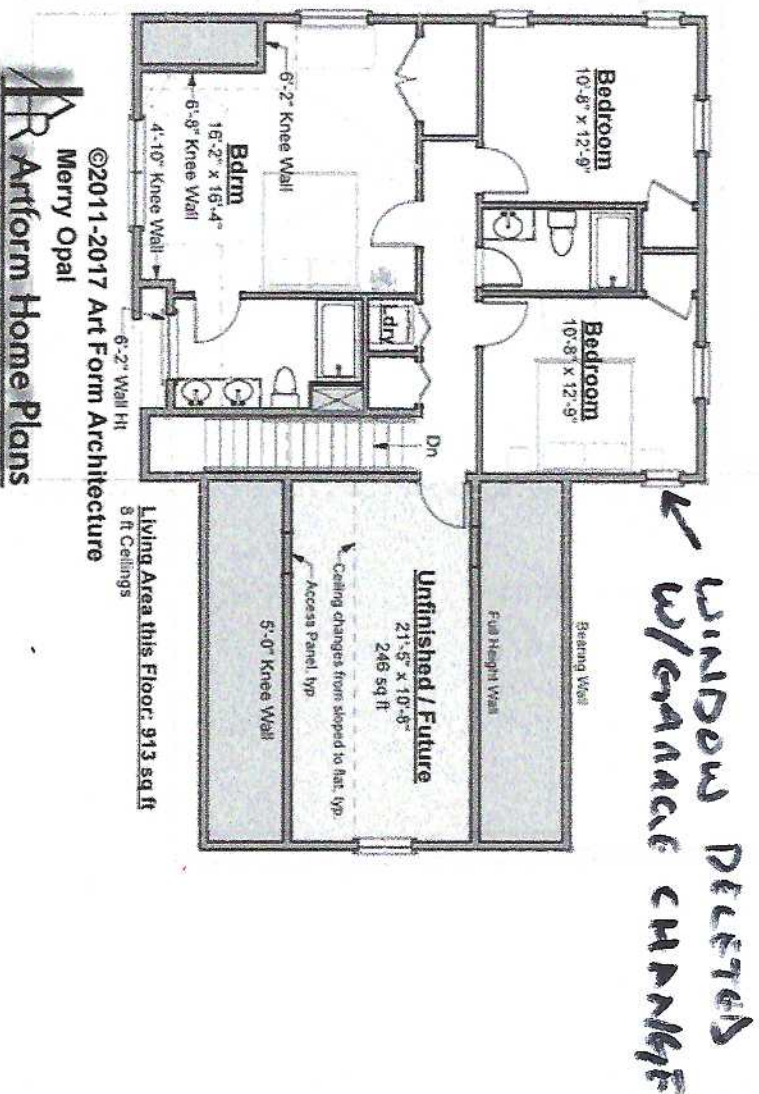

Use of this document is governed by our Terms and Conditions, found on our website: <http://www.artformhomeplans.com/TermsConditions.a5w>

© 2011 Art Form Architecture, Inc. ALL RIGHTS RESERVED. You may not build this Design without purchasing a License to Build (as defined in our Terms). Unauthorized changes are not permitted and violate copyright laws, which provide substantial penalties for infringement.

Some features show are optional. Your Purchase & Sale Agreement governs, whether items are labeled "optional" in this document or not. We are not responsible for typographical errors.