


Gilligan

398.001

© 2013 Art Form Architecture, Inc. All Rights Reserved . <http://www.artformhomeplans.com>

Elevations



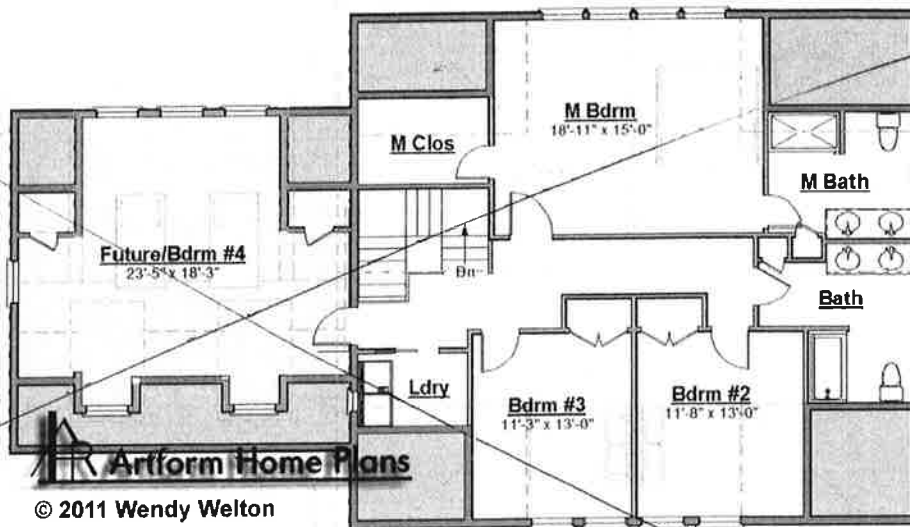


Second Floor

Floor Plan

\$?

CB

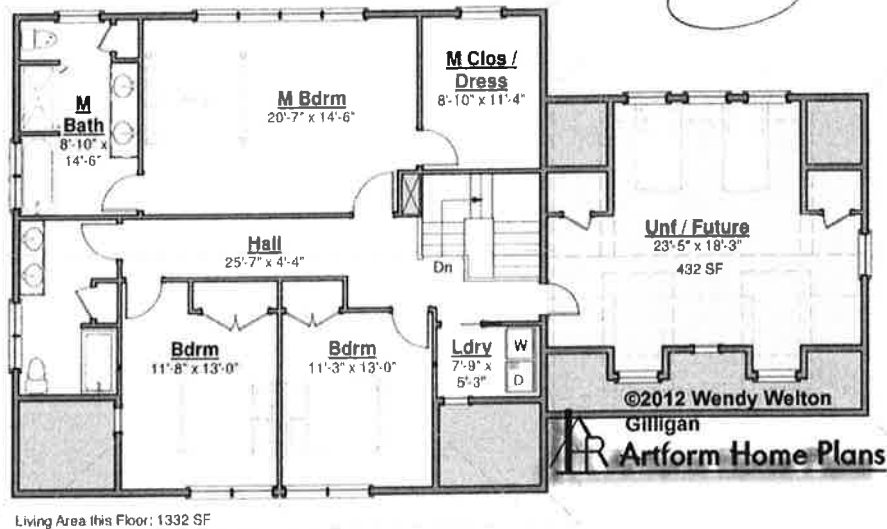


Living Area this Floor: 1332 SF

Basement


Floor Plan

Reversed plan on lot

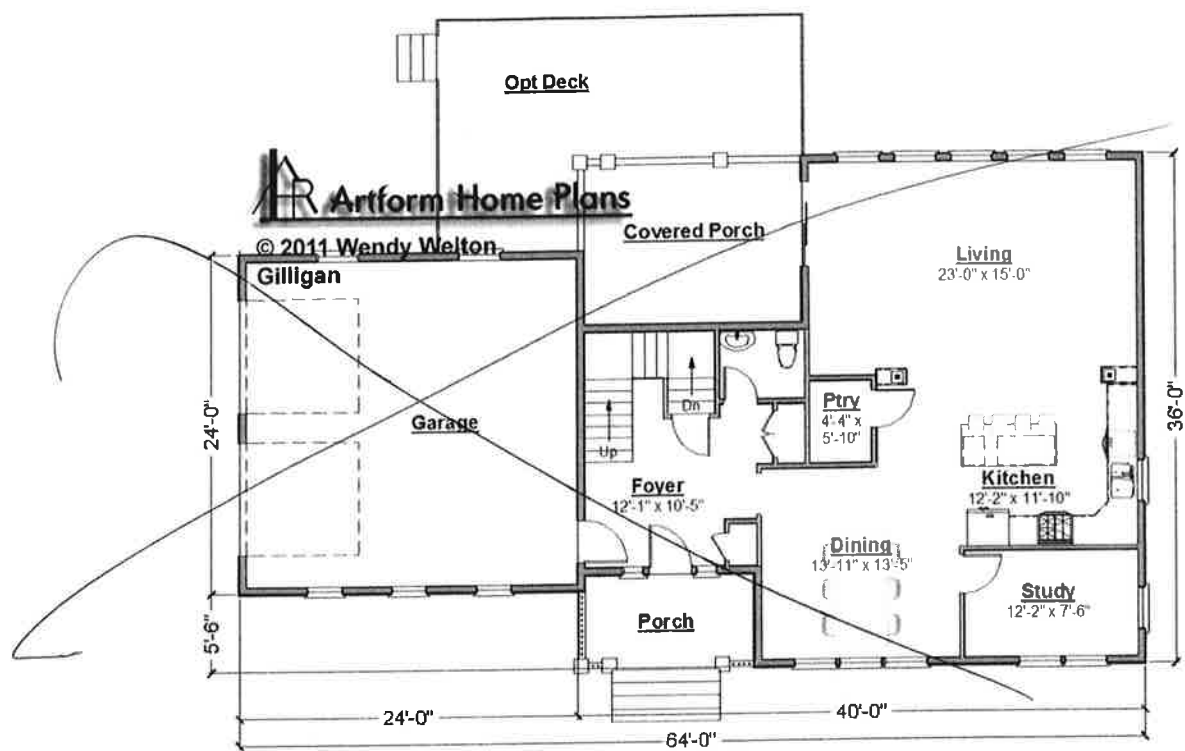

First Floor

Floor Plan

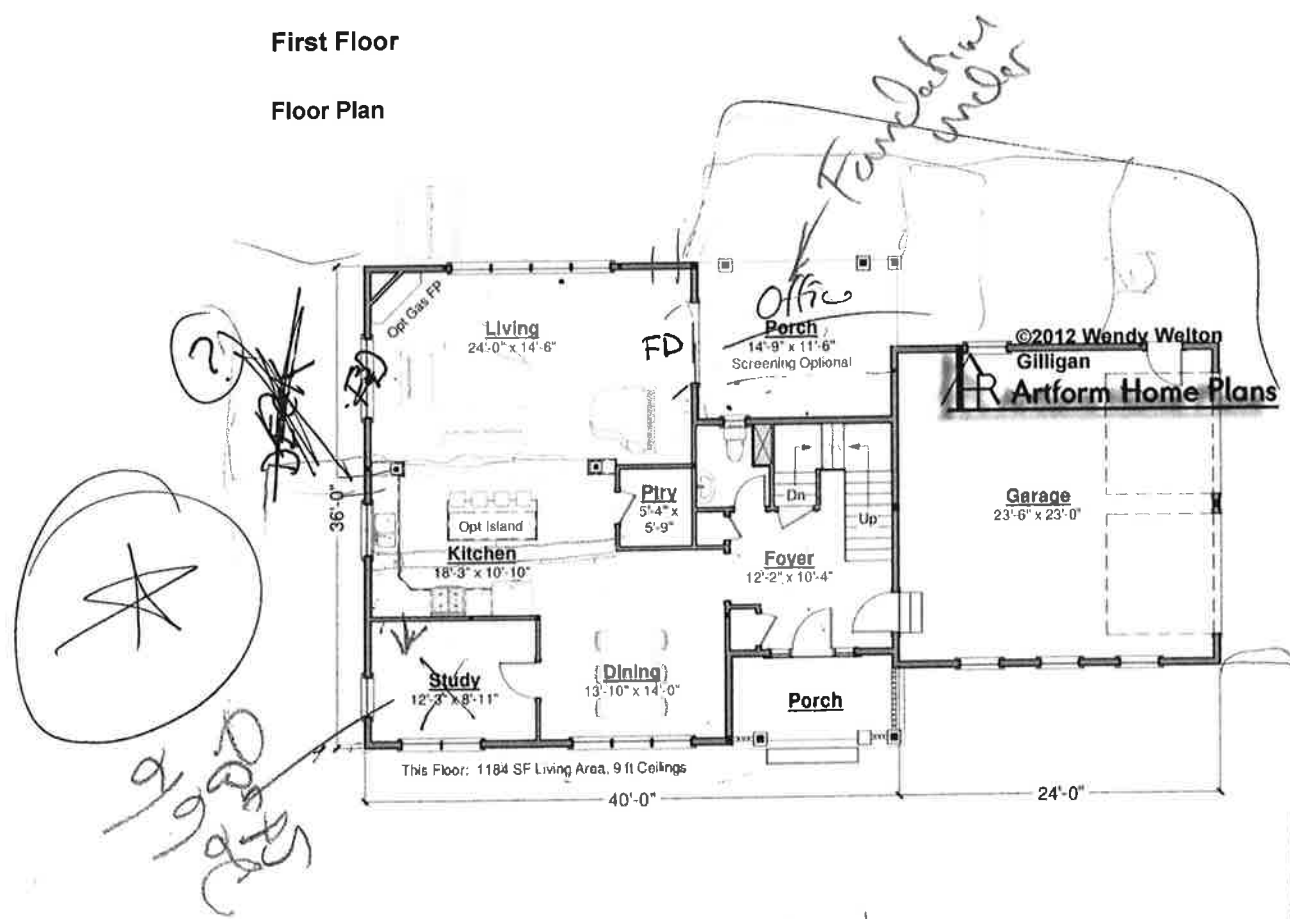

Second Floor

Floor Plan

