


Sapphire, Classic w/Wing

130.127

© 2013 Art Form Architecture, Inc. All Rights Reserved . <http://www.artformhomeplans.com>

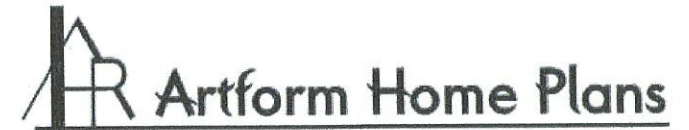

First Floor

Living Area: 1224 SF

Bedrooms: 1

Bathrooms: 1.5

Ceiling Height Shown: 8'-0"


Ceiling Height Possible*: 9'-0"

* -- Increasing ceiling height requires a Major Change.

This first floor applies to all the Artform Signature Bungalows, Classic with Wing configuration, Symmetrical (like the Robin, Sea Apple, etc.) In the Asymmetrical designs, the only change is at the porch columns.

See predesigned changes for pantry, 9 ft ceiling and other options.

130.127 Sapphire 130

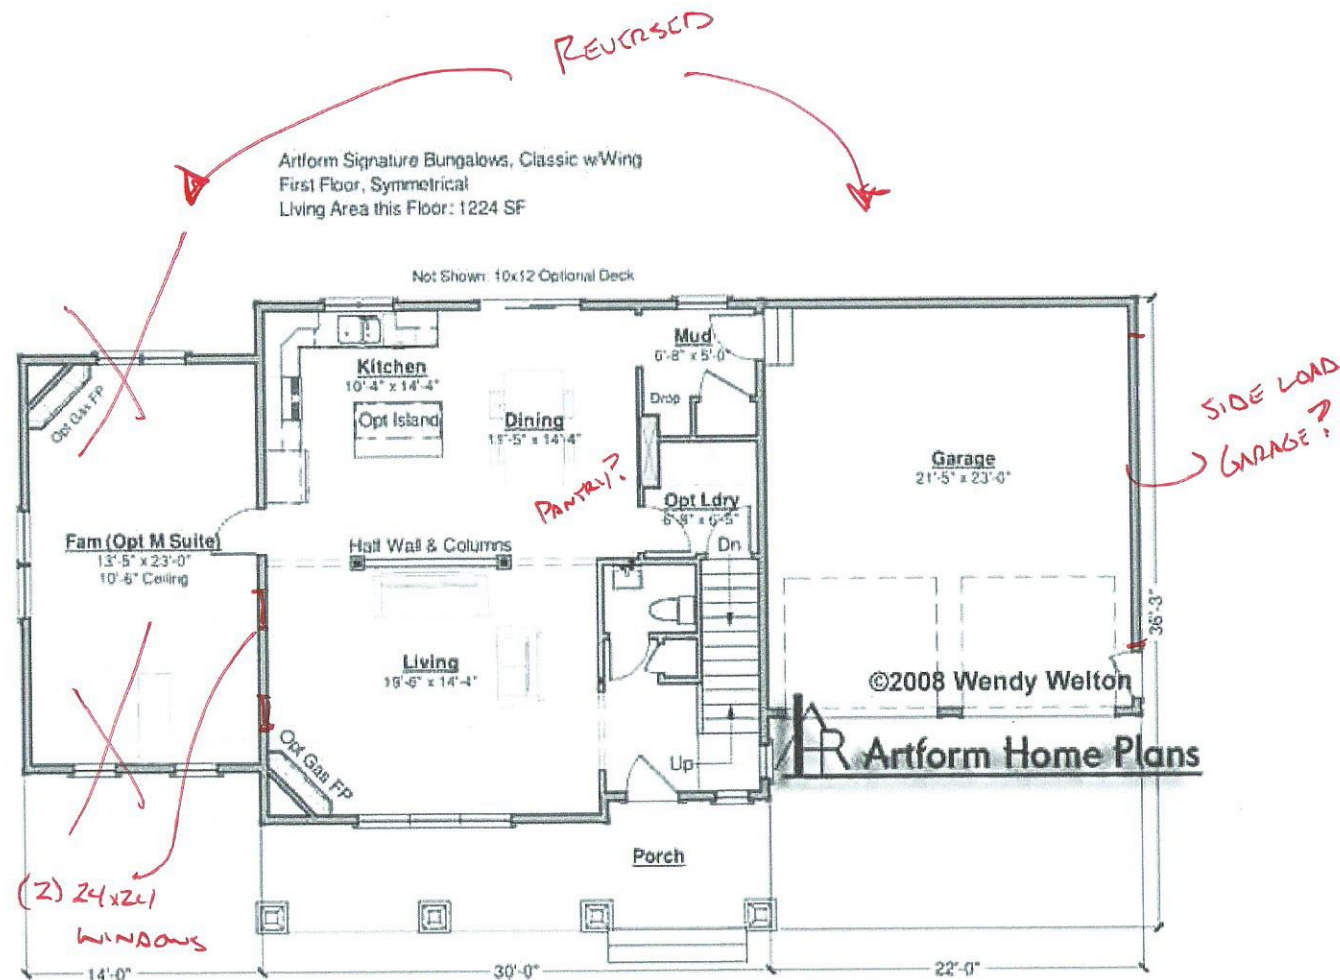

Sapphire, Classic w/Wing

130.127

© 2013 Art Form Architecture, Inc. All Rights Reserved . <http://www.artformhomeplans.com>

Second Floor

Living Area: 1285 SF

Bedrooms: 4

Bathrooms: 2.0

Ceiling Height Shown: 8'-0"

Ceiling Height Possible*: 8'-0"

* -- Increasing ceiling height requires a Major Change.

Second floor plans for other symmetrical Artform Signature Bungalows will be similar - like the Robin

See predesigned changes for master bath with separate tub and shower, and other options.

 Artform Home Plans

130.127 Sapphire - 2nd

Sapphire 130.127 Classic w/Wing
Second Floor
Living Area this Floor: 986 SF

