



Saffrone Compote

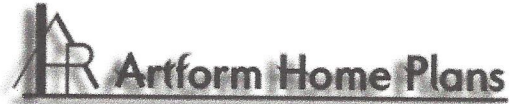

© 2008-2011 Wendy Welton

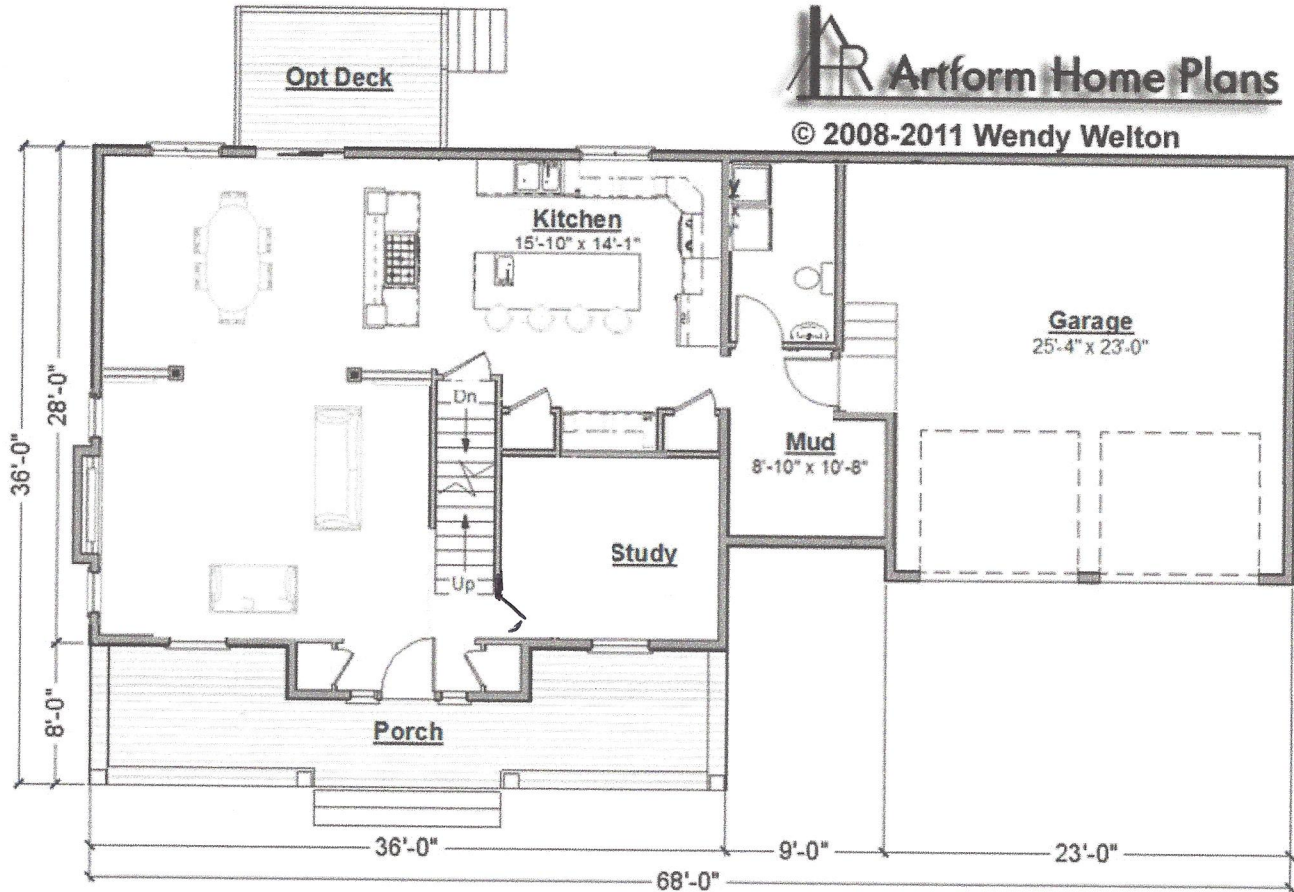

"Saffrone Compote" Stair placement

Connector: "Crème de la Saffrone"

Question:

- Orientation of house? Sun light etc
- Possible beam increase to cover span and Kitchen Study wall

428.124 Creme de la Saffron

Some features shown are optional. Your contract with your builder governs.

Second Floor

Living Area: 1516 SF

Beds: 5

Baths: 2.0

Ceiling Height Shown: 8'-0"


Ceiling Height Possible*: 8'-0"

* -- See Major Changes on pricing tab of plan page for cost.



© 2008-2011 Wendy Welton

Creme de la Saffron

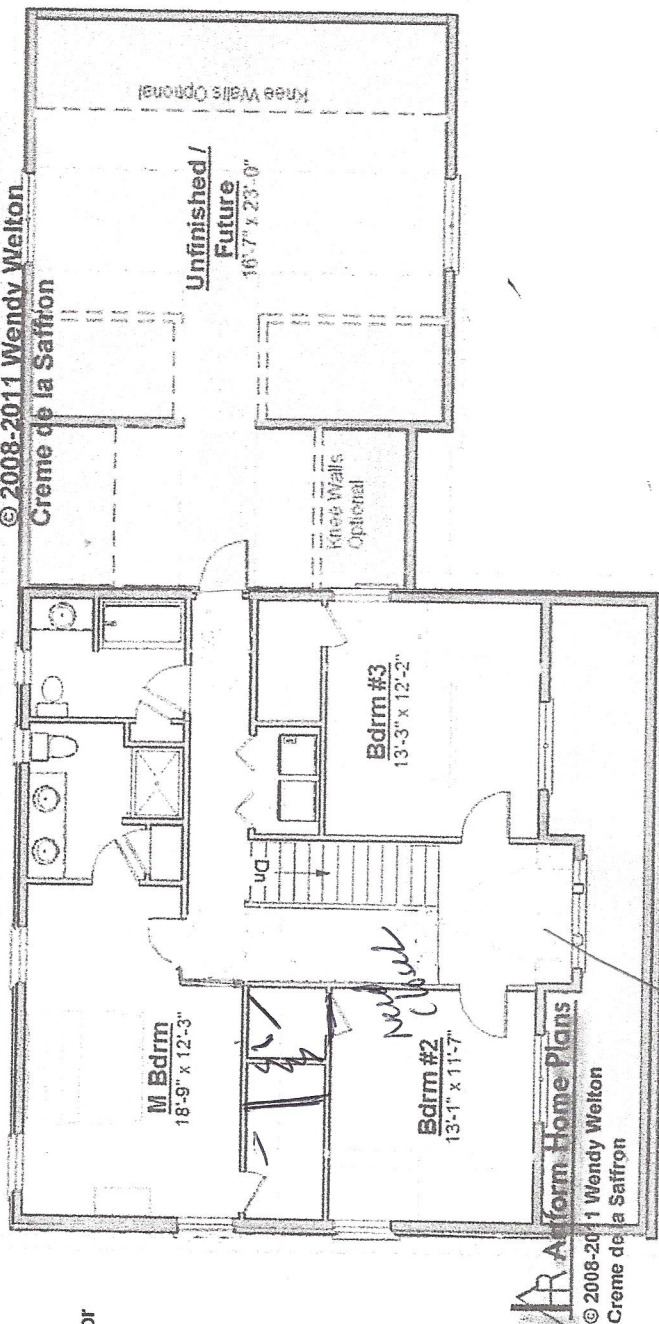

Entry into bedrooms my
change because of front
bump