


MLL
08/18/21
2:39 PM EDT
dotloop verified

Tayberry Crisp
936.144.v5 GR
(5/12/2021)

© 2018-2021 Art Form Architecture, Inc., all rights reserved. You may not build this design without purchasing a license, even if you make changes. This design may have geographic restrictions.

Artform Home Plans
603-431-9559

MLL
08/19/21
11:52 AM EDT
dotloop verified

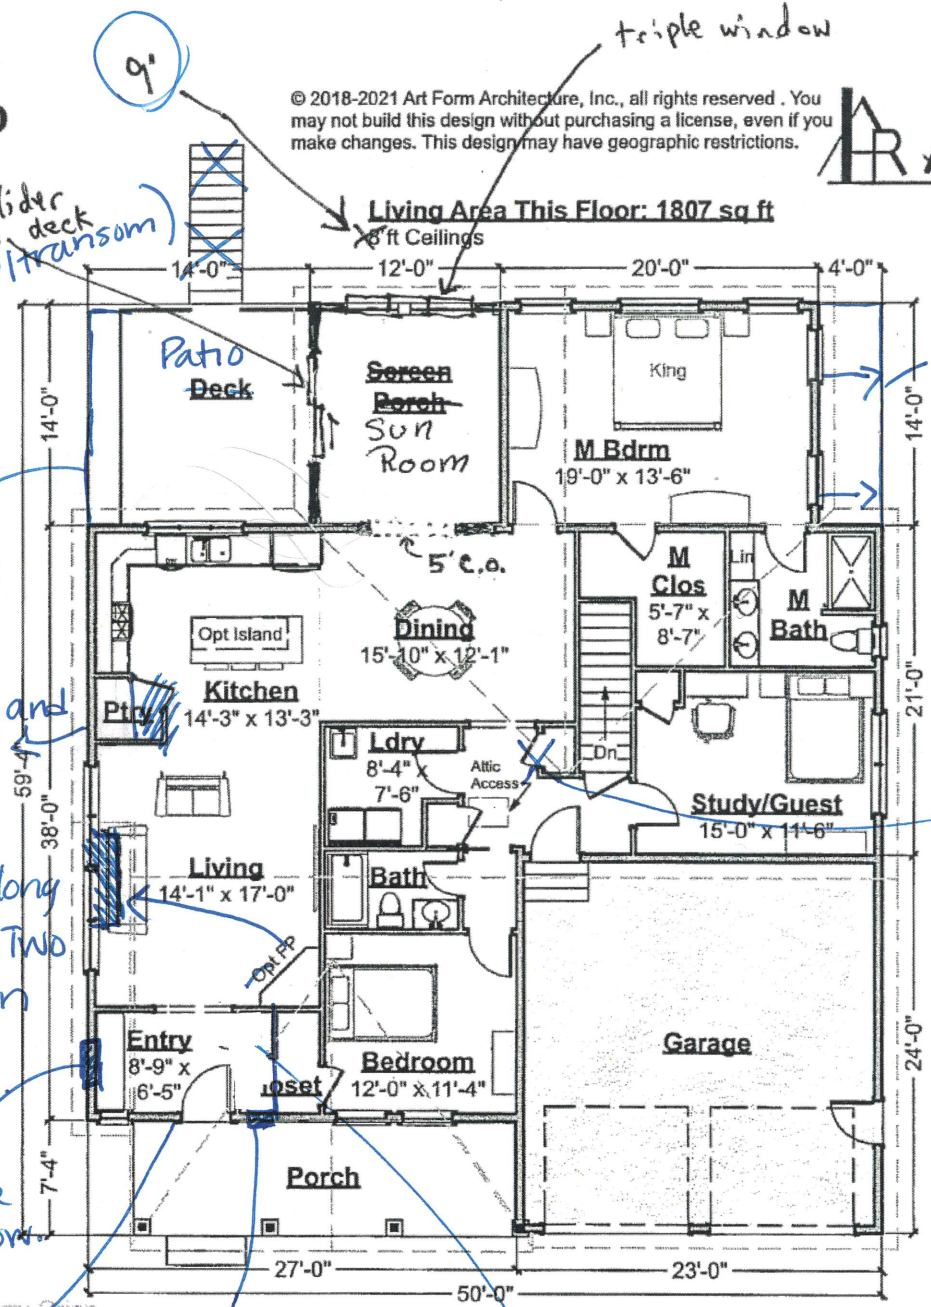

1. Craftsman-style front porch pillars.
2. Top window grids only
3. Slider-no grids.
4. Kitchen window- no grids.
5. No walk-out basement

First Floor Plan
Scale: 3/32" = 1'-0"

GRS 936.144.v5 GR Tayberry Crisp