

Raspberry Crisp


565.144.v60 GR (5/10/2021)

© 2013-2021 Art Form Architecture, Inc., all rights reserved. You may not build this design without purchasing a license, even if you make changes. This design may have geographic restrictions.



603-431-9559

Living Area This Floor: 1952 sq ft

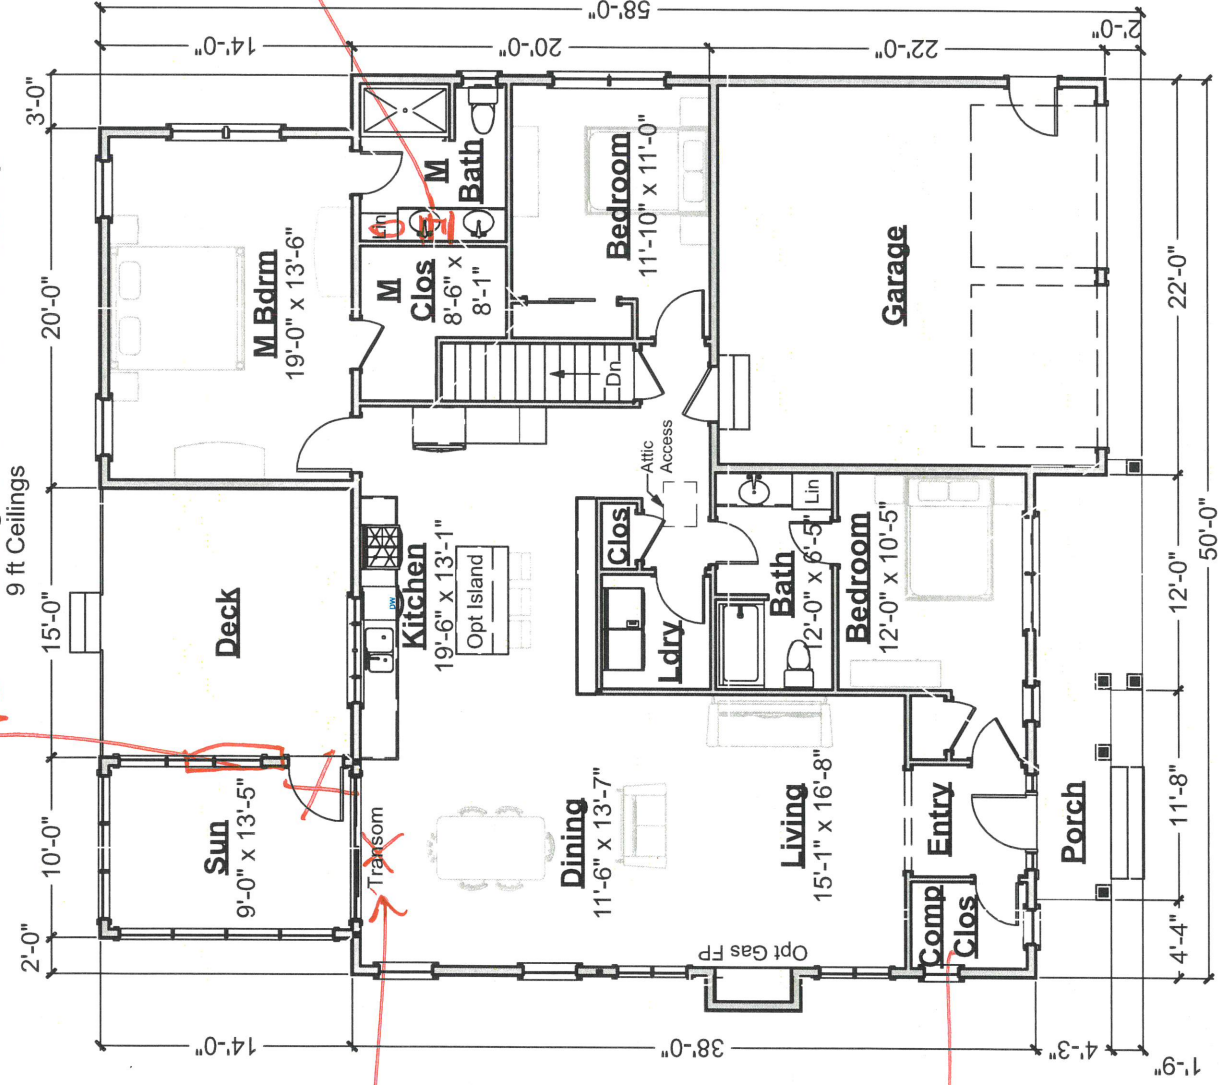

First Floor Plan

Scale: 3/32" = 1'-0"

Unit 10 SGP

Living Area

Raspberry Crisp


565.144.v60 GR (5/10/2021)

© 2013-2021 Art Form Architecture, Inc., all rights reserved. You may not build this design without purchasing a license, even if you make changes. This design may have geographic restrictions.



603-431-9559

*oriental egress
TBP.*

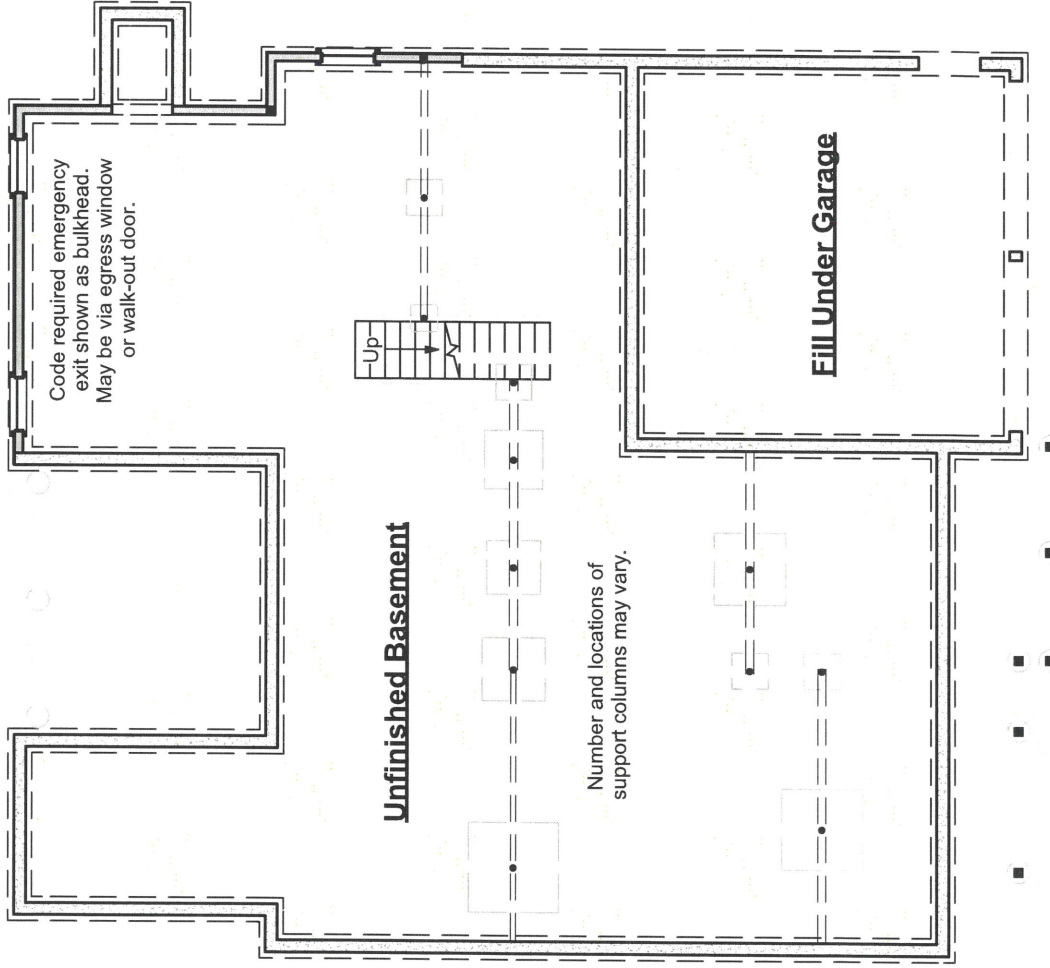

Foundation Plan

Scale: 3/32" = 1'-0"