


Vanilla Torte

tbd

© 2013 Wendy Welton, all rights reserved.
this design without purchasing a license.
changes. This design may have

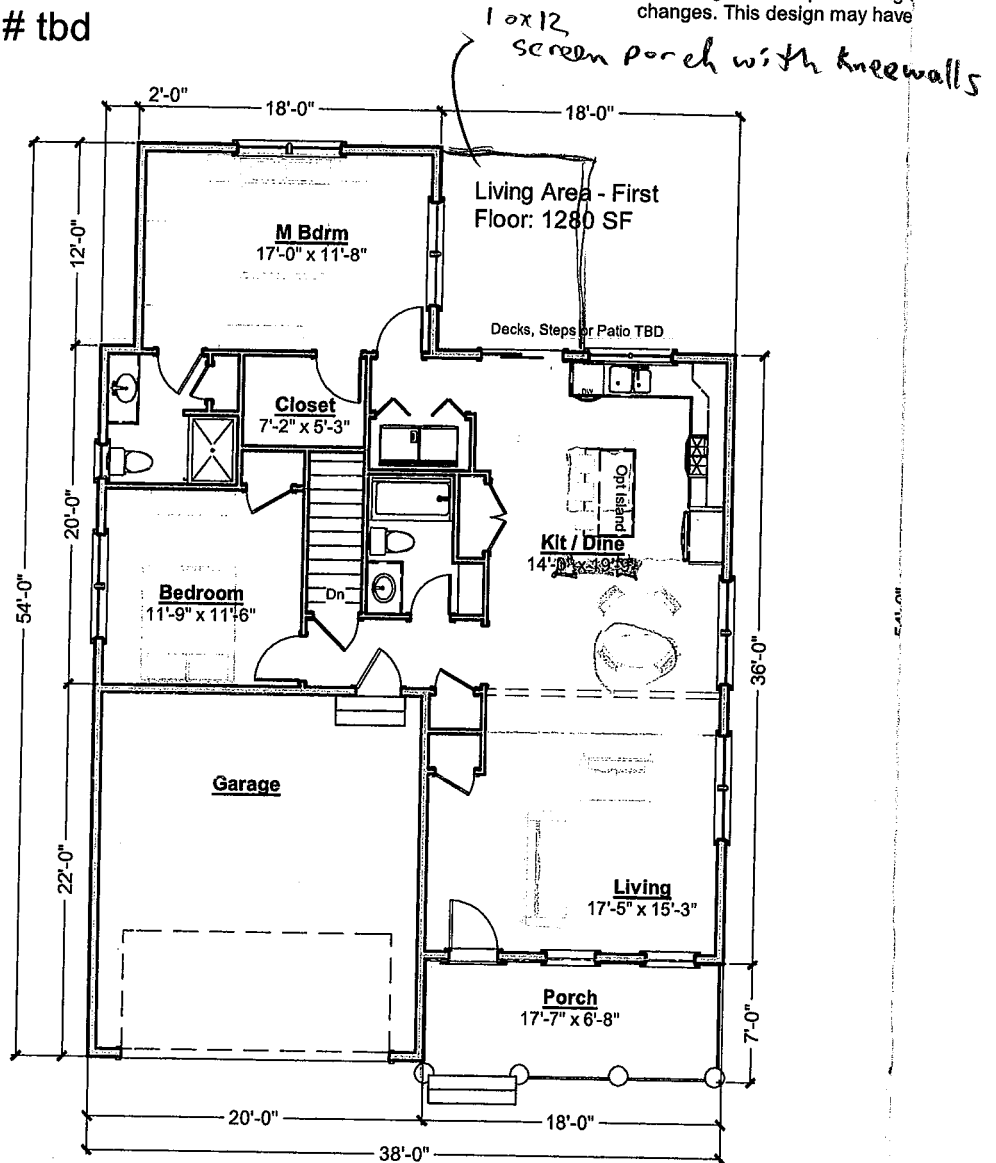

Narrower Lot

mirror
garage on right