

12/7/2020

Sir Zach


845.124.v8 GR (12/7/2020)

© 2016-2020 Art Form Architecture, Inc., all rights reserved. You may not build this design without purchasing a license, even if you make changes. This design may have geographic restrictions.



603-431-9559

1. Garage Left
2. Window grids: Top only
3. Slider: Grids

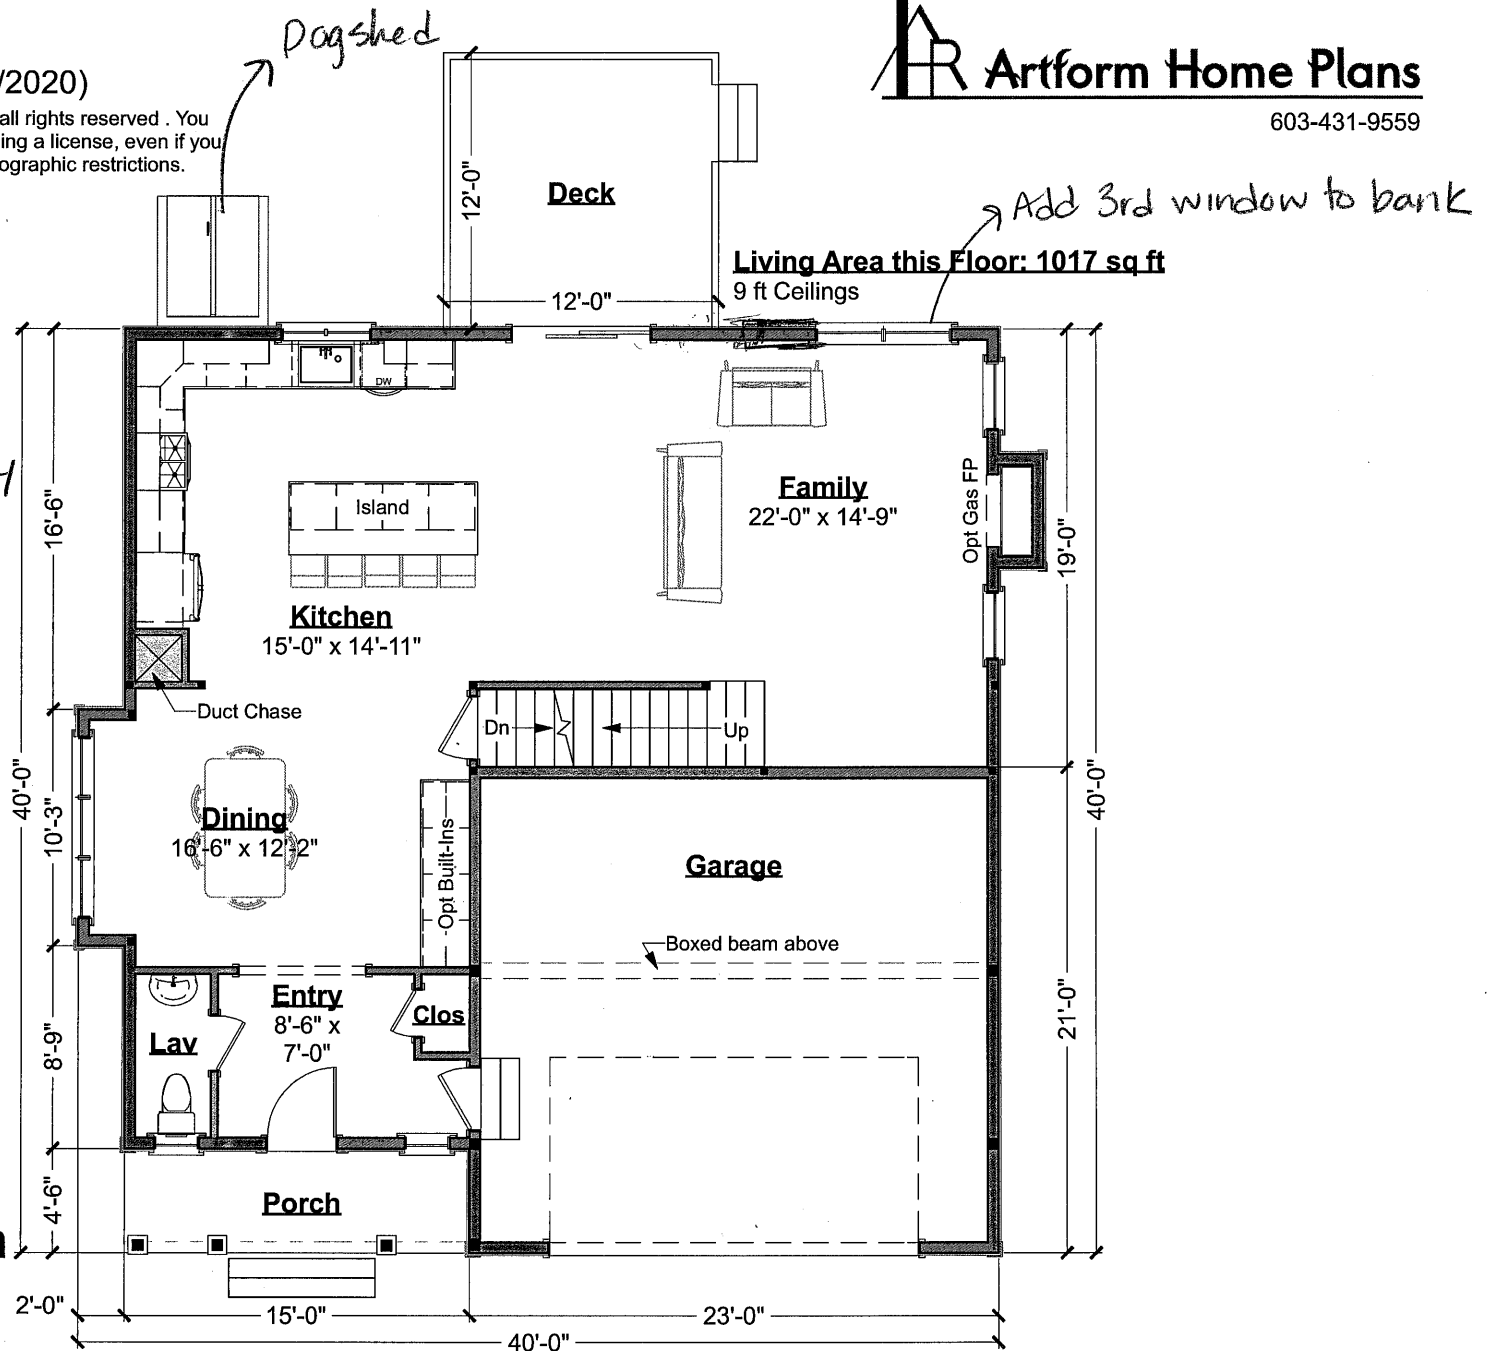

First Floor Plan

Scale: 1/8" = 1'-0"

12/7/2020


Sir Zach

845.124.v8 GR (12/7/2020)

© 2016-2020 Art Form Architecture, Inc., all rights reserved . You may not build this design without purchasing a license, even if you make changes. This design may have geographic restrictions.

603-431-9559

Living Area this Floor: 1372 sq ft
8 ft Ceilings

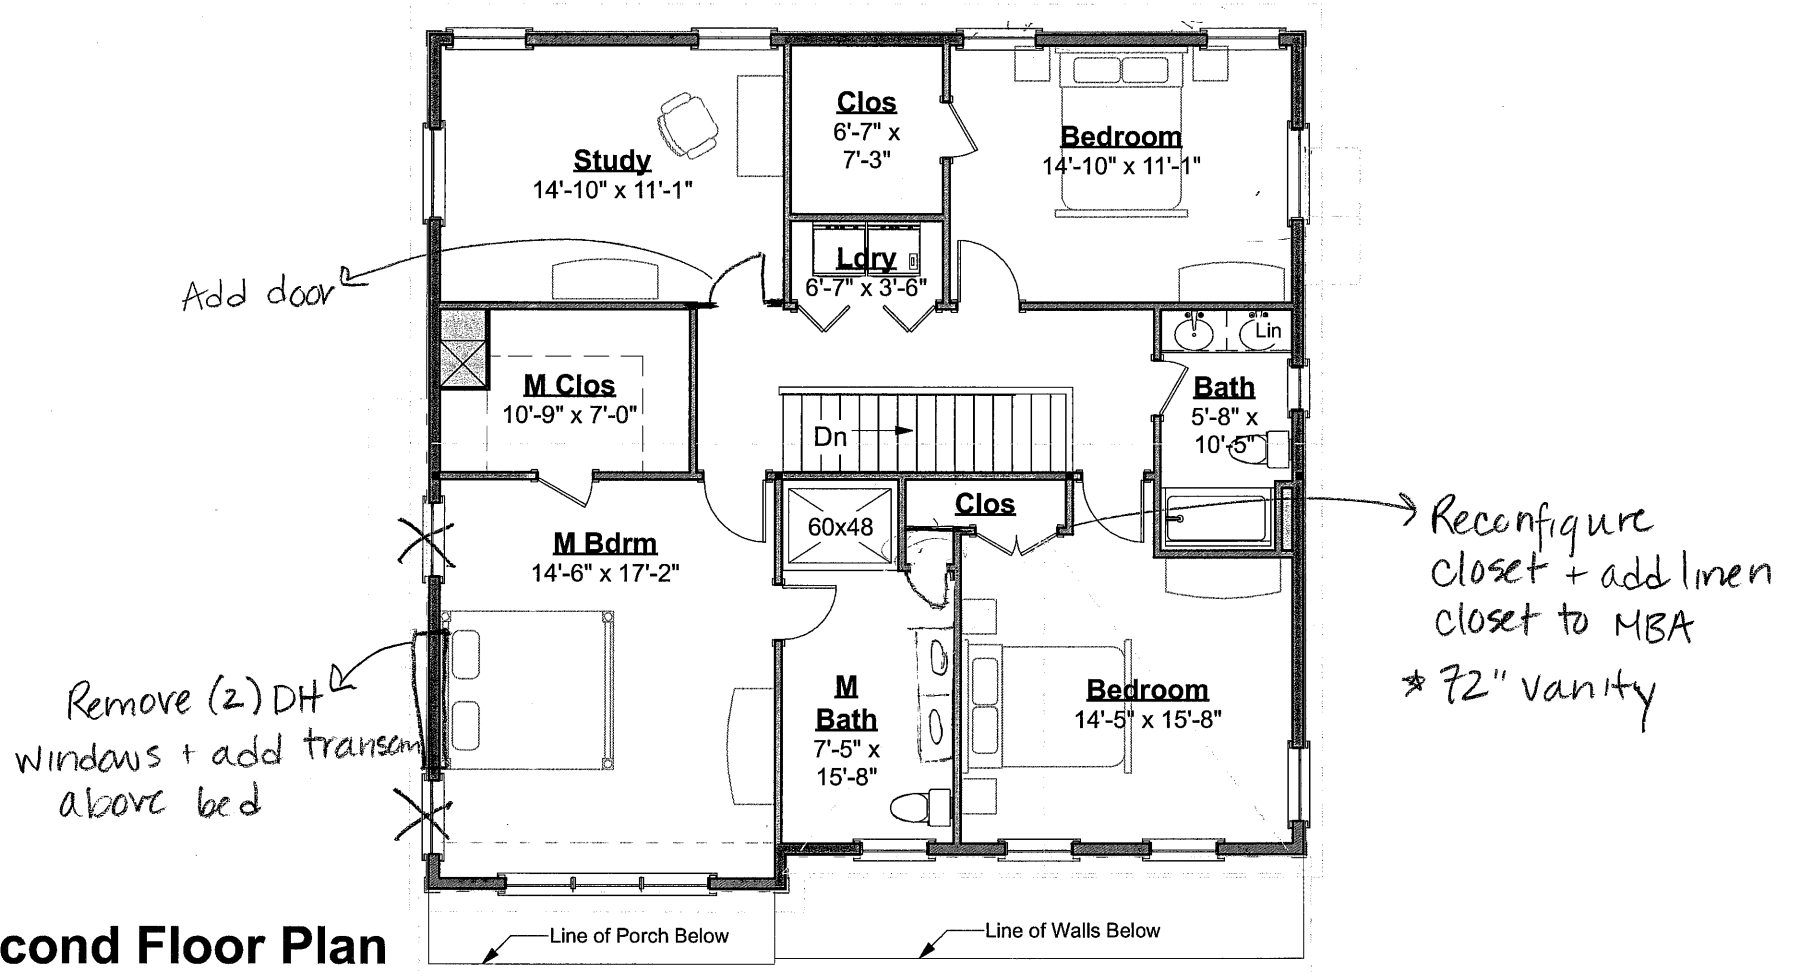

Second Floor Plan

Scale: 1/8" = 1'-0"